SF-1 VENTILATION SYSTEM

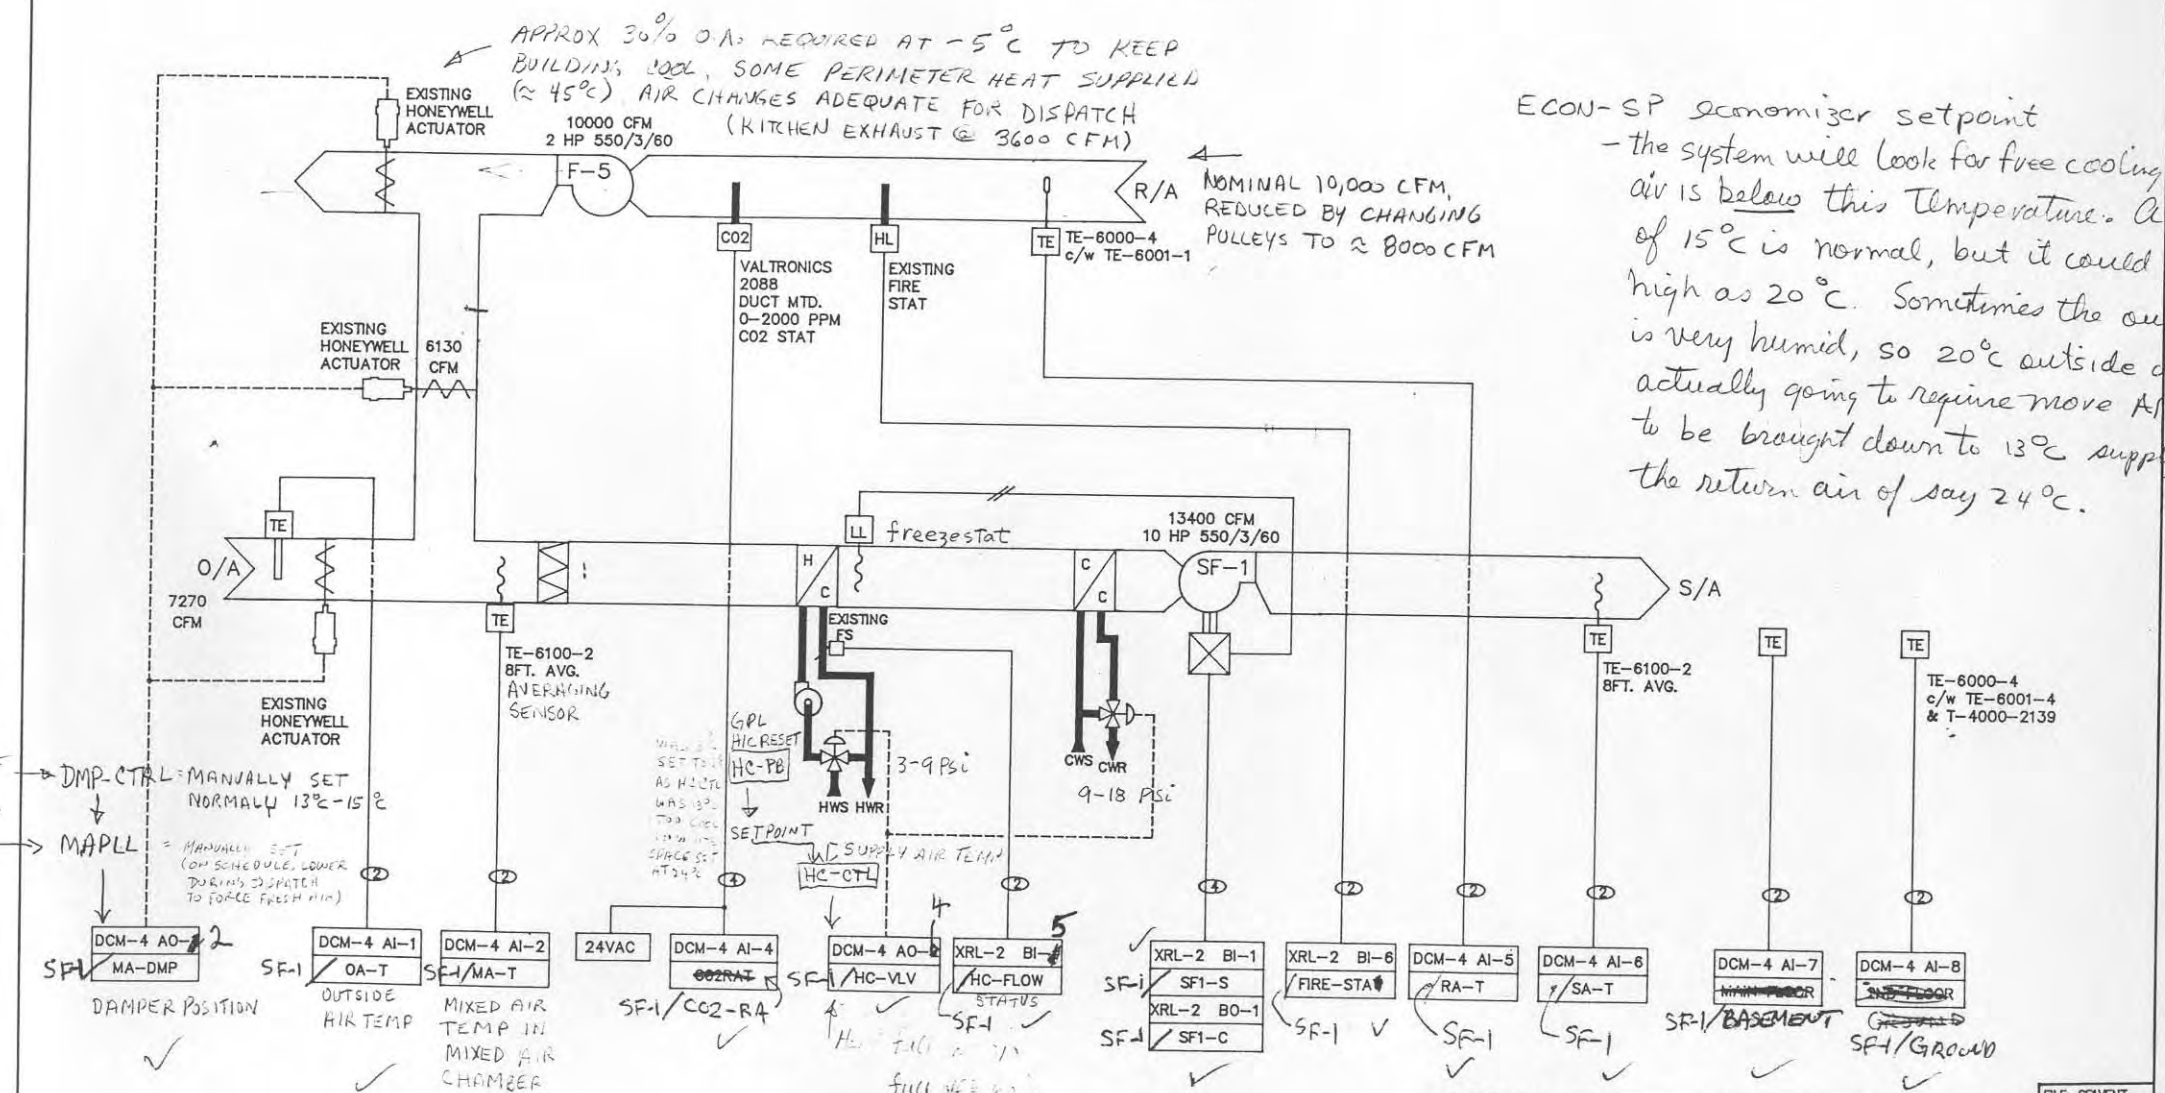

ECON-SP economizer setpoint
- the system will look for free cooling if o
air is below this Temperature. A setp
of 15°C is normal, but it could go a
high as 20°C. Sometimes the outside
is very humid, so 20°C outside air i
actually going to require more A/C coo
to be brought down to 13°C supply th
the return air of say 24°C.

COPYRIGHT JOHNSON CONTROLS, INC. 1991

DRAWING TITLE: SF-1 VENTILATION SYSTEM					FILE: SF1VENT
	1	AS BUILT			04/10/92 CV
REFERENCE DRAWING NO.		REVISION-LOCATION		ECN	DATE BY
SALES ENGR: BH	PROJECT MGR: RC	APPL. ENGR: RC	DRAWN: BY CV DATE 08/25/91	APPROVED: DATE	
PROJECT: WINNIPEG TRANSIT ADMINISTRATION AND G SECTION METASYS FACILITY MANAGEMENT SYSTEM	JOHNSON CONTROLS Systems & Services Division	JOHNSON CONTROLS LTD 800 MORAY STREET WINNIPEG, MANITOBA R3J 3Y3 204-885-8360	CONTRACT NUMBER: 91098-5006	DRAWING NUMBER: 1501-37	