


*not yet done with door, relay use for timer*

*two gas valve*

*relayed*

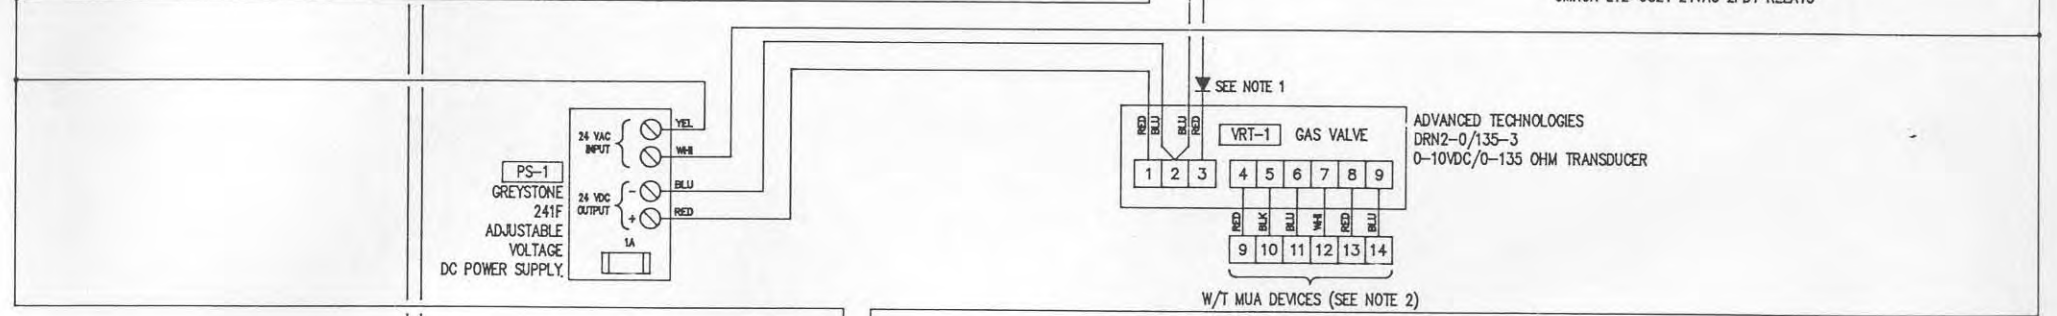

- NOTES:
- 1) ANALOG OUTPUT DAMPING DIODE
  - 2) SEE Dwg.1501-46B & 46C FOR MUA TERMINATIONS

DRAWING TITLE FT. ROUGE G SECTION MUA-2, 3 & 5 CONTROL PANEL WIRING DETAIL		FILE: FTRGM235	
PROJECT WINNIEPEG TRANSIT ADMINISTRATION AND G SECTION METASTAS FACILITY MANAGEMENT SYSTEM	CONTRACT NUMBER 91098-5006	DRAWING NUMBER 1501-45B	
JOHNSON CONTROLS Systems & Services Division 204-866-8360		JOHNSON CONTROLS LTD 800 MORAY STREET WINNIEPEG, MANITOBA R3M 3Y9 204-866-8360	
DATE 01/15/92	BY RC	DATE 01/17/92	BY RC
NO. 1	REVISION-LOCATION	EGN	DATE 1/17
SALES ENGR PROJECT MAN APPR ENGR	DRAWN	APPROVED	