
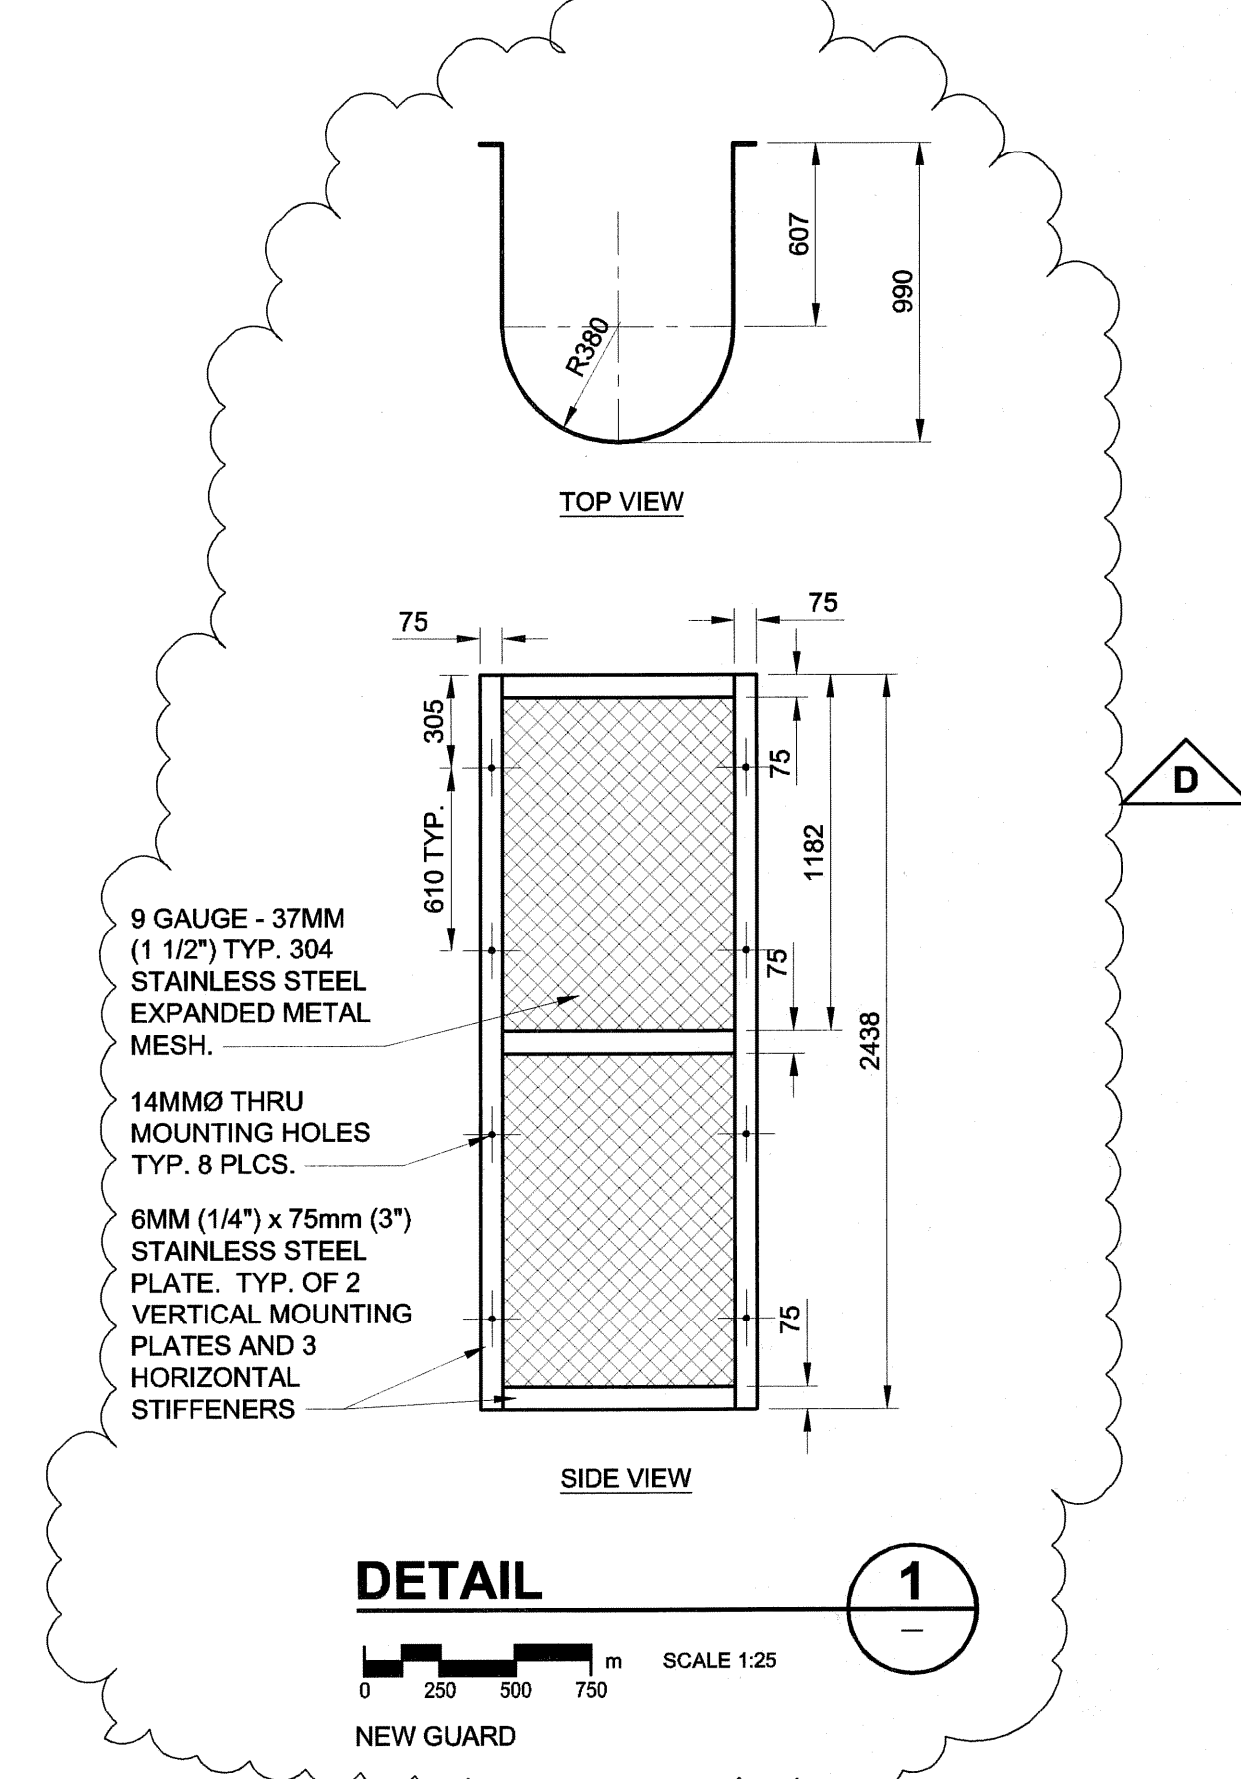
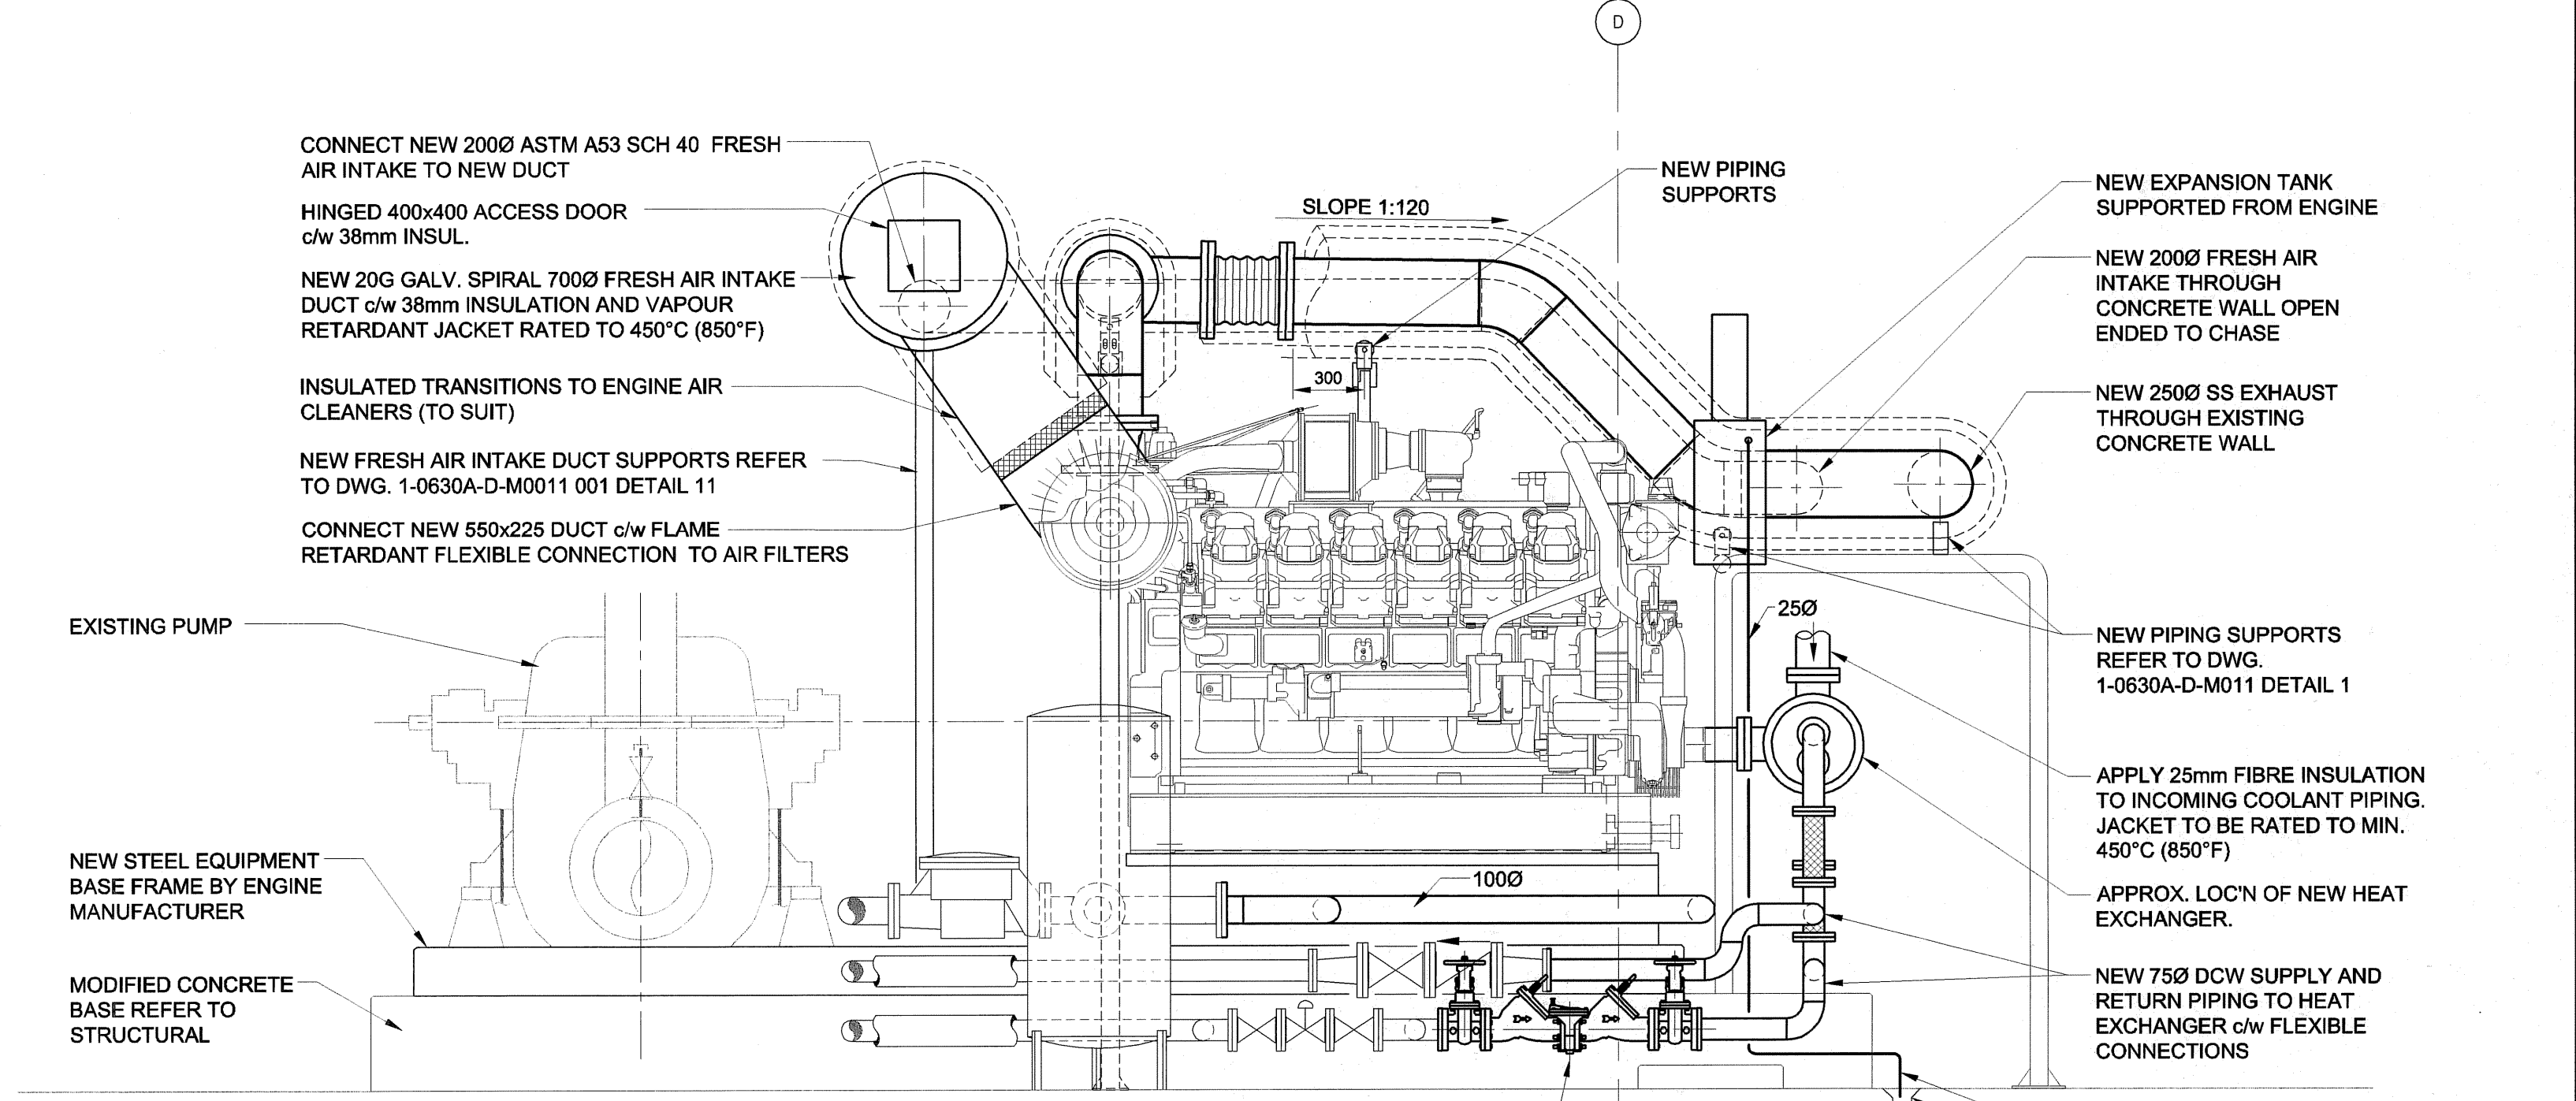


D SIZE 22" x 34" (559mm x 864mm)

PLOT: 07/08/21 4:56:59 PM

UMA FILE NAME: D265-199-00_01-M-0008_RX.dwg Saved By: astone

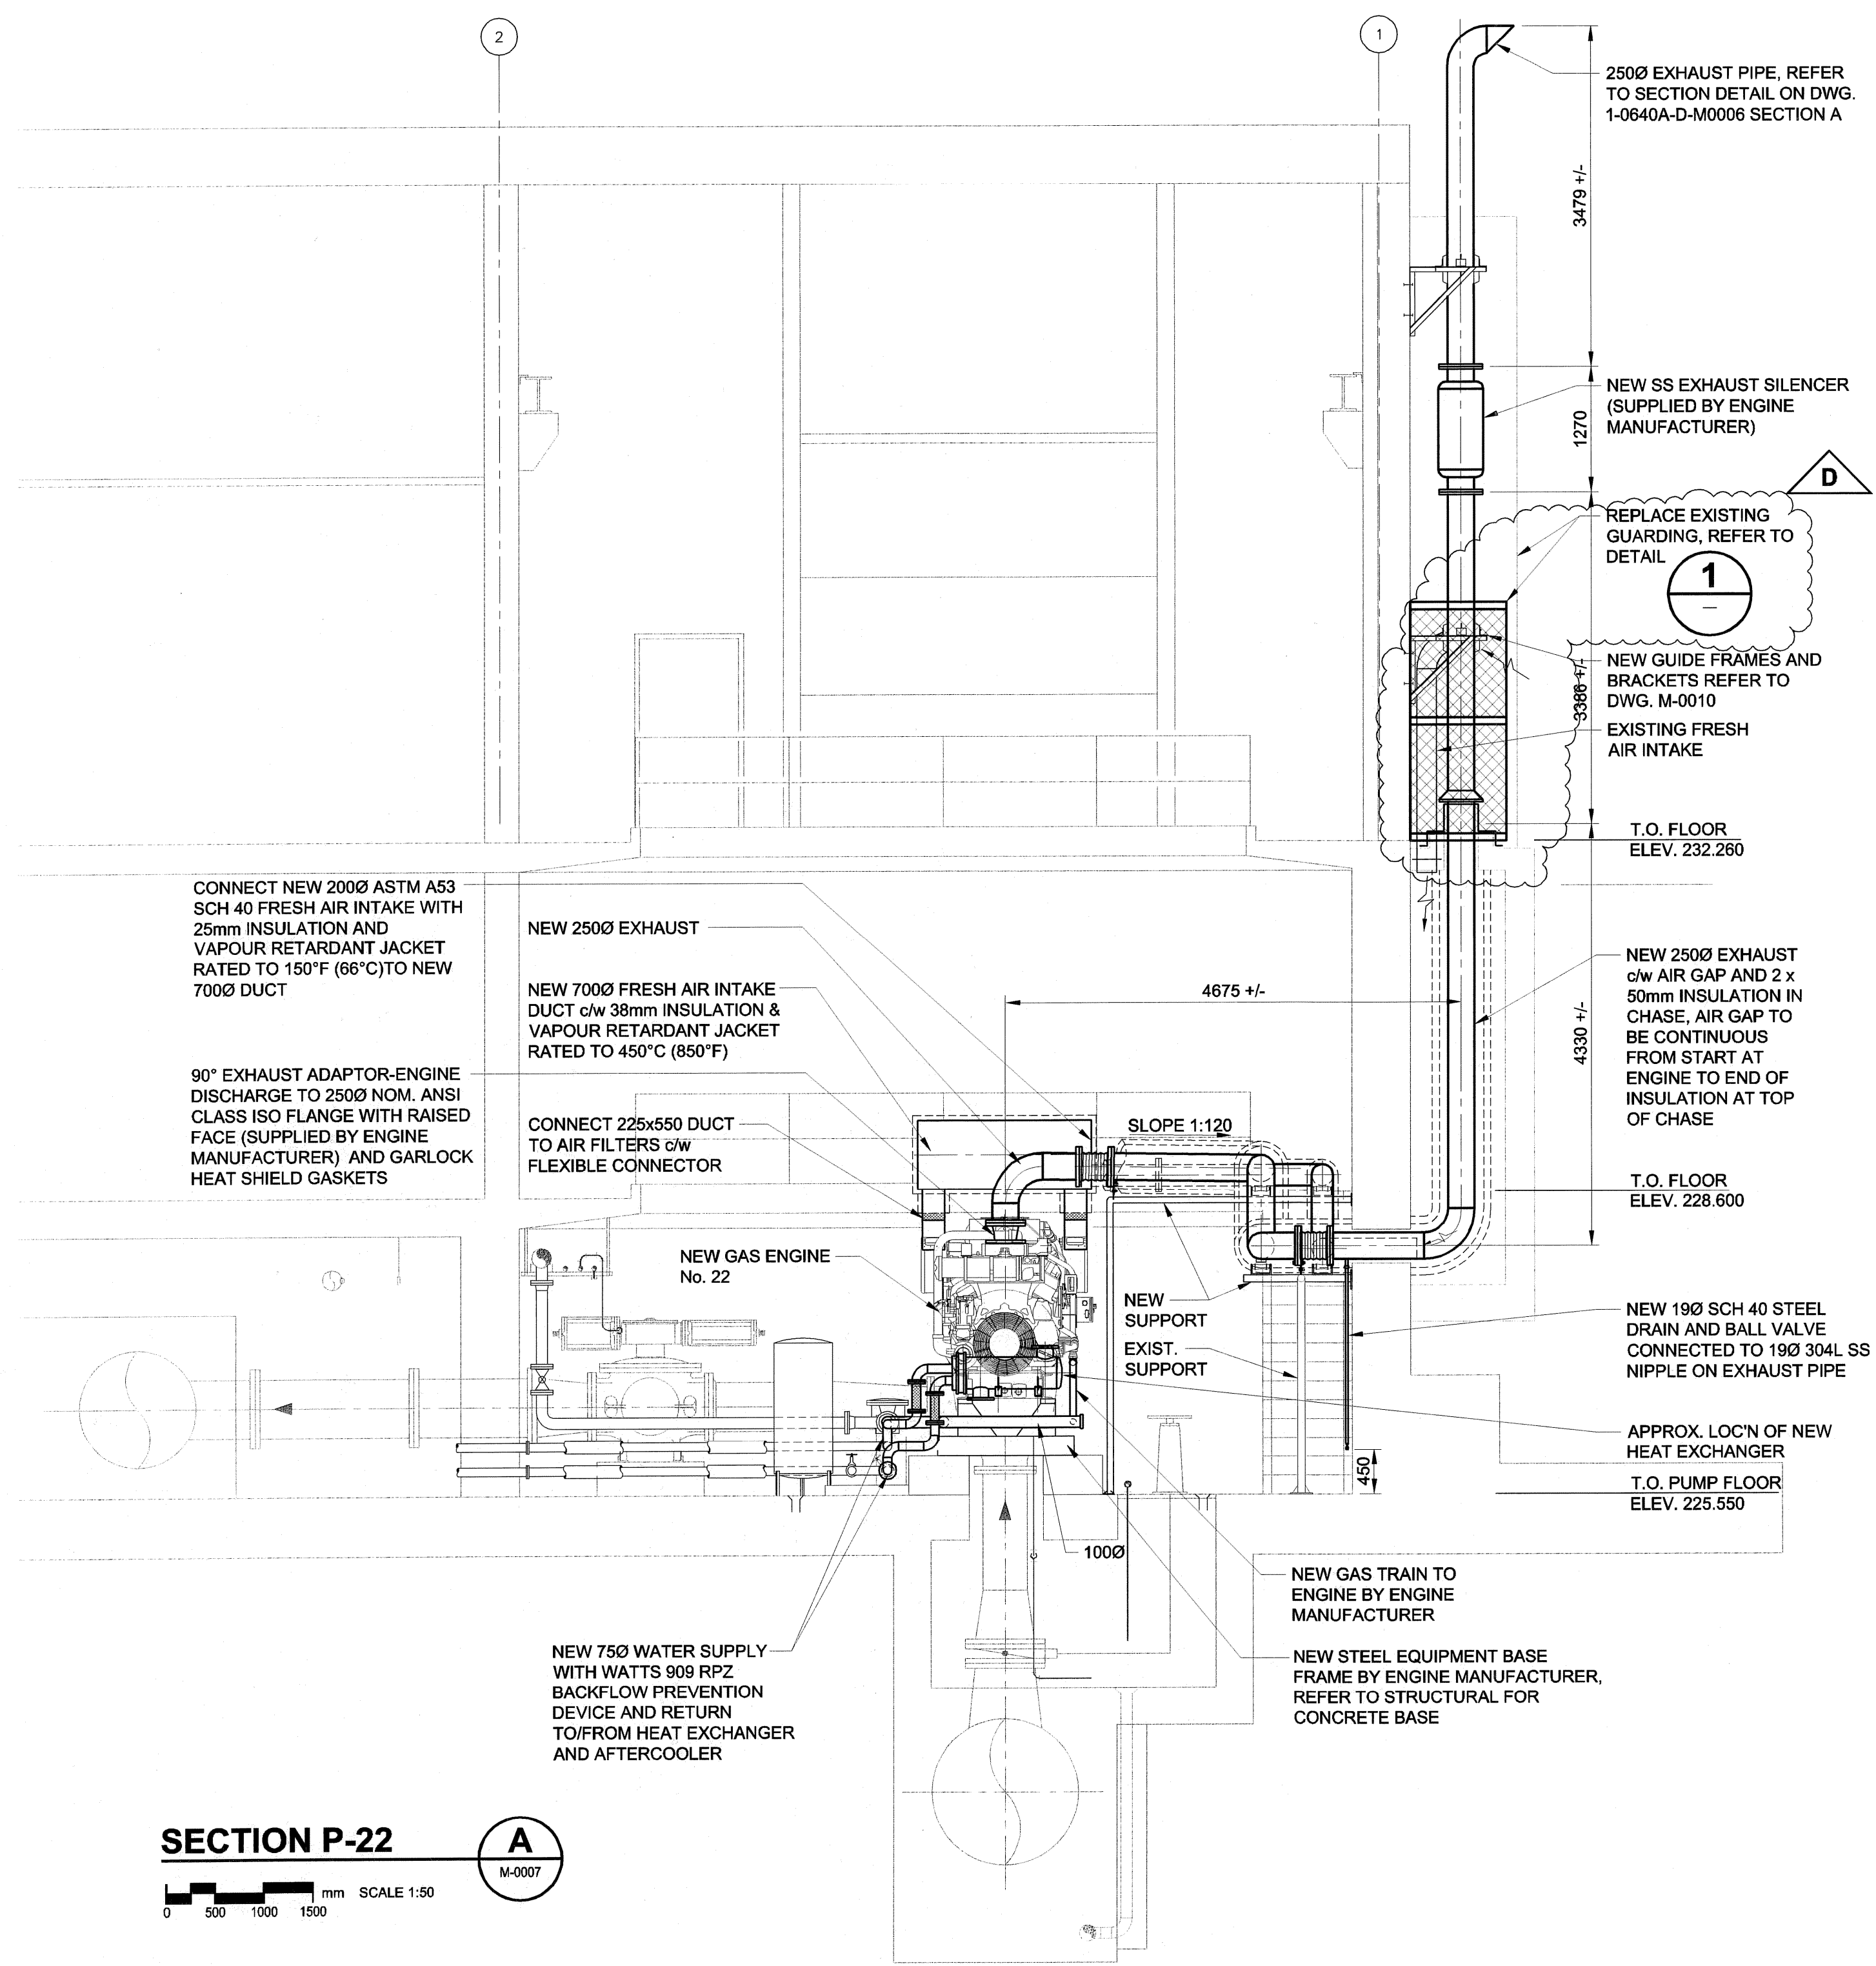

NOTE:

AC	DR	CH	CK	DES	ENG	DR
UMA	AECOM	REVIEW				

B.M. ELEV.	FIELD BOOK #:	UMA AECOM		ENGINEER'S SEAL
POSTED TO LBIS		© 2006 UMA ENGINEERING LTD. ALL RIGHTS RESERVED.		
		DESIGNED BY: CAC	CHECKED BY: ---	
		DRAWN BY: RJP	APPROVED BY: -	
D ISSUED FOR ADDENDUM	07/08/16	ALS	HOR. SCALE AS NOTED	
C ISSUED FOR BID	07/06/15	RJP	VERTICAL AS NOTED	
B ISSUED FOR 99% REVIEW	07/05/04	RJP	RELEASED FOR CONSTRUCTION	
A ISSUED FOR 75% REVIEW	07/03/15	RJP	DATE 07/03/09	
NO. REVISIONS	DATE	BY	FILENAME: D265-199-00_01-M-0008_RX.dwg	

THE CITY OF WINNIPEG
WATER AND WASTE DEPARTMENT

G. C. MACLEAN PUMPING STATION
Contract No.
Natural Gas Engine Drives Replacement
Mechanical - New Construction
ENGINE 22 REPLACEMENT - SECTIONS

CITY DRAWING NUMBER: 1-0630A-D-M0008 001 D D