
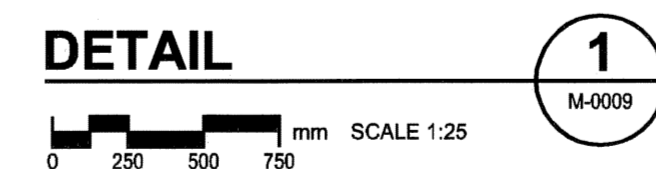
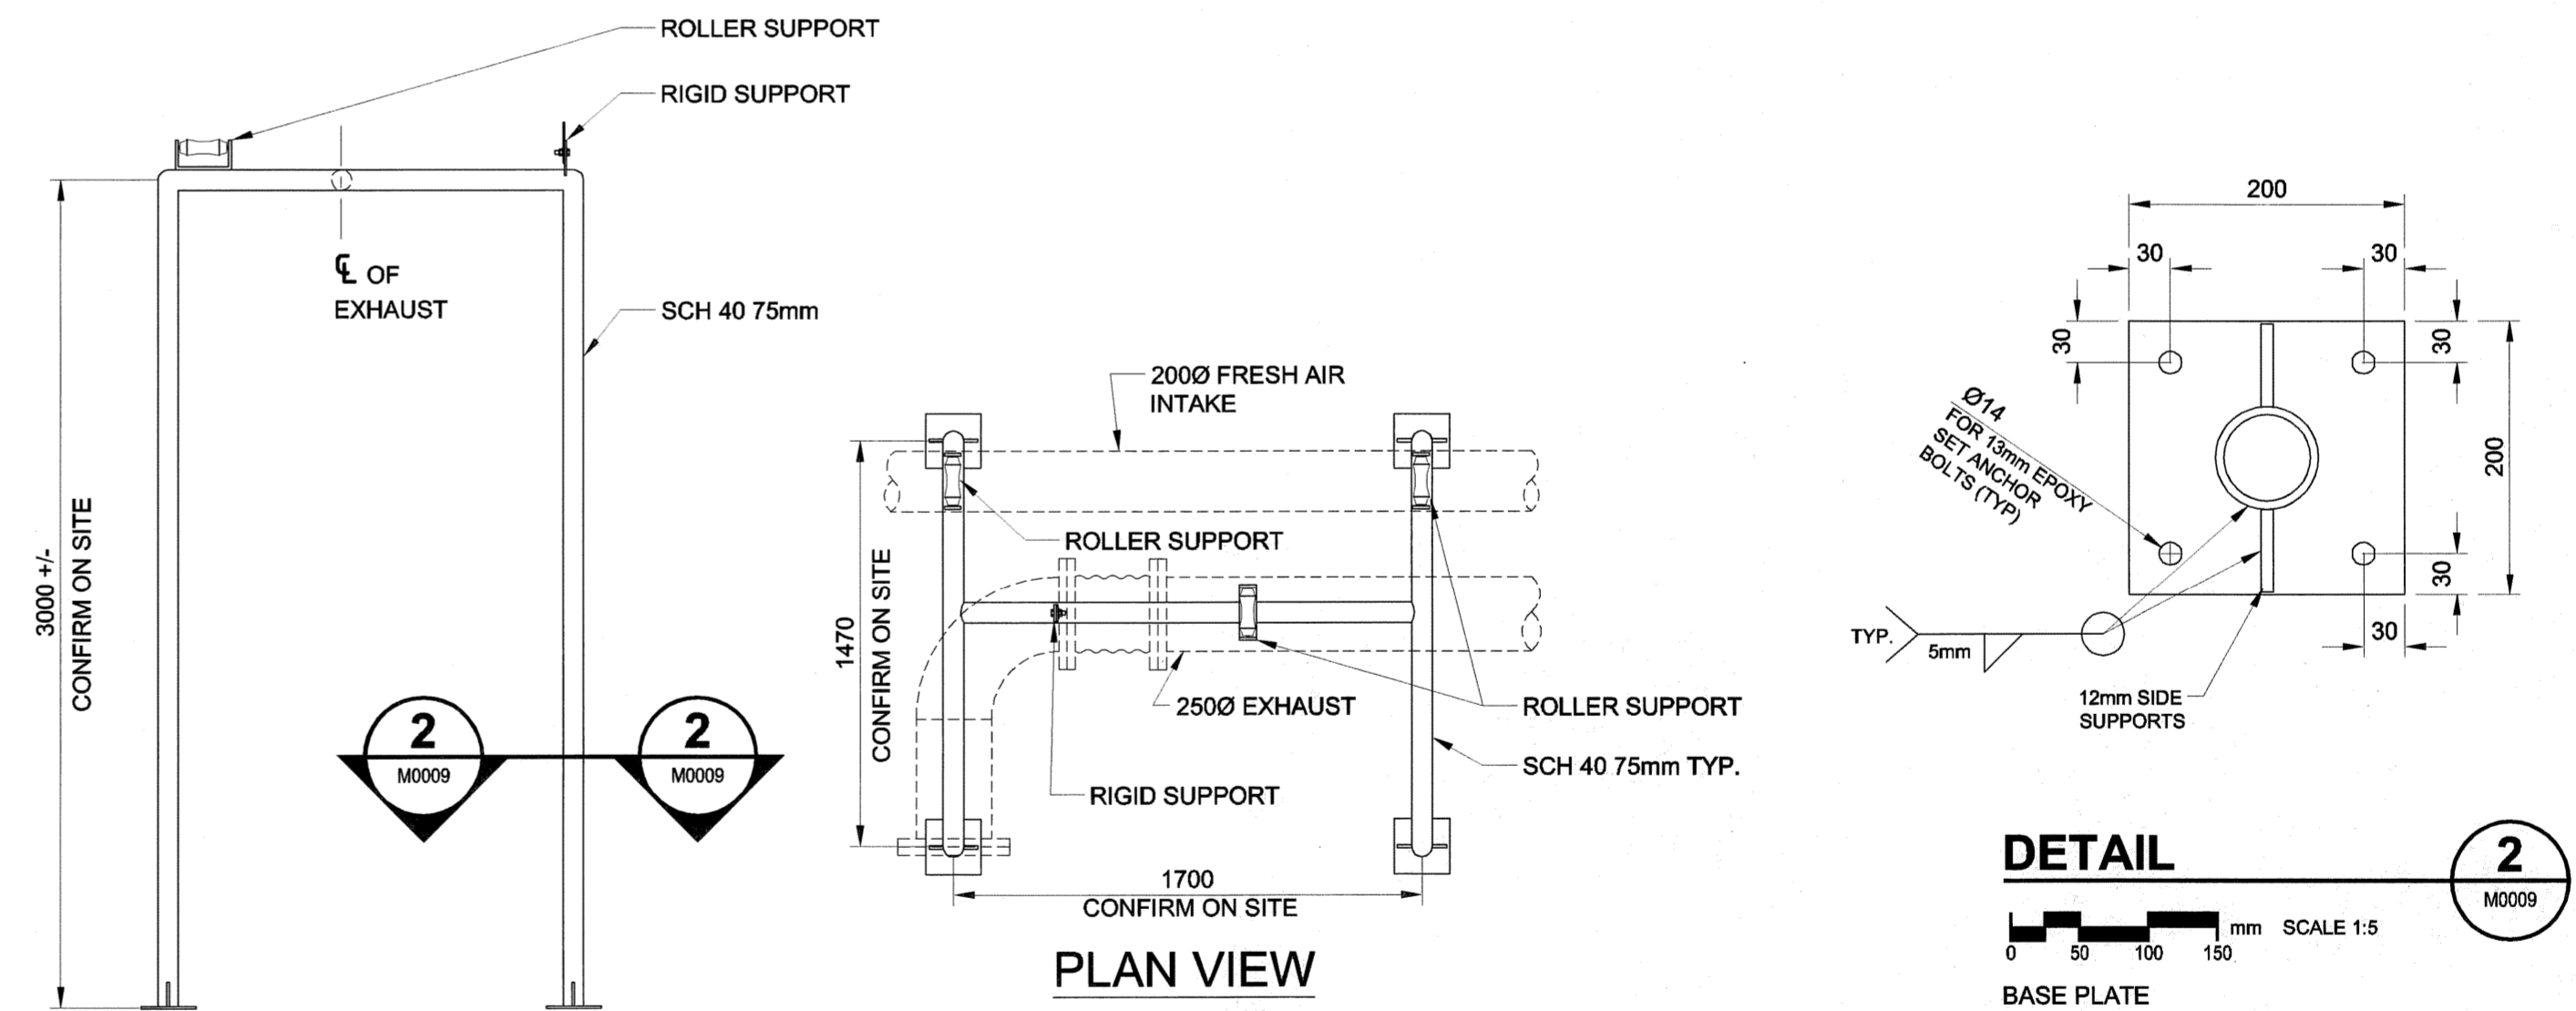
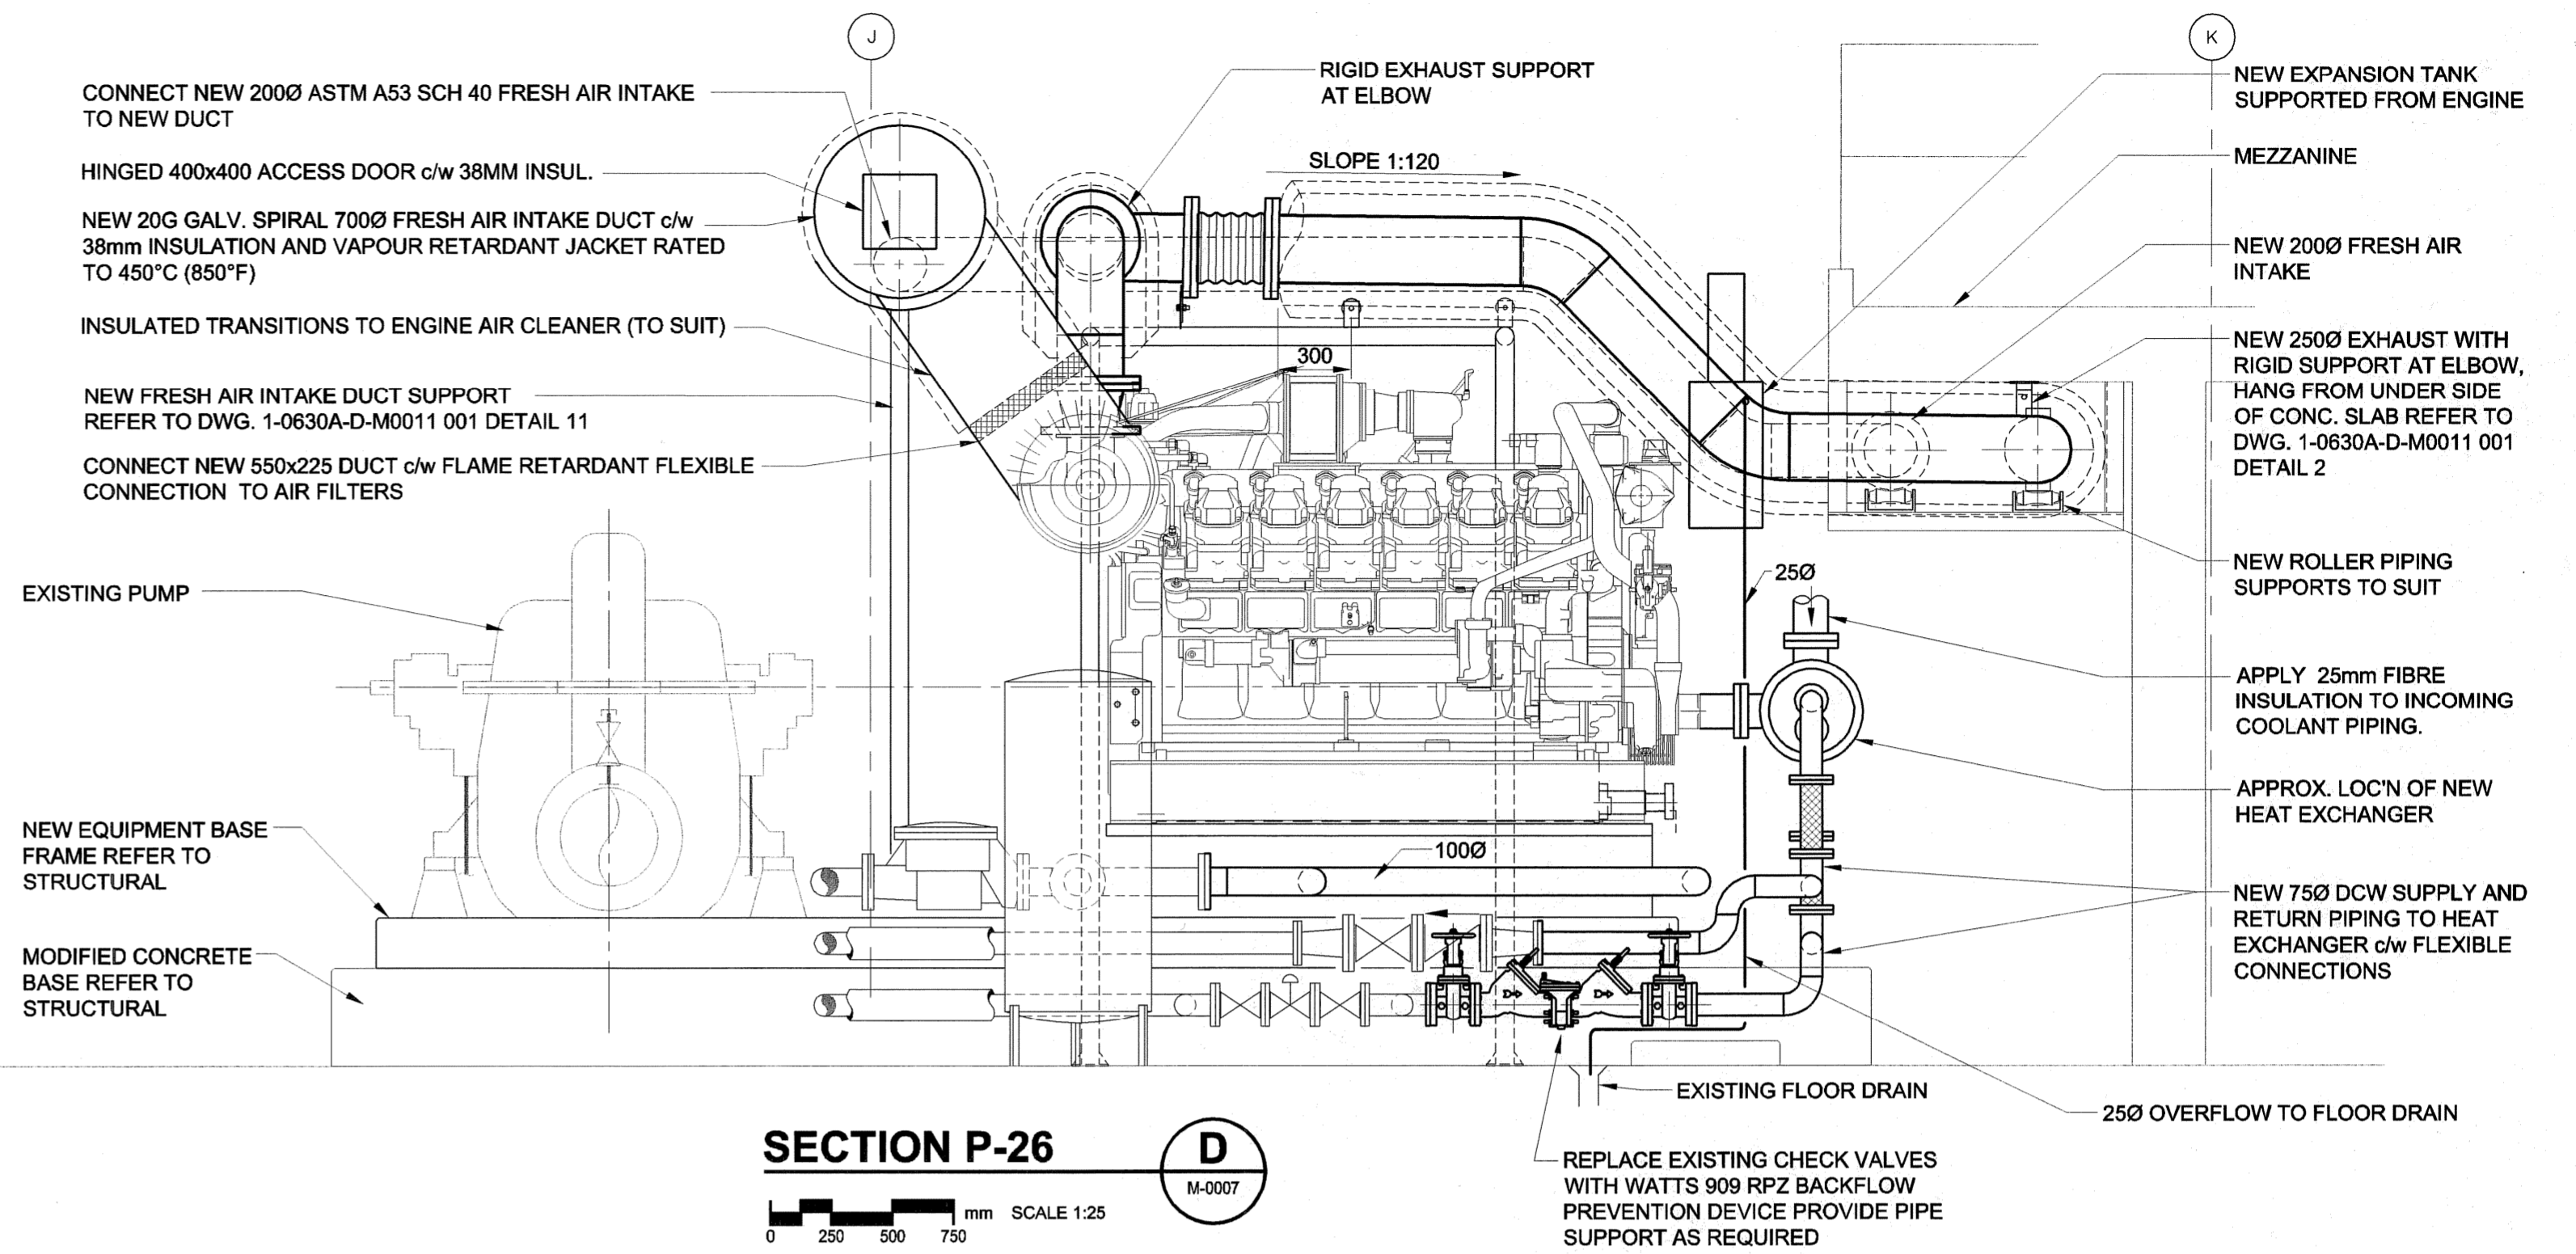


D SIZE 22" x 34" (559mm x 864mm)

PLOT: 07/08/21 4:23:30 PM

UMA FILE NAME: D265-199-00_01-M-0009_RX.dwg Saved By: astone

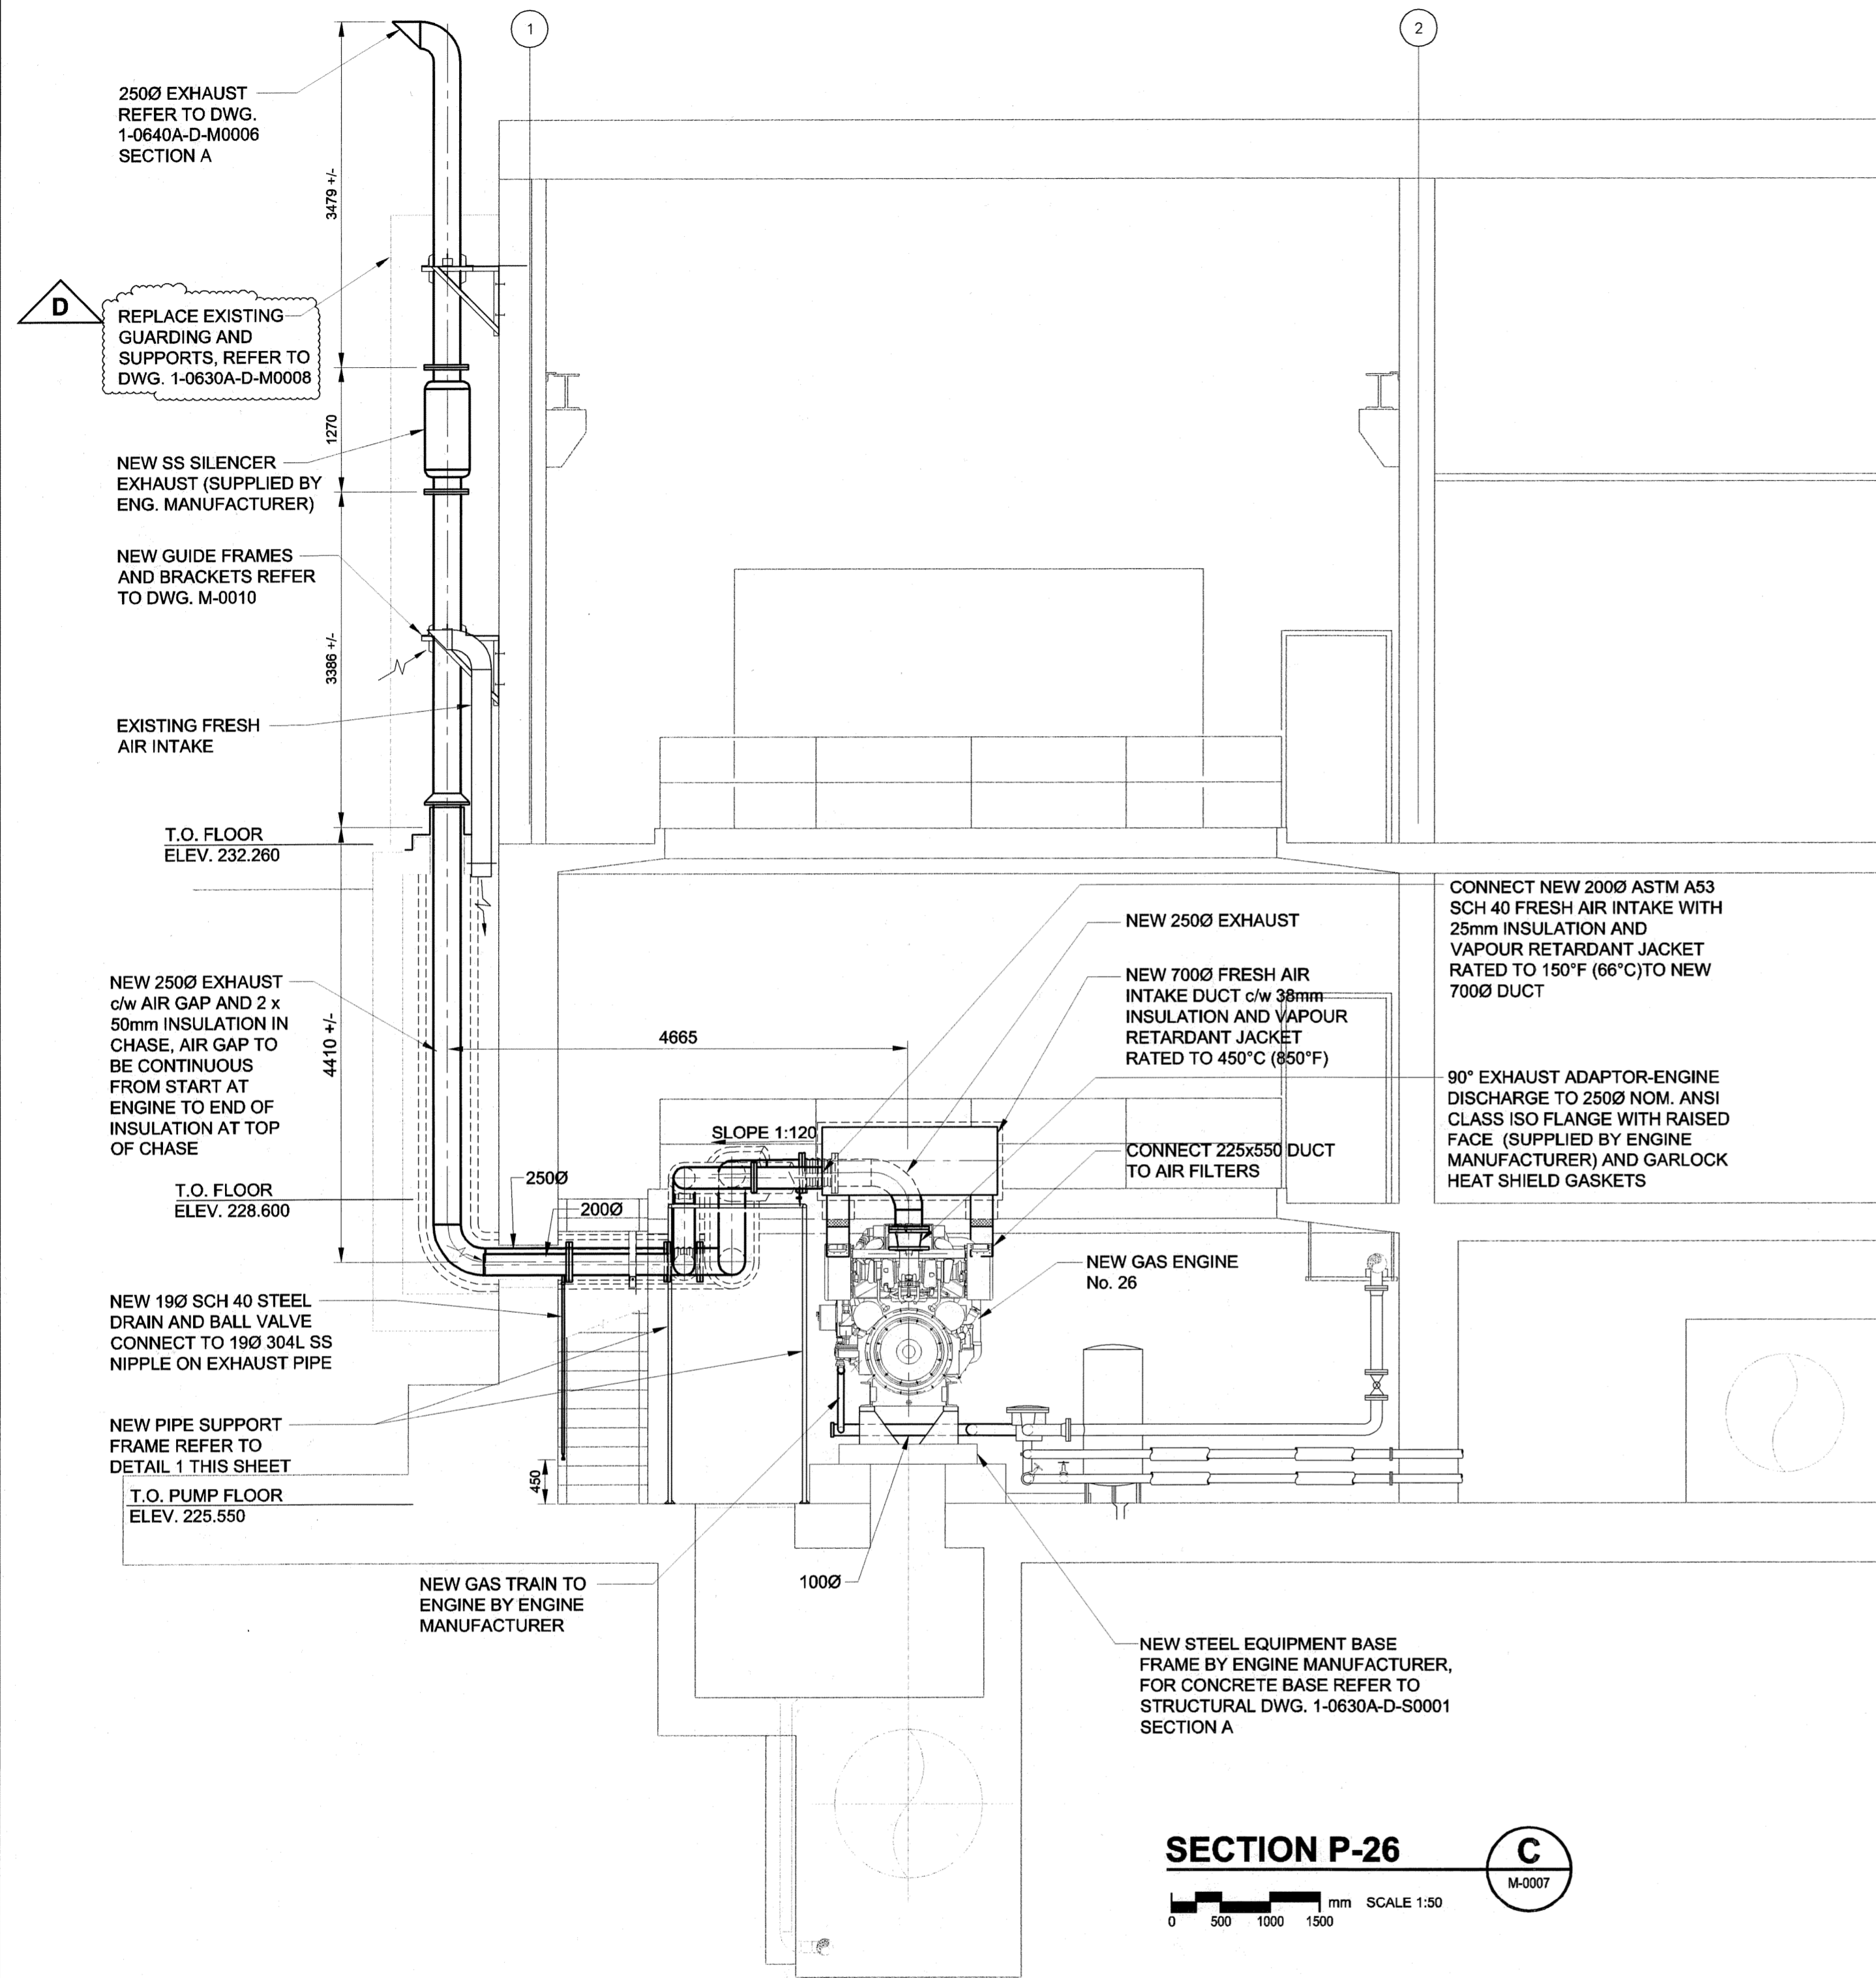

ALS	AR	CC	DR
DRN	CHK	DES	ENG
			UDR

UMA/AECOM REVIEW

B.M. ELEV.	FIELD BOOK #:	UMA AECOM	ENGINEER'S SEAL
POSTED TO LBIS		DESIGNED BY: CAC	CHECKED BY: _____
		DRAWN BY: RJP	APPROVED BY: _____
D ISSUED FOR ADDENDUM	07/08/16	ALS	RELEASED FOR CONSTRUCTION
C ISSUED FOR BID	07/06/15	RJP	
B ISSUED FOR 99% REVIEW	07/05/04	RJP	
A ISSUED FOR 75% REVIEW	07/03/15	RJP	
NO. REVISIONS	DATE	BY	FILENAME: D265-199-00_01-M-0009_RX.dwg

PROVINCE OF MANITOBA
Aug 22-07
C.A.D. COURCHAINE
REGISTERED PROFESSIONAL ENGINEER

THE CITY OF WINNIPEG
Winnipeg WATER AND WASTE DEPARTMENT

G. C. MACLEAN PUMPING STATION
Contract No.
Natural Gas Engine Drives Replacement
Mechanical - New Construction
ENGINE P-26 REPLACEMENT - SECTIONS

CITY DRAWING NUMBER: **1-0630A-D-M0009** SHEET REV. SIZE: **001 D D**