


**Norquay Community Centre-
Proposed Mechanical Room For Waterplay**

N.11-F

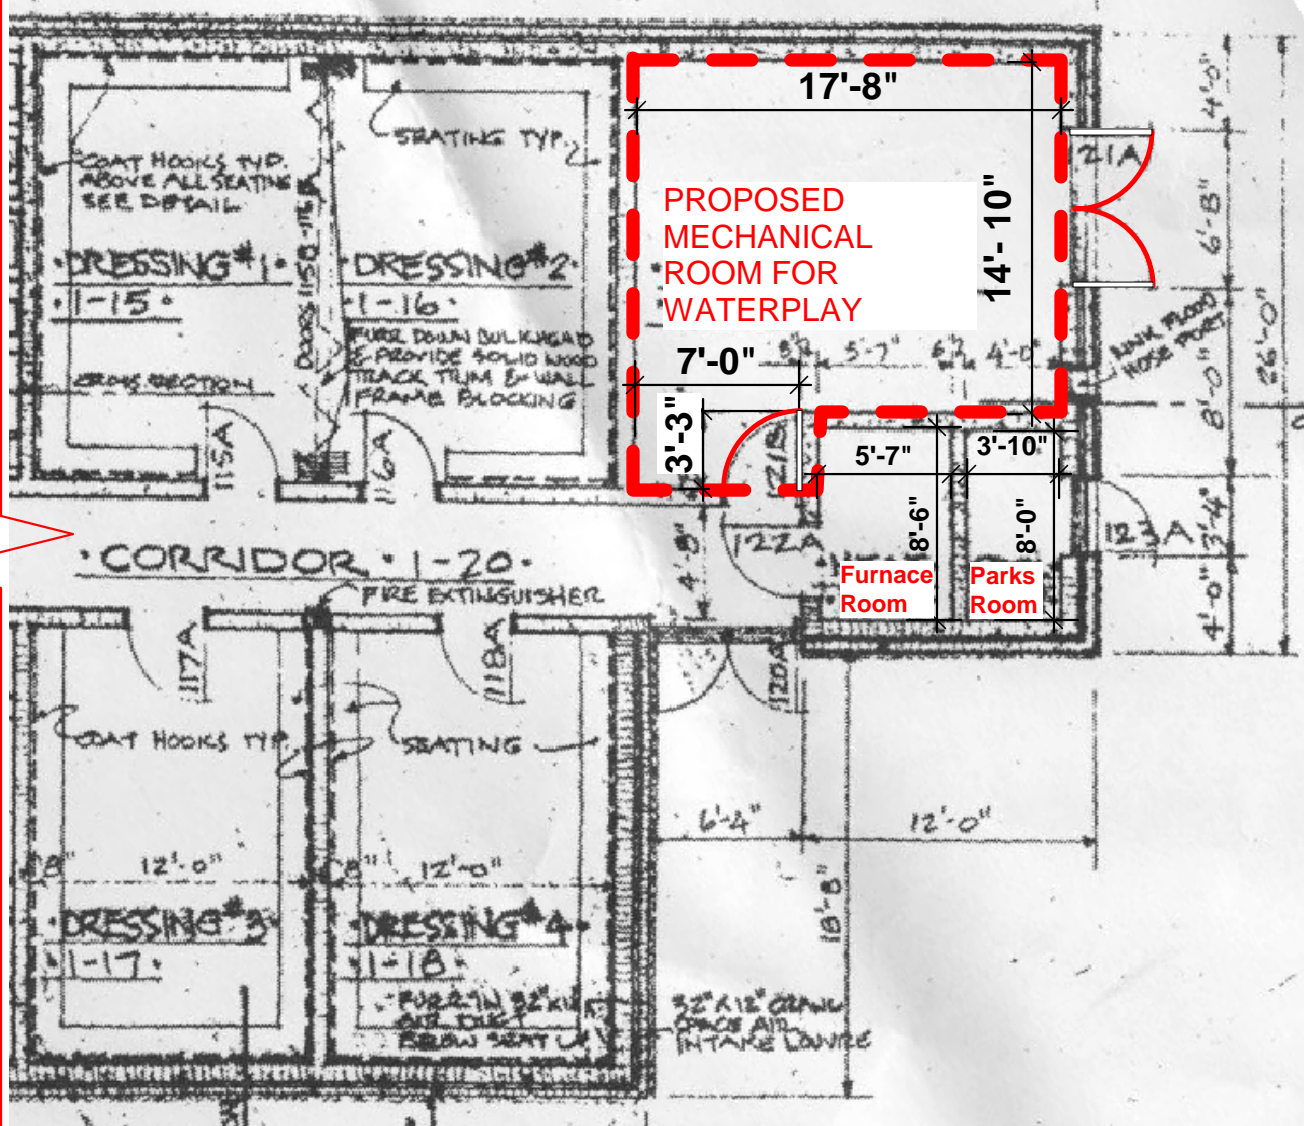

PLAN- Part of Community Centre Building



Scale: NTS
Drawn By: BB
Date: August 2006

THE CITY OF WINNIPEG
Planning, Property and Development Department
Planning and Land Use Division
Unit 15 - 10 Fort Street, Winnipeg, MB, R3C 4X5

