


1 UPPER LEVEL COMPRESSED AIR PLAN
1:75

DRAWING NOTES	
①	40# CA DOWN, SEE CONTINUATION ON WS-H0114.
②	25# CA C/W PRV, RELIEF VALVE, ISOLATION VALVE, AND PRESSURE GAUGE ASSEMBLY. DROP DOWN TO LOW LEVEL SEE WS-H0113 FOR CONTINUATION.
③	25# CA C/W PRV, RELIEF VALVE, ISOLATION VALVE, AND PRESSURE GAUGE ASSEMBLY. FLEXIBLE CA C/W QUICK CONNECT FOR RAIL CAR UNLOADING.
④	40# CA TO SODIUM HYPOCHLORITE BUILDING.
⑤	PROVIDE CA FLOAT TRAP AND PIPE DRAIN TO AREA SUMP PIT.
⑥	DROP CA DOWN FOR AMMONIA TANK AREA.

GENERAL NOTES	
1. COORDINATE WITH OTHER TRADES.	

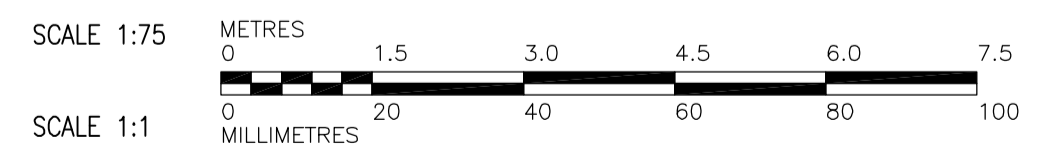

APECA
Certificate of Authorization
Earth Tech Canada Inc.
No. 730 Expiry: April 30, 2007

B.M. ELEV.			
NO.	REVISIONS	DATE	BY
01	792-2006 ADDENDUM 2	07/03/20	LJW
00	ISSUED FOR TENDER	07/01/31	DL

CH2M HILL
Frederickson Cooper ARCHITECTS

EarthTech
A Tyco International Ltd. Company

DESIGNED BY: JDB	CHECKED BY: PVL/AMA
DRAWN BY: DL	APPROVED BY: AHL
SCALE: 1:75	RELEASED FOR CONSTRUCTION BY: R. SOROKOWSKI
	DATE: 2007/01/31

ENGINEER'S SEAL
ORIGINAL SIGNED BY
A. M. AFTANAS
2007/01/31
CONSULTANT DRAWING NO.
WS-H0124

THE CITY OF WINNIPEG
WATER AND WASTE DEPARTMENT
ENGINEERING DIVISION

WATER TREATMENT PLANT
BULK CHEMICAL STORAGE
SODIUM HYPOCHLORITE AND CHEMICAL STORAGE BUILDING

MECHANICAL
UPPER LEVEL COMPRESSED AIR PLAN

CITY FILE NUMBER	
SHEET OF	
CITY DRAWING NUMBER	1-0601S-A-H0124-001-01D