SHEET: COW-A1 (05/2005)

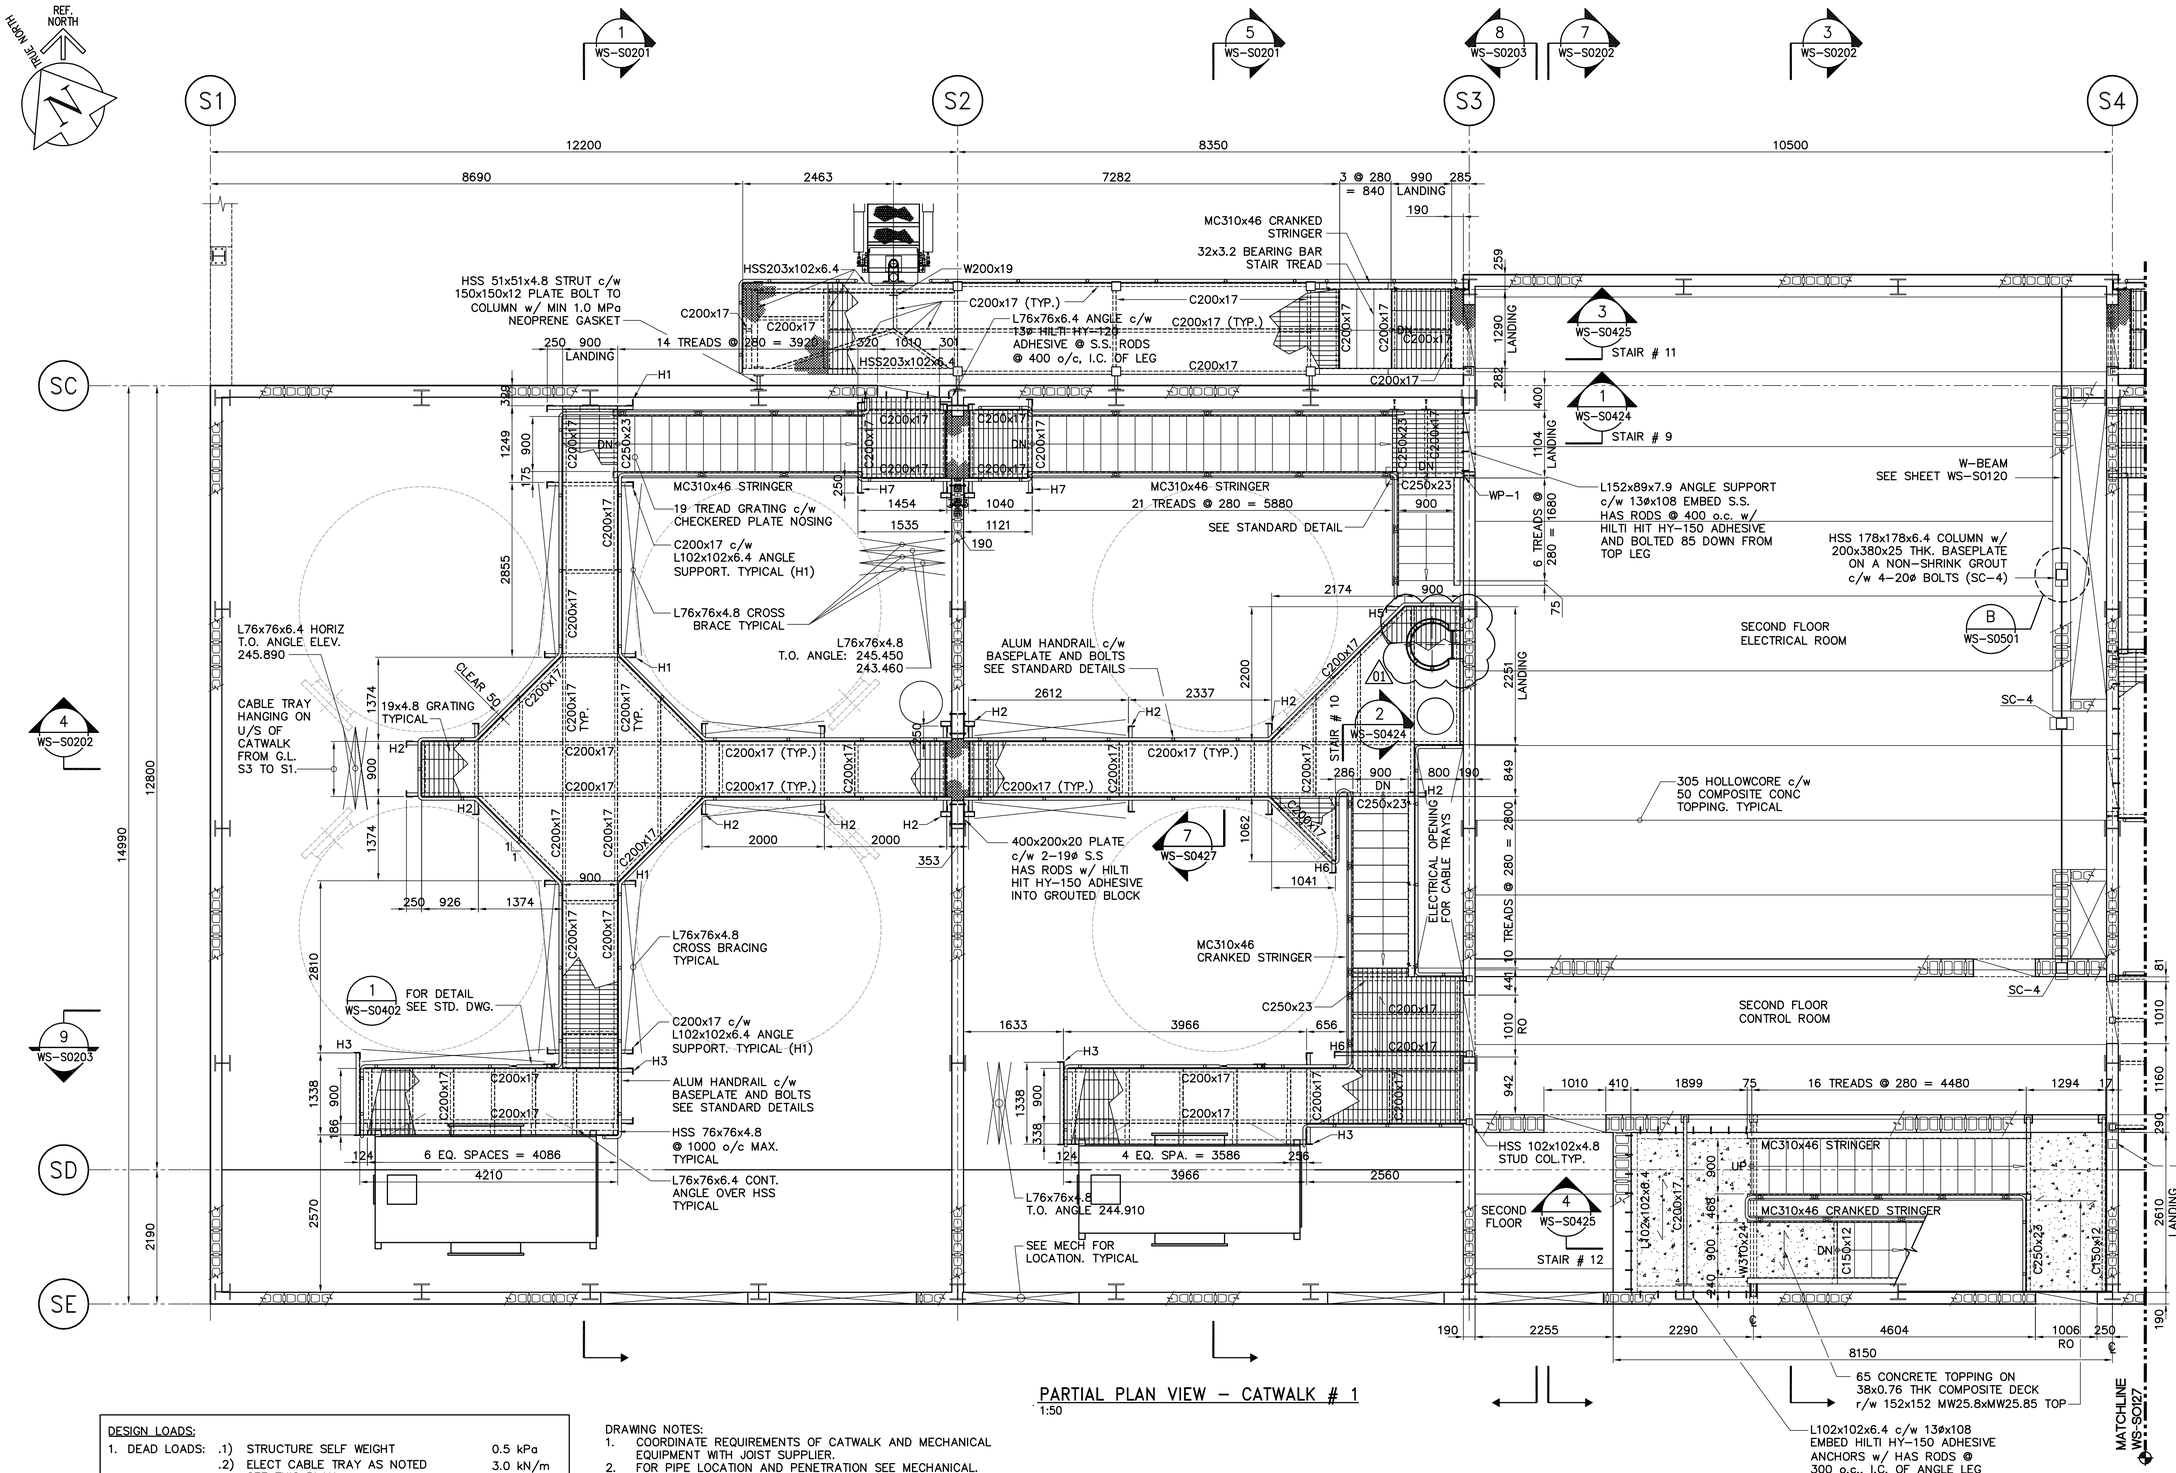

PARTIAL PLAN VIEW – CATWALK # 1
1:50

DESIGN LOADS:

1. DEAD LOADS:	.1)	STRUCTURE SELF WEIGHT	0.5 kPa
	.2)	ELECT CABLE TRAY AS NOTED SEE THIS PLAN	3.0 kN/m
2. LIVE LOADS	.1)	OCCUPANCY	4.8 kPa

DRAWING NOTES:
1. COORDINATE REQUIREMENTS OF CATWALK AND MECHANICAL EQUIPMENT WITH JOIST SUPPLIER.
2. FOR PIPE LOCATION AND PENETRATION SEE MECHANICAL.
3. REFER TO DRAWINGS WS-S0425 TO WS-S0427 FOR STAIR DETAIL
4. REFER TO WS-S0402 FOR REMOVABLE GUARDRAIL FOR CATWALK.
5. FOR HANGER SUPPORT DETAILS AND BRACKETS SEE DWG. WS-S0128

SCALE 1:50
SCALE 1:1
METRES 0 1 2 3 4 5
MILLIMETRES 0 20 40 60 80 100

APEGM
Certificate of Authorization
Earth Tech Canada Inc.
No. 730 Expiry: April 30, 2007

NO.	REVISIONS	DATE	BY
01	792-2006 ADDENDUM 2	07/03/22	WDB
00	ISSUED FOR TENDER	07/01/31	WDB

B.M. ELEV.

CH2MHILL
Fredericksen Cooper ARCHITECTS
EarthTech A Tyco International Ltd. Company

DESIGNED BY	ARA	CHECKED BY	AP
DRAWN BY	WDB	APPROVED BY	AHL
SCALE:	AS NOTED	RELEASED FOR CONSTRUCTION BY:	R. SOROKOWSKI
DATE	2006/09/10	DATE	2007/01/31

ENGINEER'S SEAL
ORIGINAL SIGNED BY
A. POCHANART
2007/01/31

CONSULTANT DRAWING NO. WS-S0126

Winnipeg
THE CITY OF WINNIPEG
WATER AND WASTE DEPARTMENT
ENGINEERING DIVISION

WATER TREATMENT PLANT
BULK CHEMICAL BUILDING
SODIUM HYPOCHLORITE AND CHEMICAL STORAGE BUILDING
STRUCTURAL
PARTIAL CATWALK STAIRS AND PLATFORMS PLAN

CITY FILE NUMBER
SHEET OF
CITY DRAWING NUMBER 1-0601S-A-S0126-001-01D

Last Save: 2007-03-22 9:44 AM

L:\WORK\79000\79538\02A-CAD\IND\CONTR\BULK CHEMICAL BLDG\DN_WS-S0126_ET.DWG