




**3 SECTION**  
 WS-S0202 1:75  
 WS-F0100, WS-S0100,  
 WS-S0110, WS-S0120,  
 WS-S0125, WS-S0140

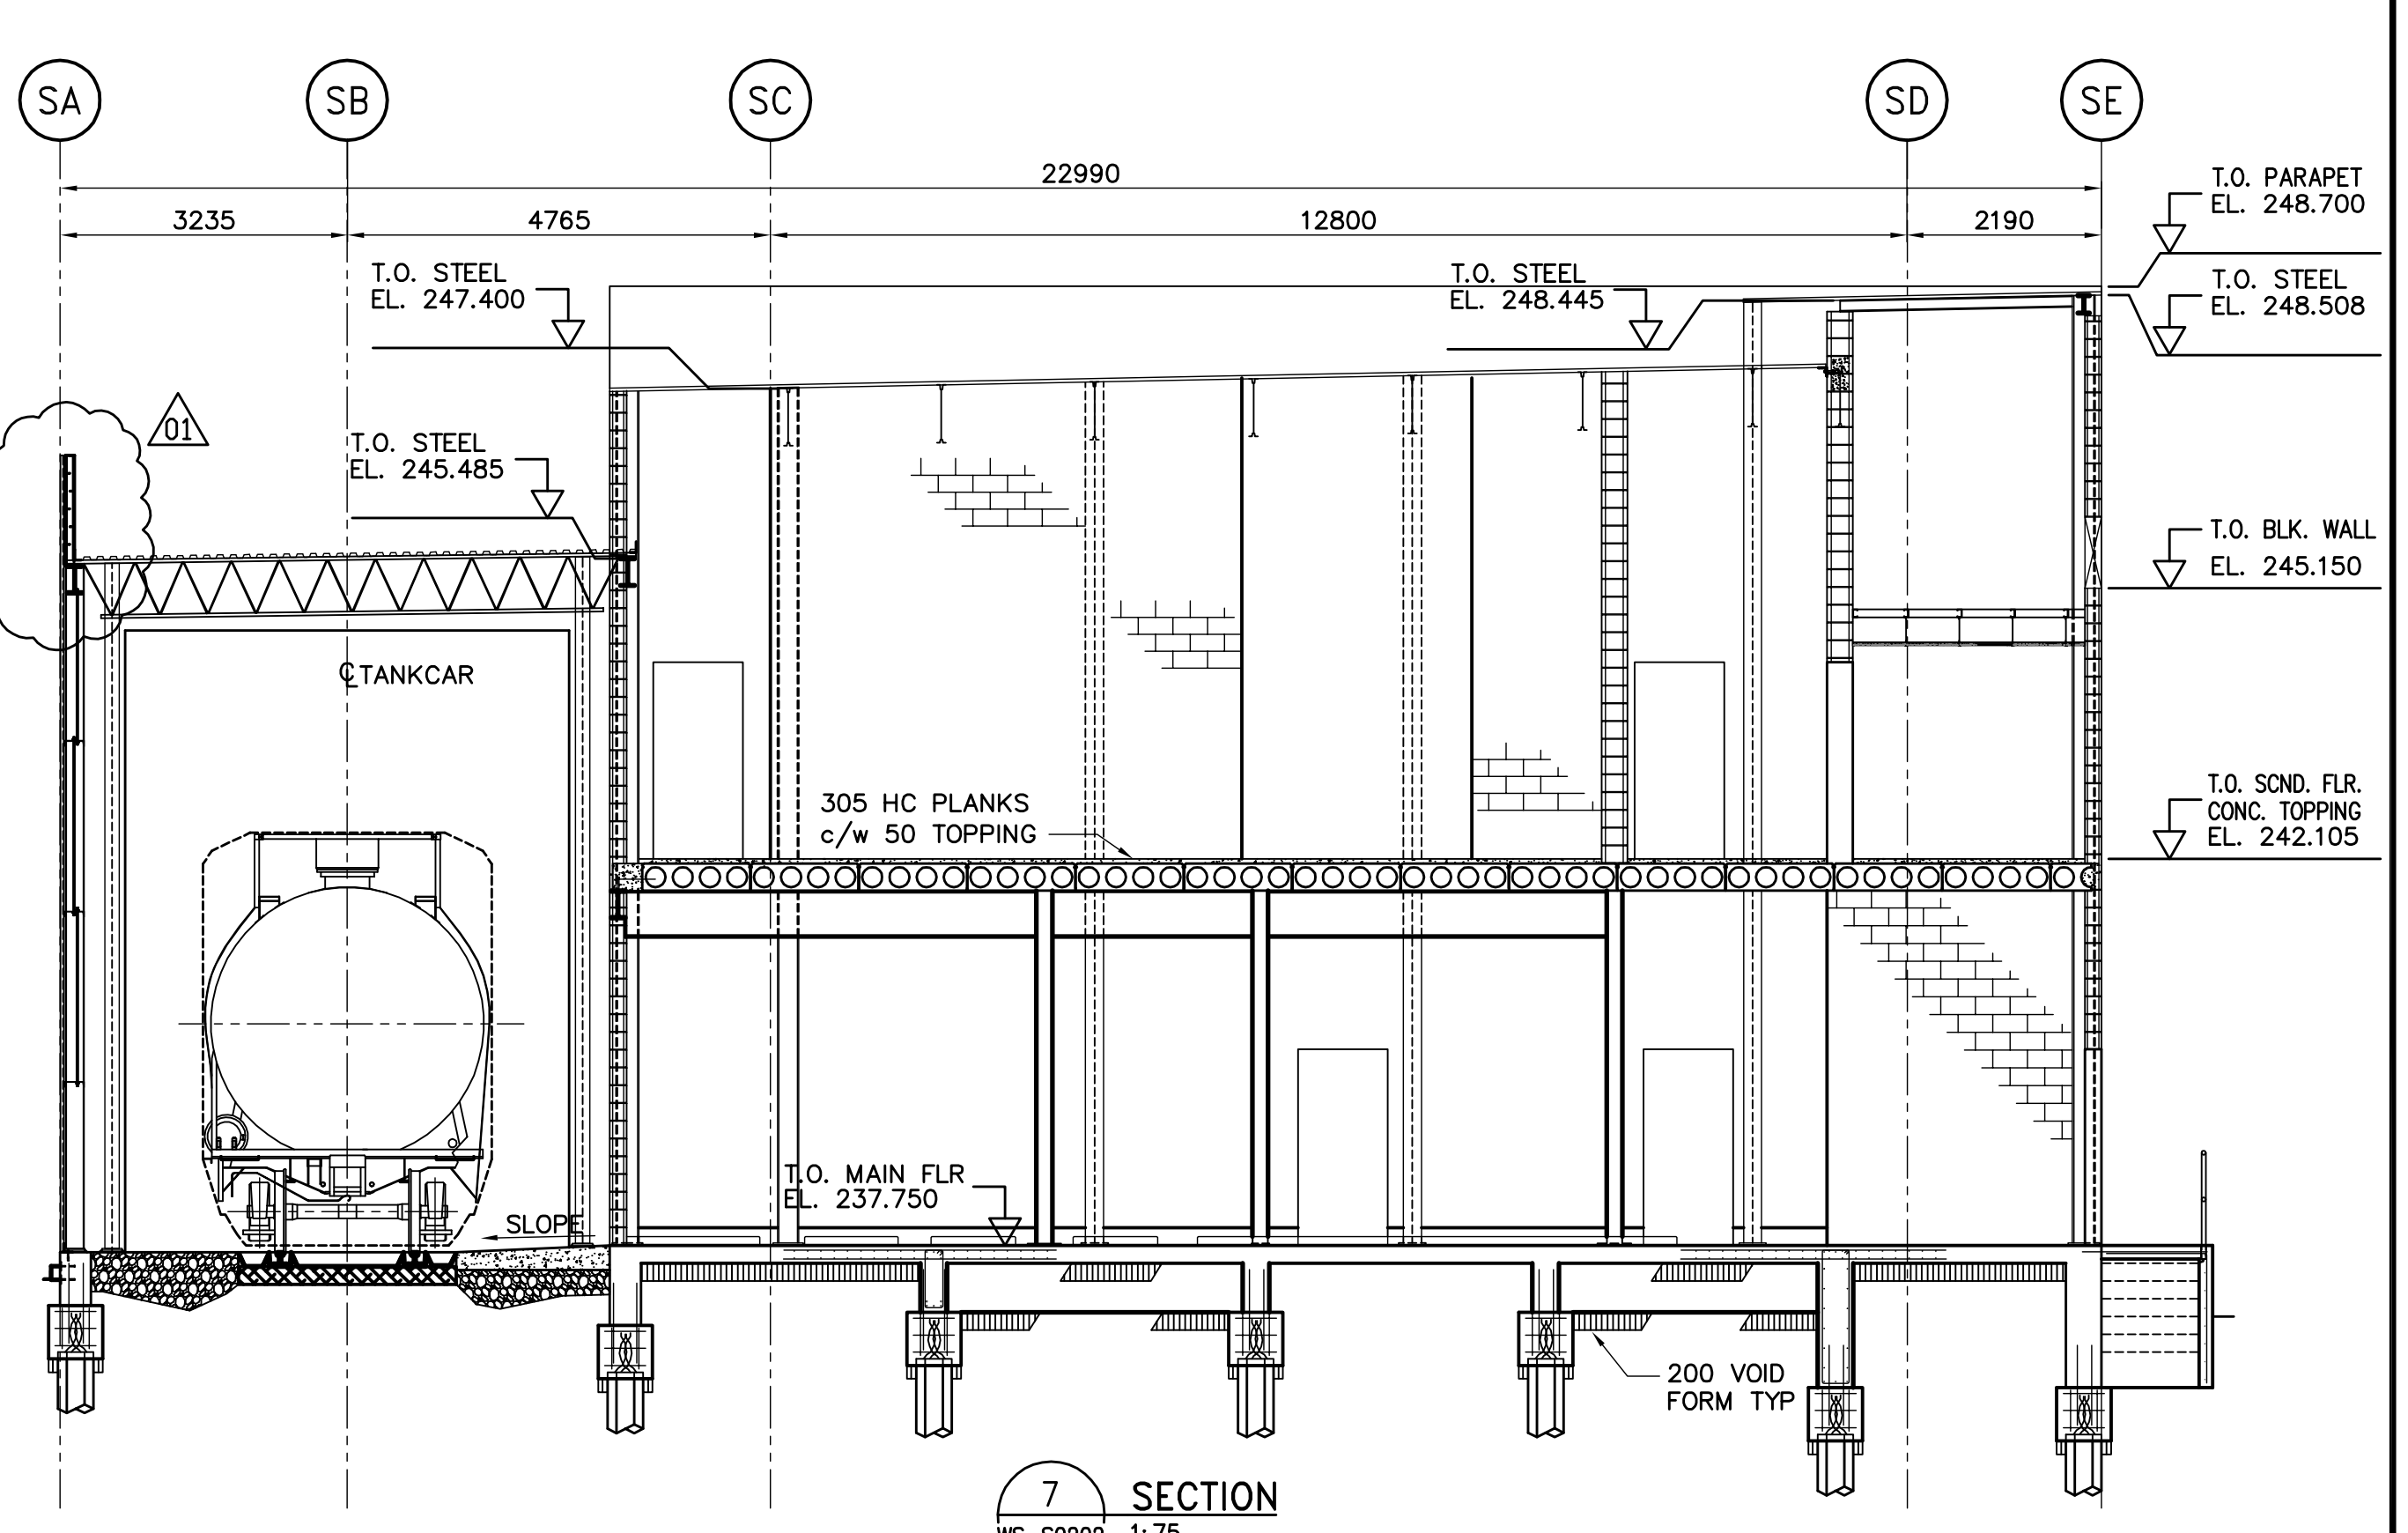

**7 SECTION**  
 WS-S0202 1:75

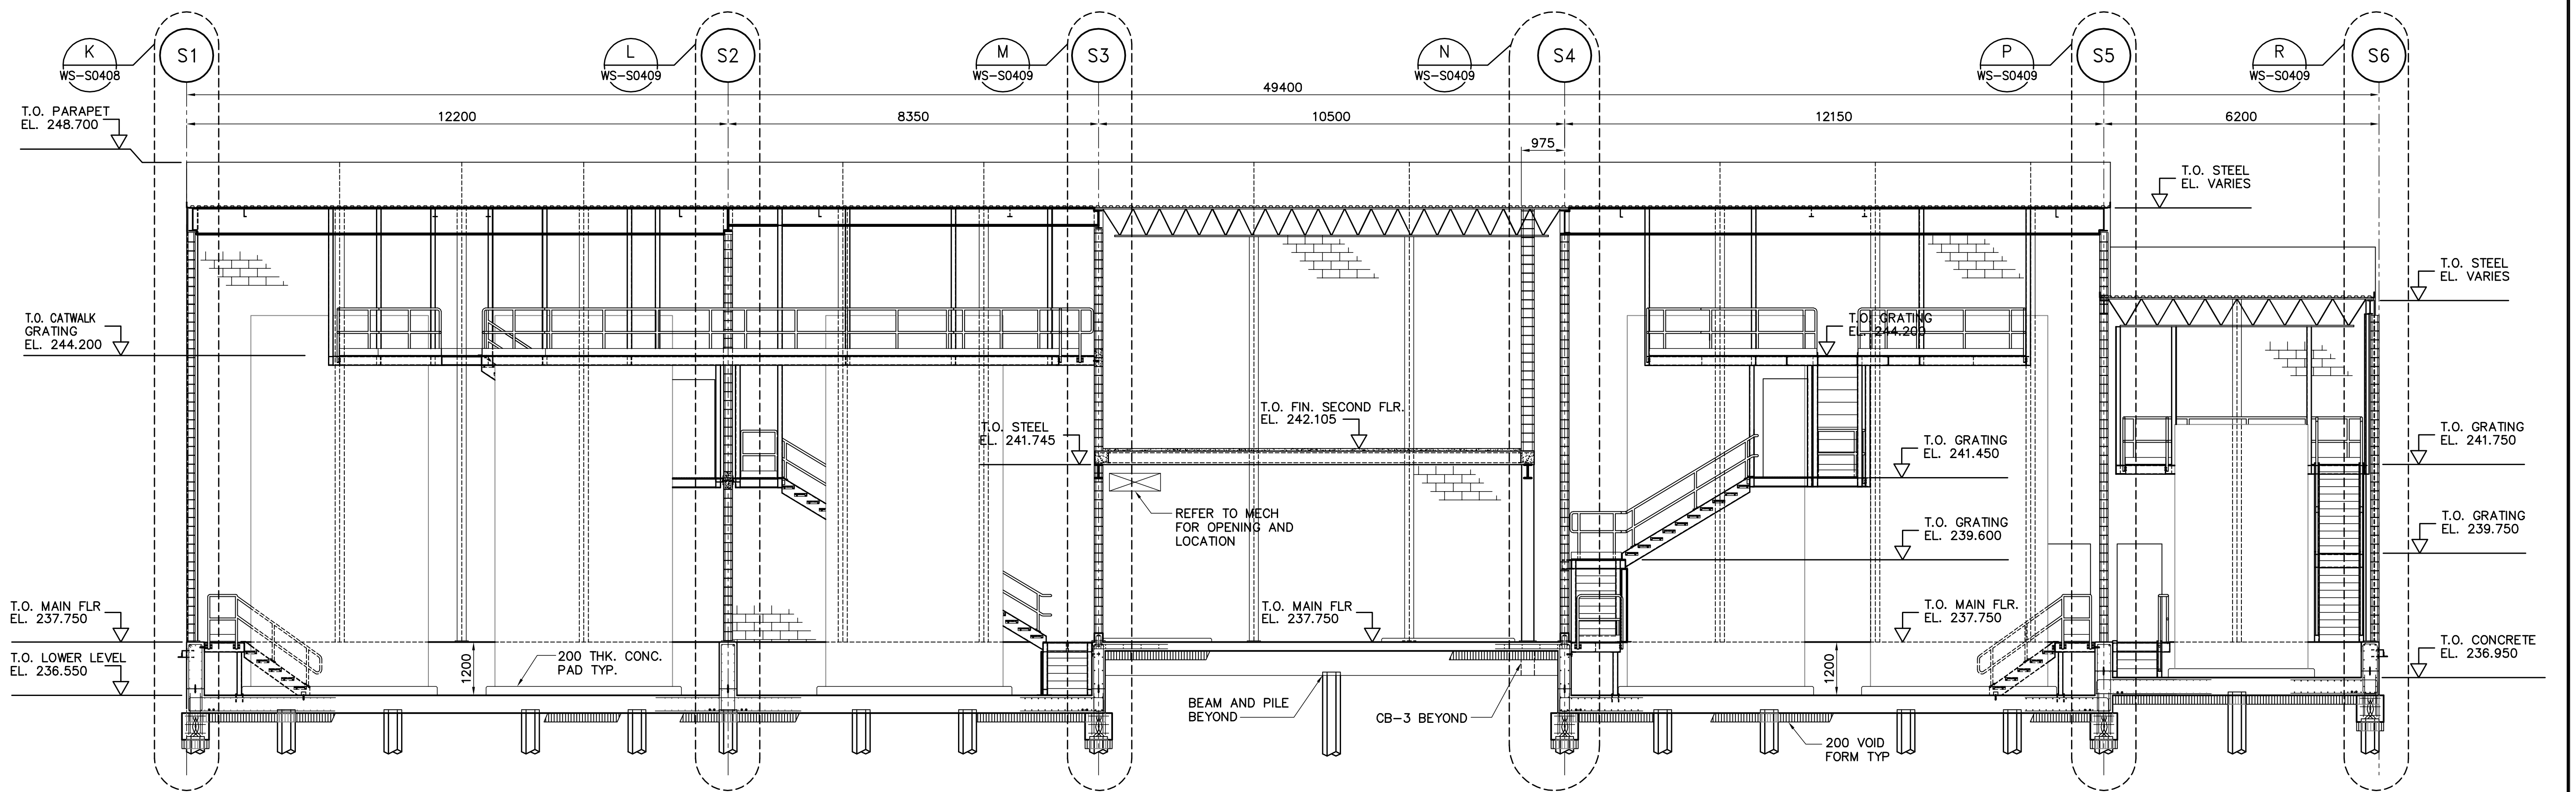

**4 SECTION**  
 WS-S0202 1:75  
 WS-F0100, WS-S0100, WS-S0110,  
 WS-S0120, WS-S0125, WS-S0140,  
 WS-S0141

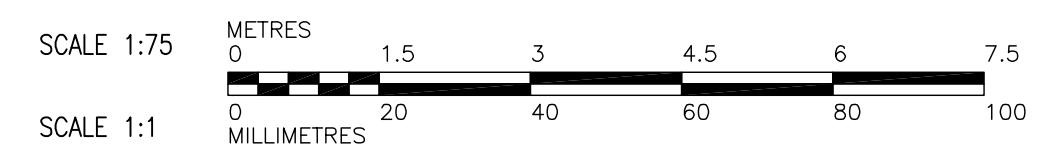

B.M. ELEV.		<b>CH2M HILL</b> Frederickson Cooper ARCHITECTS		ENGINEER'S SEAL		<b>THE CITY OF WINNIPEG</b> WATER AND WASTE DEPARTMENT ENGINEERING DIVISION	
DESIGNED BY	ARA	CHECKED BY	AP	ORIGINAL SIGNED BY	A. POCHANART	WATER TREATMENT PLANT BULK CHEMICAL BUILDING SODIUM HYPOCHLORITE AND CHEMICAL STORAGE BUILDING	
DRAWN BY	WDB	APPROVED BY	AHL	DATE	2007/01/31	CITY FILE NUMBER	
SCALE:	AS NOTED	RELEASED FOR CONSTRUCTION BY:	R. SOROKOWSKI	CONSULTANT DRAWING NO.	WS-S0202	SHEET OF	
NO. REVISIONS	DATE	DATE	2006/08/30	DATE	2007/01/31	CITY DRAWING NUMBER	
						STRUCTURAL BUILDING SECTIONS	
						<b>1-0601S-A-80202-01-0D</b>	