


- NOTES:-**
- T60 = TRANSFORMER PROTECTION RELAY - MULTILIN MODEL T60
  - DPI = DIGITAL POWER INSTRUMENTATION PACKAGE TO BE ION 7550 BY POWER MEASUREMENT LTD. CTS AND PTS ARE NOT SHOWN ON DRAWING BUT ARE TO BE PROVIDED AS PER SPECIFICATION.
  - F60 = FEEDER PROTECTION RELAY - MULTILIN MODEL F60

—○—○—○— INDICATE F.O. NETWORK CONNECTION TO LCP-S11A

**KEY INTERLOCKS**  
 K, K1, K2, K3 :-  
 EACH TWO KEYS, THREE LOCKS, KEY REMOVABLE IN THE BREAKER OPEN POSITION. INSERT KEY TO CLOSE BREAKER.

CITY SUPPLIED  
 SWGR #2A, 2B  
 LOCATION: BULK CHEMICAL BUILDING-ELECTRICAL ROOM

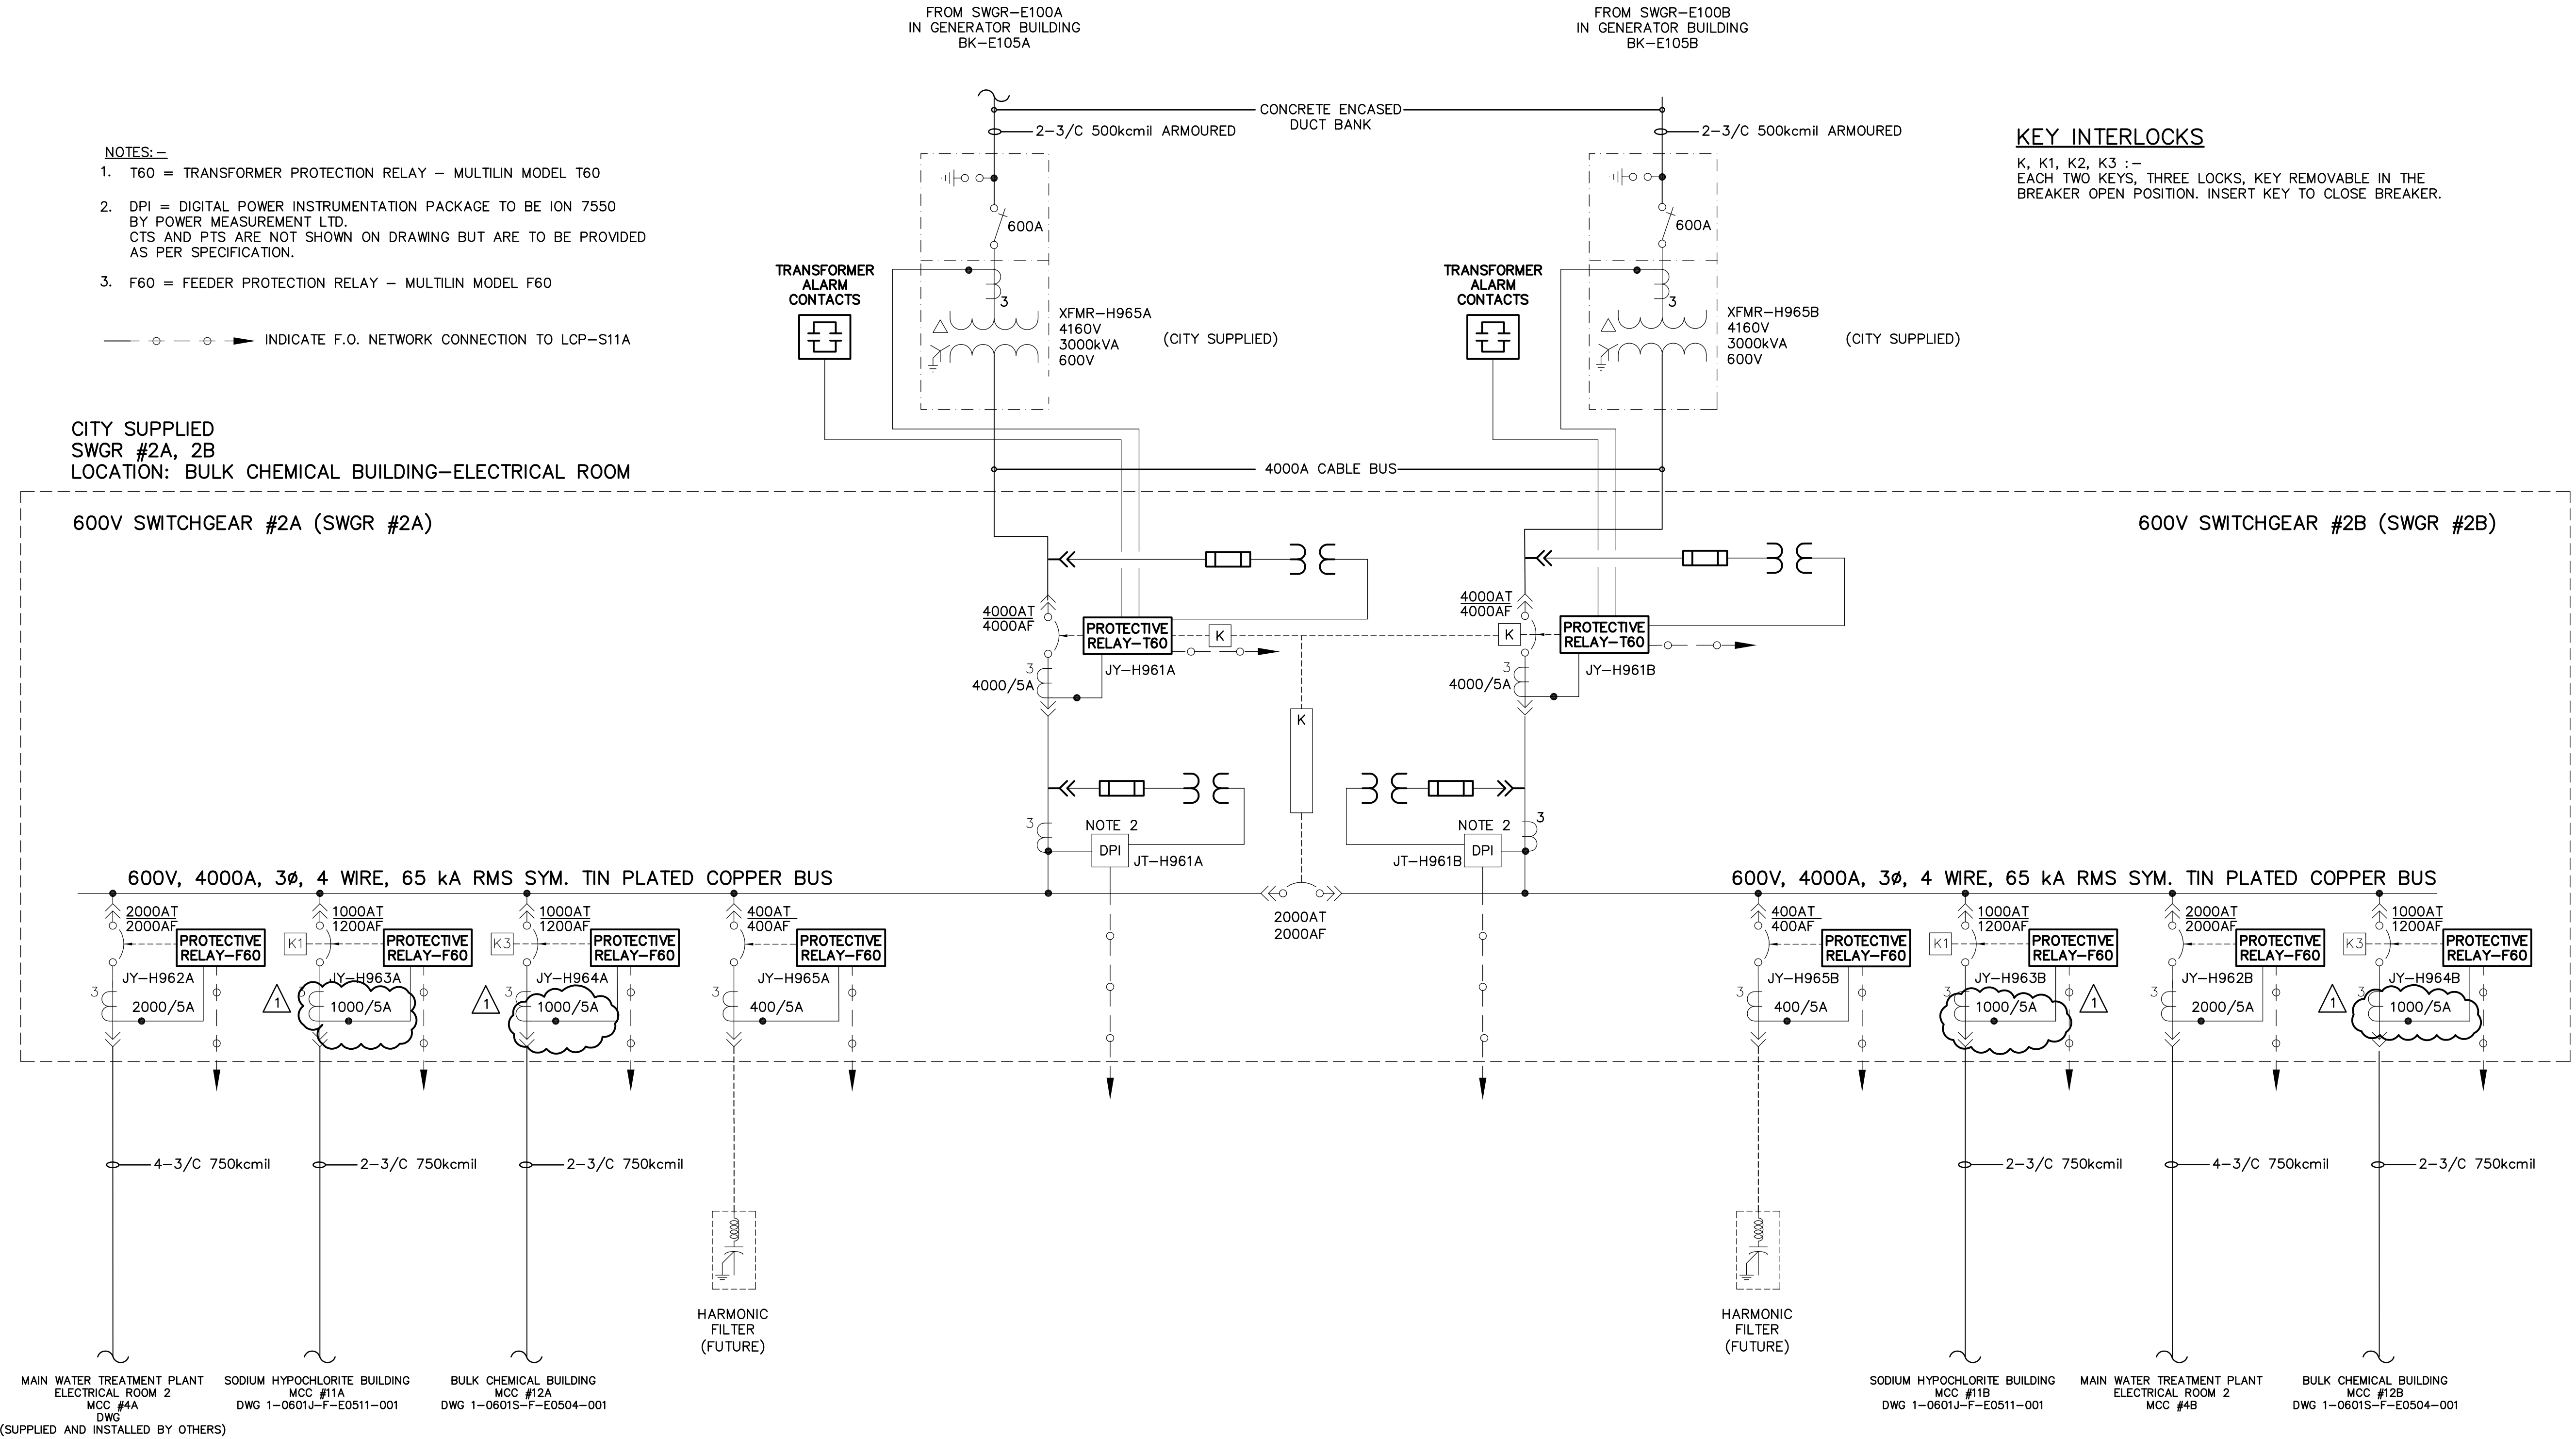

**DRAWING NOTES**

- ① REFER
- ②
- ③
- ④

<p>Certificate of Authorization                  Earth Tech Canada Inc.                  No. 730 Expiry: April 30, 2007</p>	B.M. ELEV.	<p>Frederickson Cooper                  ARCHITECTS</p>	<p>A Type International Ltd. Company</p>	ENGINEER'S SEAL	<p>THE CITY OF WINNIPEG                  WATER AND WASTE DEPARTMENT                  ENGINEERING DIVISION</p>				
	DESIGNED BY			BLM		CHECKED BY	PS	ORIGINAL SIGNED BY	P. STRYK
	DRAWN BY			ERC		APPROVED BY	AHL	2007/01/31	WATER TREATMENT PLANT BULK CHEMICAL STORAGE SODIUM HYPOCHLORITE AND CHEMICAL STORAGE BUILDING
	SCALE:			NTS		RELEASED FOR CONSTRUCTION BY:	R. SOROKOWSKI	CONSULTANT DRAWING NO.	WS-E0503
NO. REVISIONS	DATE	BY	DATE	2006/10/01	DATE	2007/01/31	CITY FILE NUMBER		
							SHEET	OF	
							CITY DRAWING NUMBER	1-0601S-F-E0503-001-010	