

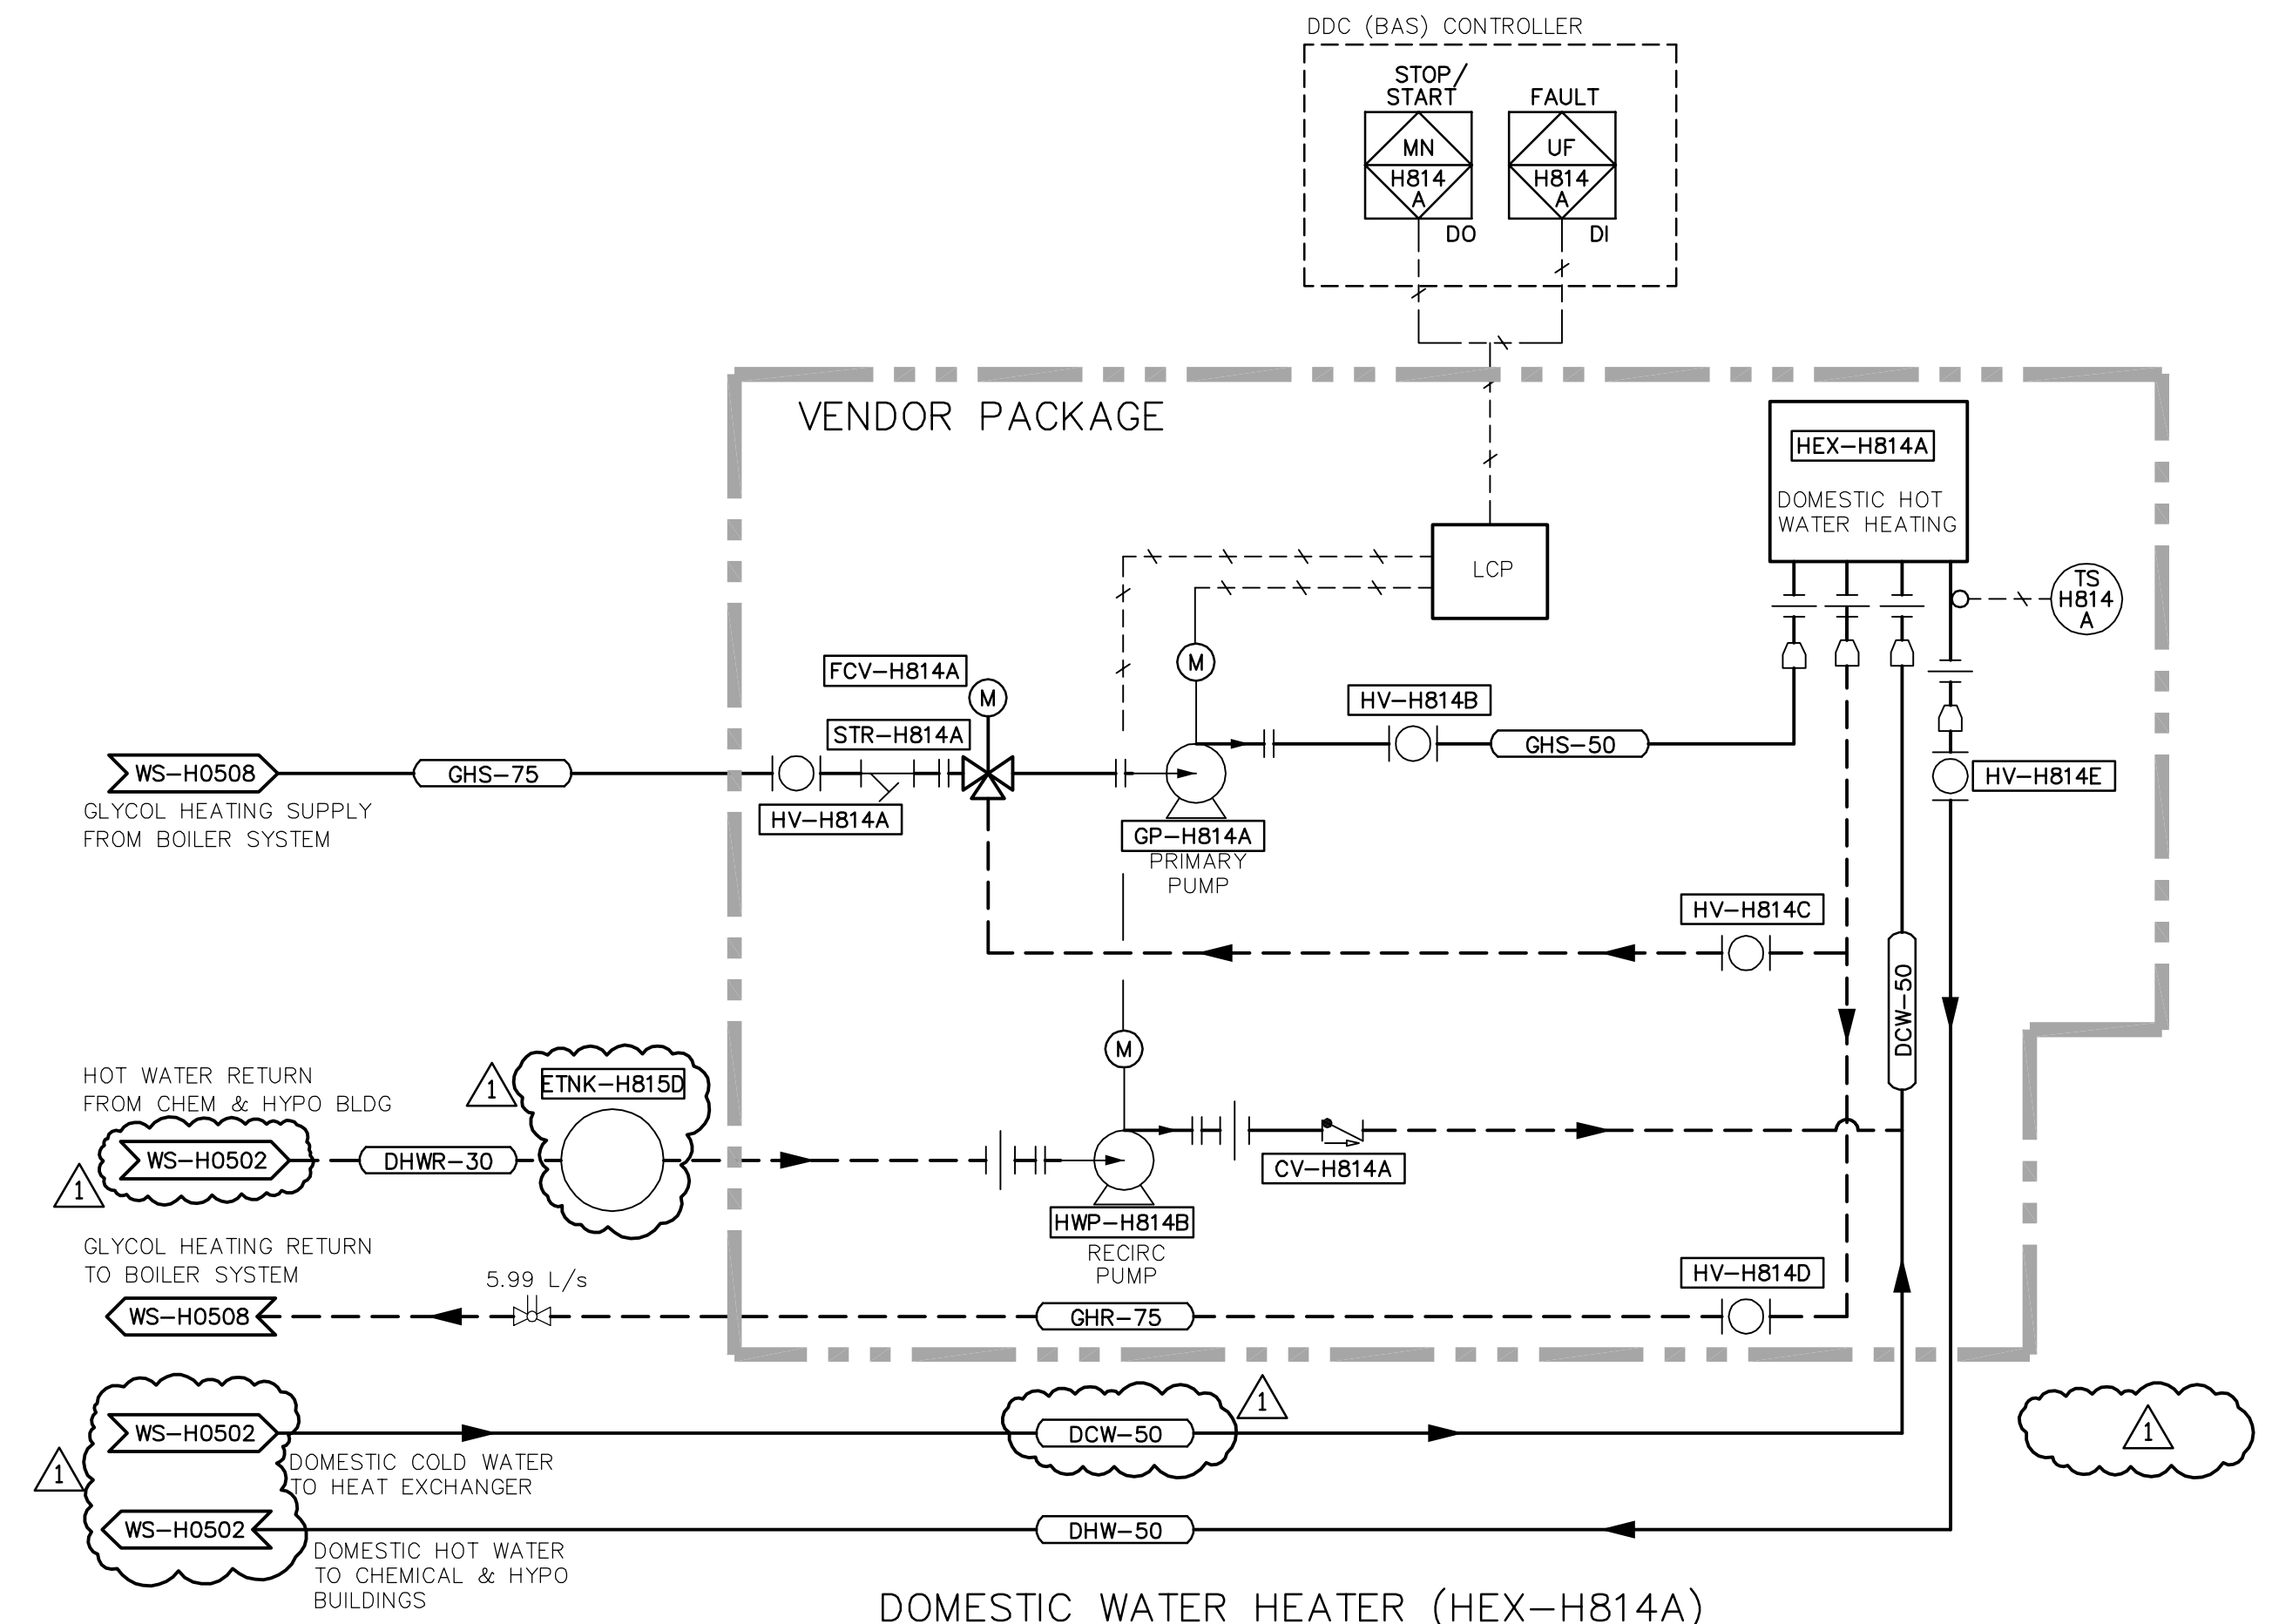


1 PROCESS WATER HEATING SCHEMATIC  
N.T.S.

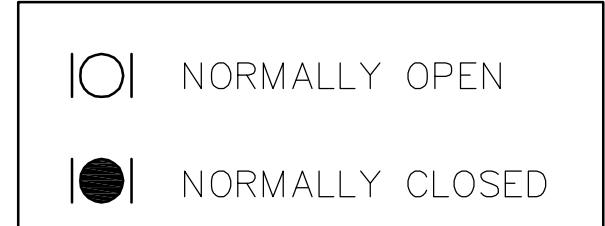

2 DOMESTIC WATER HEATING SCHEMATIC  
N.T.S.

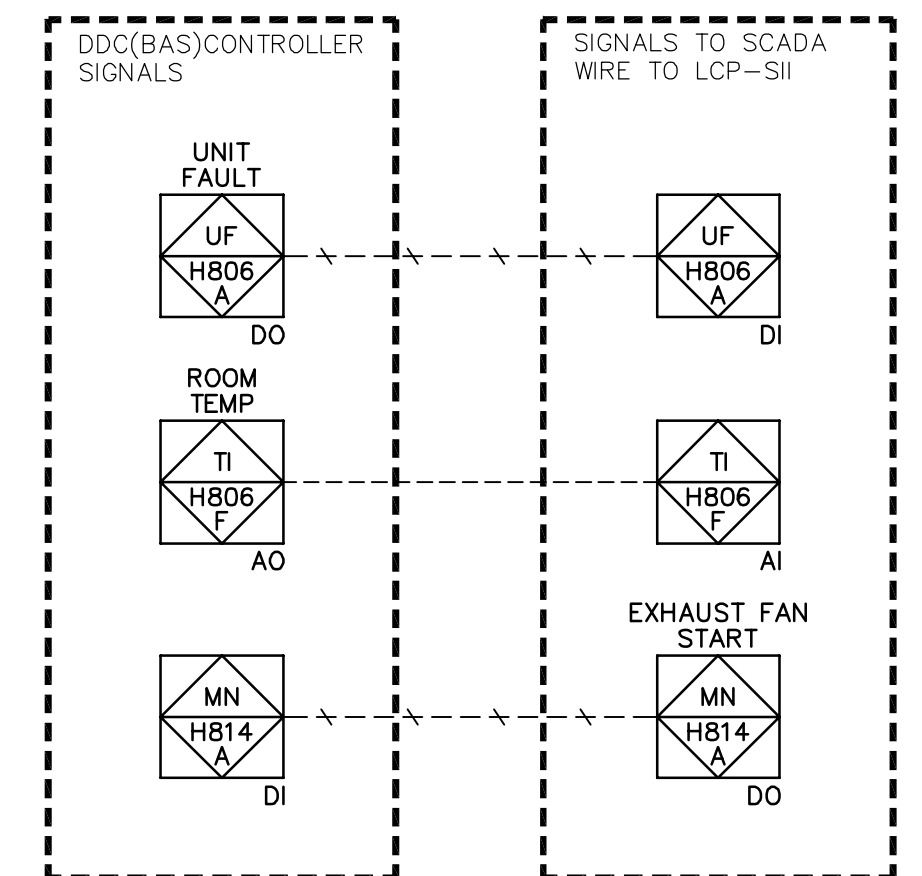

**APECA**  
Certificate of Authorization  
Earth Tech Canada Inc.  
No. 730 Expiry: April 30, 2007

B.M. ELEV.			
DESIGNED BY	AMA	CHECKED BY	PVL/AMA
DRAWN BY	DJP	APPROVED BY	AHL
SCALE:	N.T.S.	RELEASED FOR CONSTRUCTION BY:	R. SOROKOWSKI
NO. REVISIONS	DATE	DATE	DATE
01	792-2006 ADDENDUM 2	07/03/20	LJW
00	ISSUED FOR TENDER	07/01/31	DL
DATE	2006/09/11	DATE	2007/01/31

**CH2M HILL**  
Frederickson Cooper ARCHITECTS

**EarthTech**  
A Tech International Ltd. Company

ENGINEER'S SEAL  
ORIGINAL SIGNED BY  
A. M. AFTANAS  
2007/01/31  
CONSULTANT DRAWING NO.  
WS-H0512

**THE CITY OF WINNIPEG**  
WATER AND WASTE DEPARTMENT  
ENGINEERING DIVISION

WATER TREATMENT PLANT  
BULK CHEMICAL BUILDING  
SODIUM HYPOCHLORITE AND CHEMICAL STORAGE BUILDING

CITY FILE NUMBER  
SHEET OF  
CITY DRAWING NUMBER  
1-0608-G-H0512-001-01D

MECHANICAL  
PROCESS HOT WATER HEATING SCHEMATIC  
DOMESTIC HOT WATER HEATING SCHEMATIC