
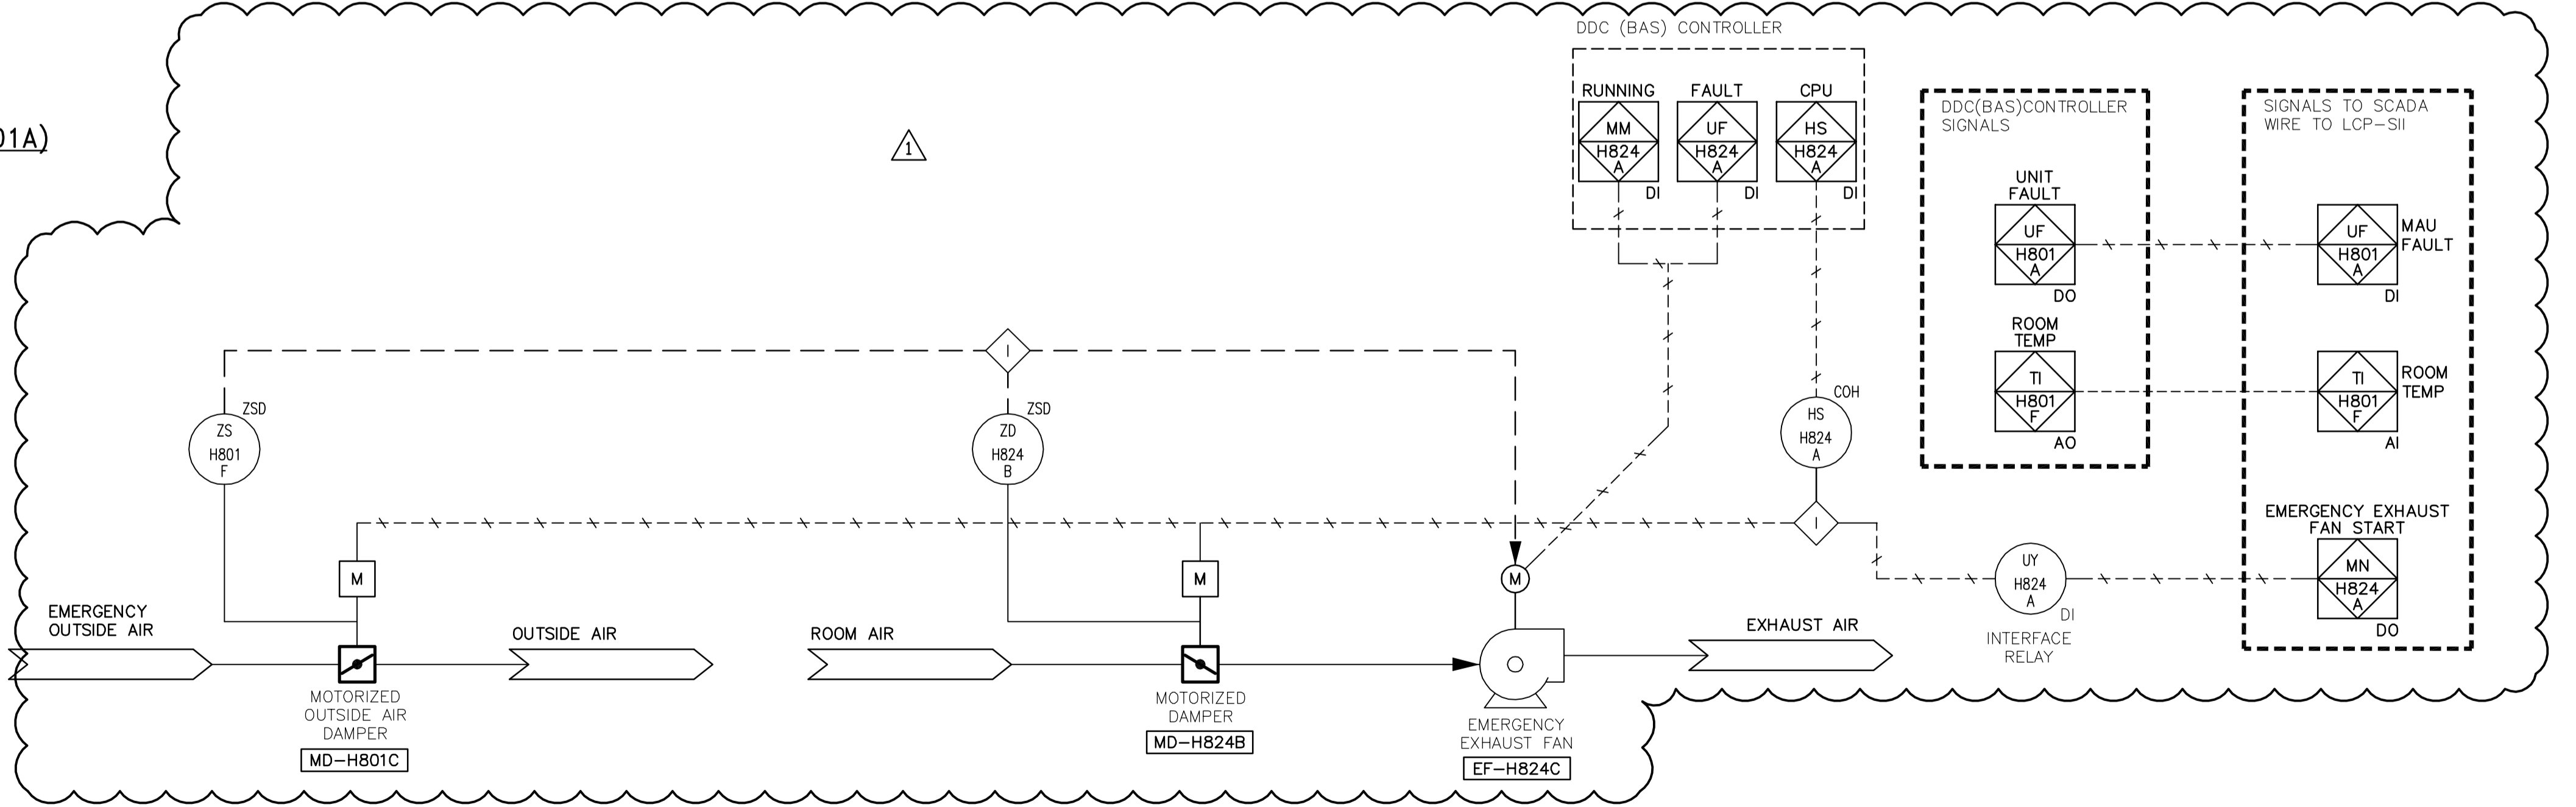


1 - N.T.S. SULPHURIC ACID ROOM HEATING AND VENTILATION SCHEMATIC (MAU-H801A)

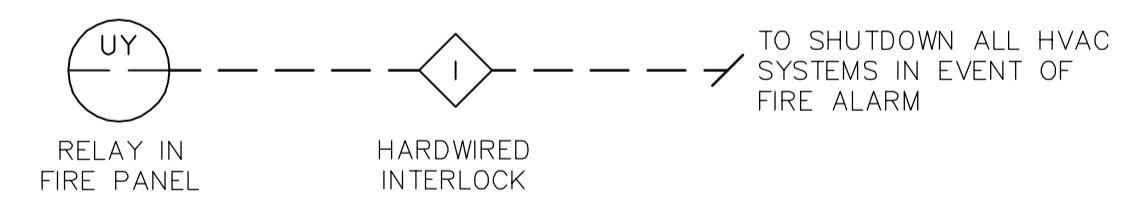

<p>Certificate of Authorization Earth Tech Canada Inc. No. 730 Expiry: April 30, 2007</p>	B.M. ELEV.	<p>Frederickson Cooper ARCHITECTS</p>	<p>A Tech International Ltd. Company</p>	ENGINEER'S SEAL	<p>WATER TREATMENT PLANT BULK CHEMICAL BUILDING SODIUM HYPOCHLORITE AND CHEMICAL STORAGE BUILDING</p>	CITY FILE NUMBER
	DESIGNED BY PVL/LJW			CHECKED BY PVL/AMA		ORIGINAL SIGNED BY A. M. AFTANAS
	DRAWN BY LJW	APPROVED BY AHL	2007/01/31	CITY DRAWING NUMBER		
	SCALE: N.T.S.	RELEASED FOR CONSTRUCTION BY: R. SOROKOWSKI	CONSULTANT DRAWING NO. WS-H0514	1-0608-G-H0514-001-01D		
01 792-2006 ADDENDUM 2 07/03/20 DJ	ISSUED FOR TENDER 07/01/31 DL	DATE 2006/09/11	DATE 2007/01/31	MECHANICAL SULPHURIC ACID ROOM HEATING AND VENTILATION SYSTEM SCHEMATIC		