
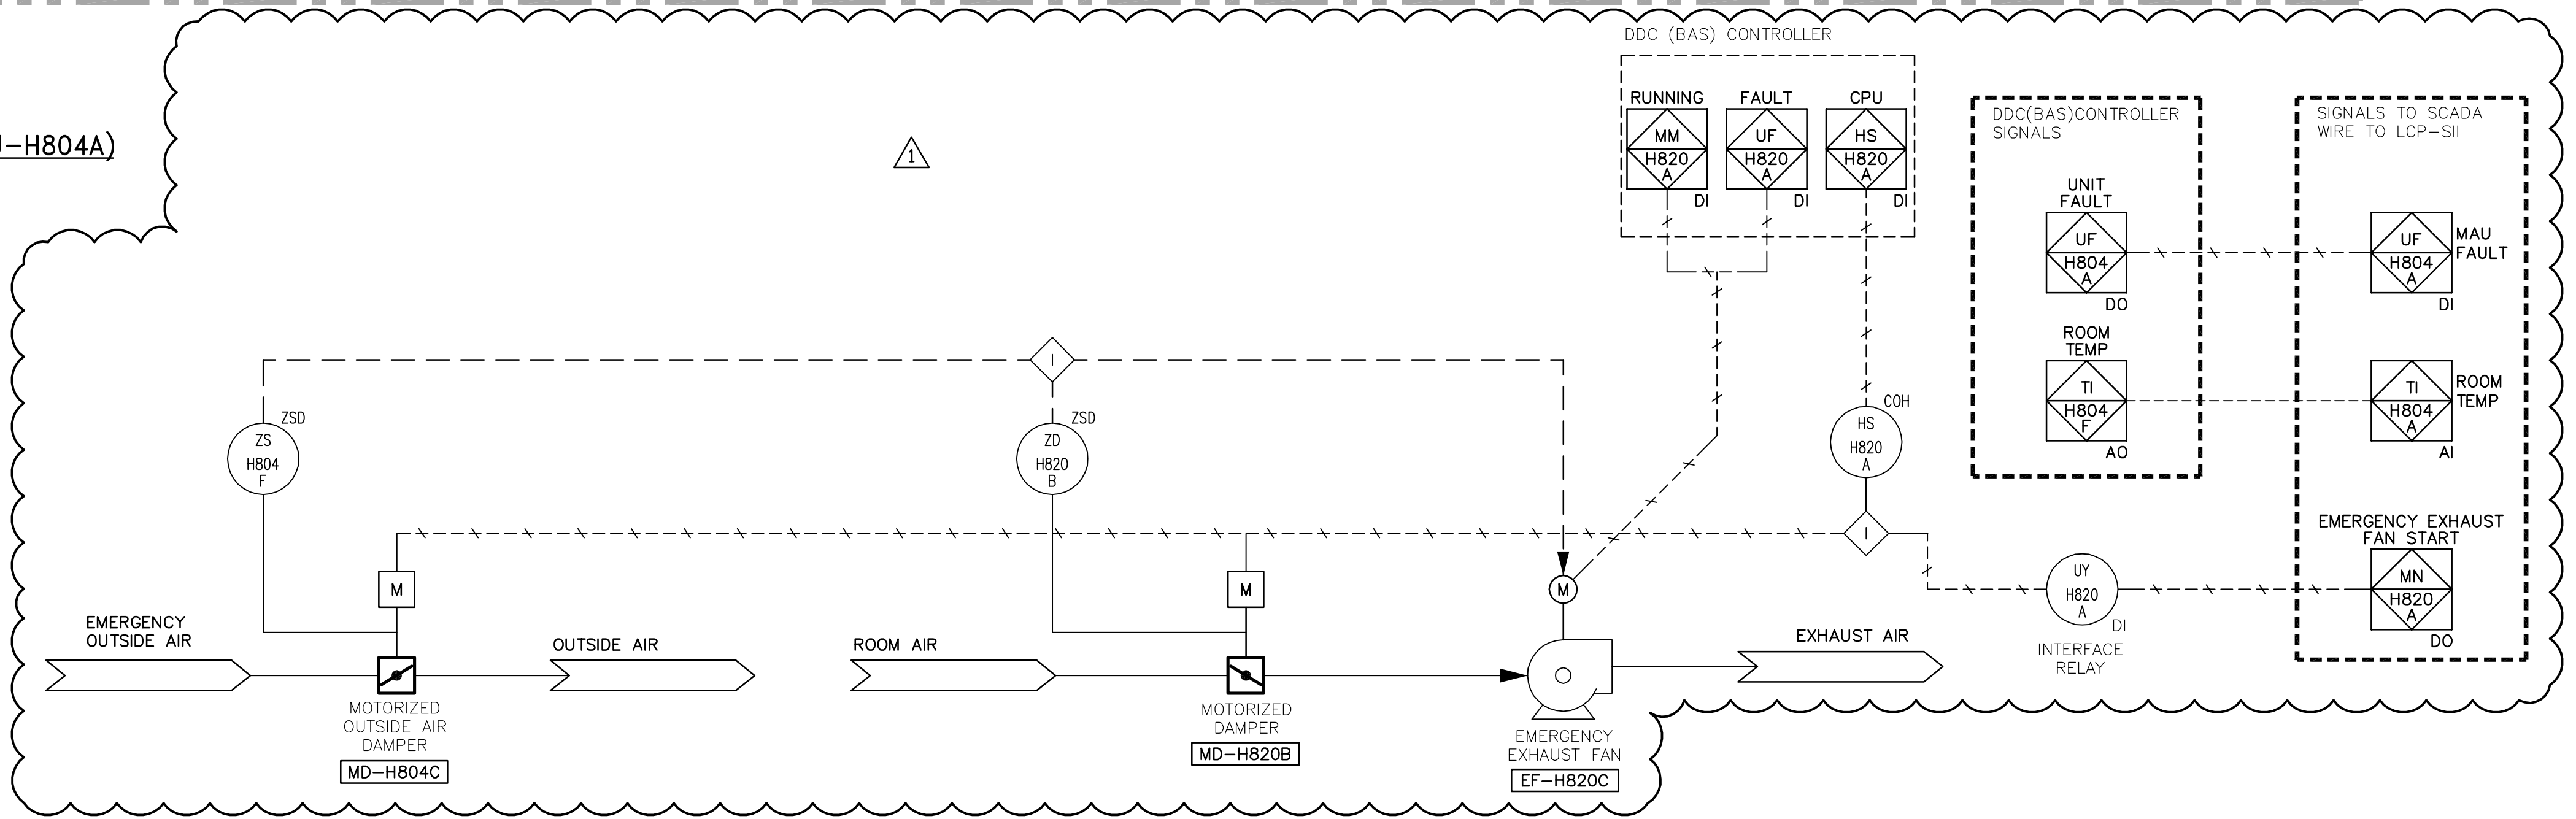


1 AQUA AMMONIA ROOM HEATING AND VENTILATION SCHEMATIC (MAU-H804A)
N.T.S.

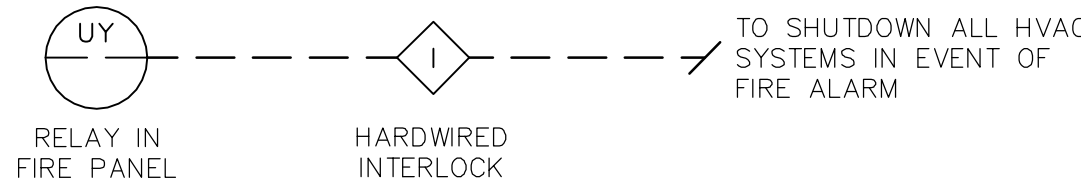

APECA
Certificate of Authorization
Earth Tech Canada Inc.
No. 730 Expiry: April 30, 2007

B.M. ELEV.			
DESIGNED BY	PVL/LJW	CHECKED BY	PVL/AMA
DRAWN BY	LJW	APPROVED BY	AHL
SCALE:	N.T.S.	RELEASED FOR CONSTRUCTION BY:	R. SOROKOWSKI
DATE	2006/09/11	DATE	2007/01/31

CH2M HILL
Frederickson Cooper ARCHITECTS
EarthTech
A Tyco International Ltd. Company

ENGINEER'S SEAL
ORIGINAL SIGNED BY
A. M. AFTANAS
2007/01/31
CONSULTANT DRAWING NO.
WS-H0516

THE CITY OF WINNIPEG
WATER AND WASTE DEPARTMENT
ENGINEERING DIVISION
WATER TREATMENT PLANT
BULK CHEMICAL BUILDING
SODIUM HYPOCHLORITE AND CHEMICAL STORAGE BUILDING
MECHANICAL
AQUA AMMONIA ROOM
HEATING AND VENTILATION SYSTEM SCHEMATIC

CITY FILE NUMBER
SHEET OF
CITY DRAWING NUMBER
1-0608-G-H0516-001-0D