



1 LOUVER HEAT TRACING  
- N.T.S.

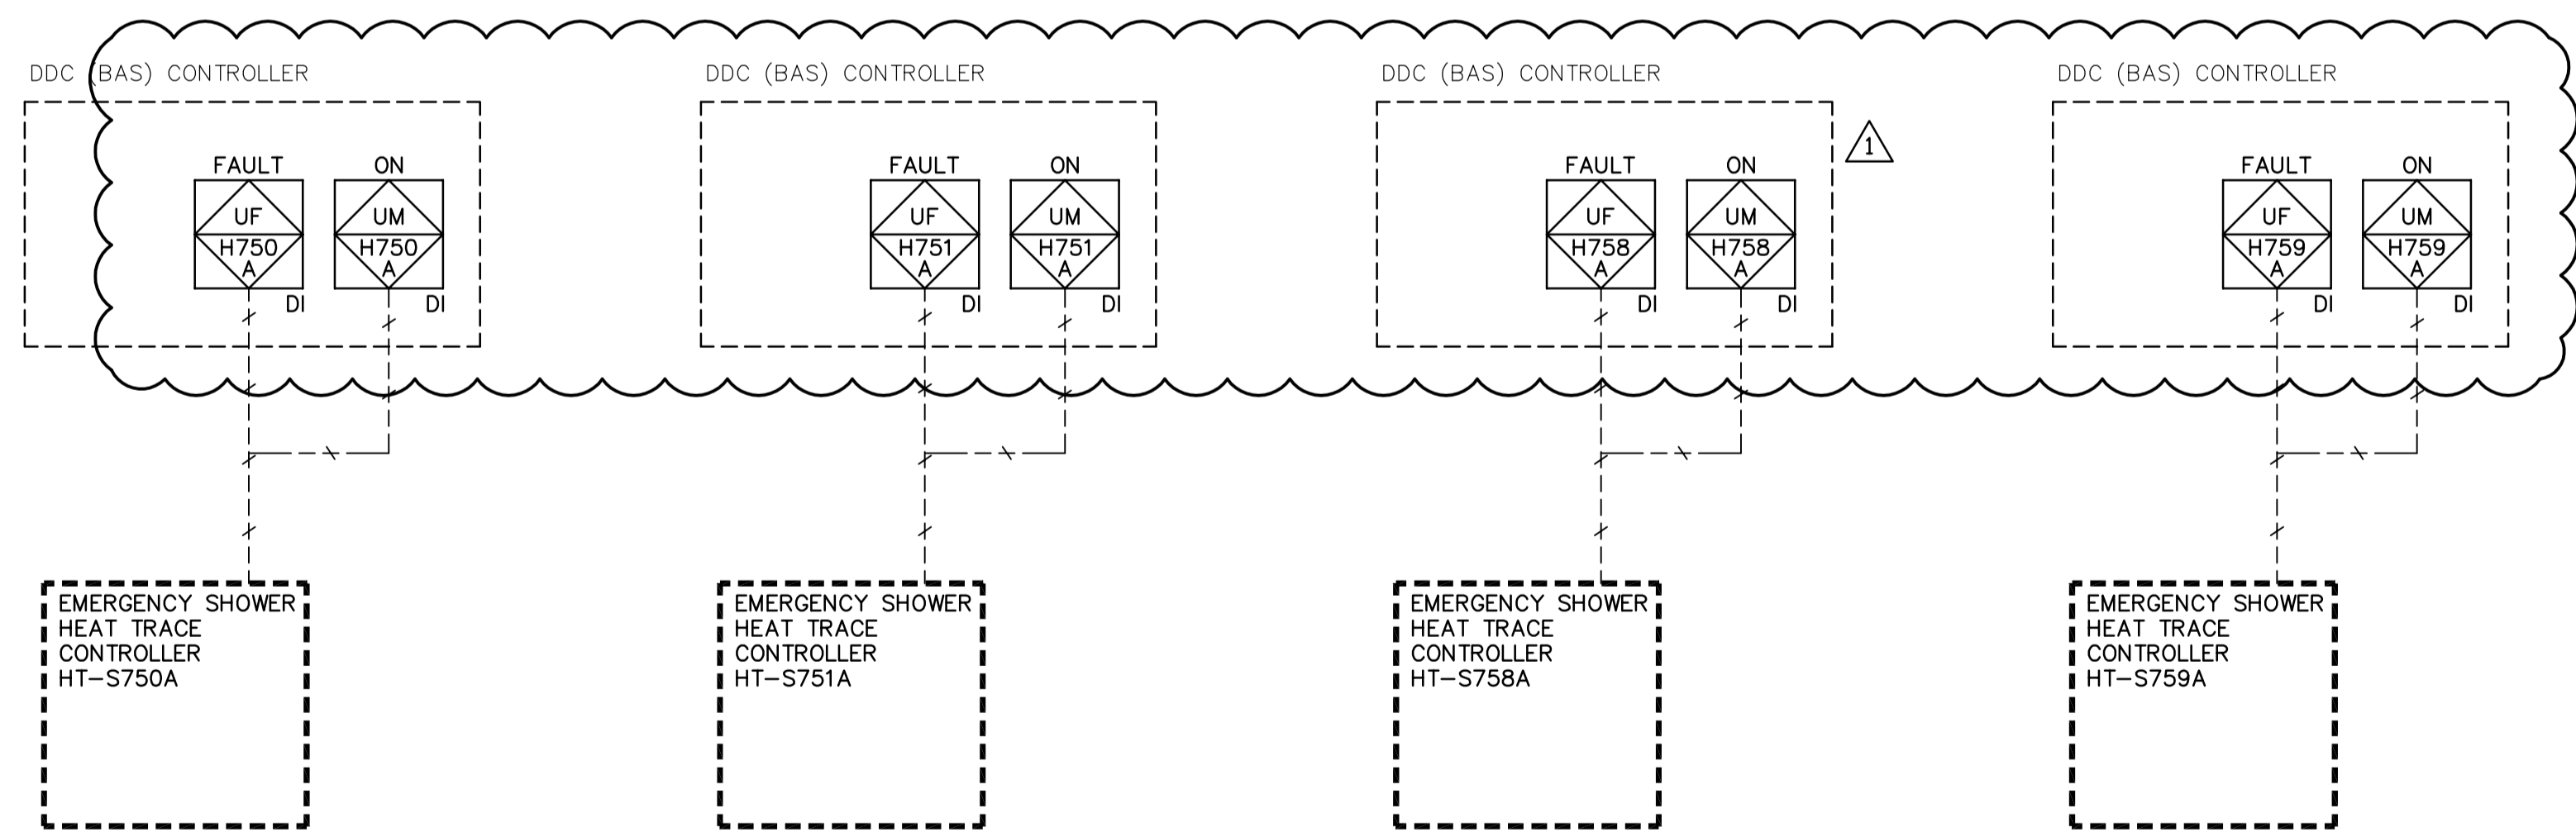

2 EMERGENCY SHOWER HEAT TRACING  
- N.T.S.

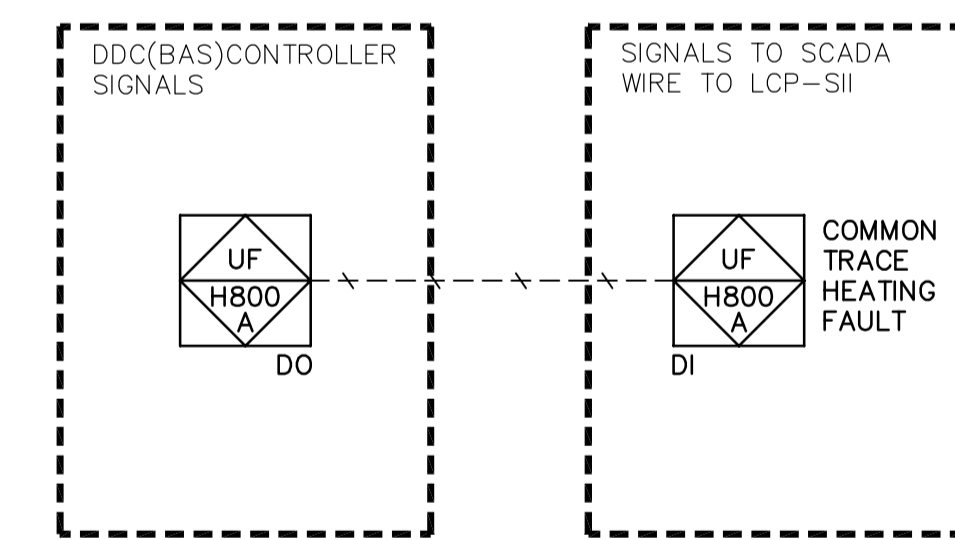

**GENERAL NOTES**

- HEAT TRACING APPLIED TO PIPEWORK SHALL BE CIRCUMFERENTIALLY AROUND THE PIPEWORK FOR THE REQUIRED LENGTH, CREATING A 200mm HELICAL PITCH.
- HEAT TRACING APPLIED TO INTAKE LOUVERS SHALL BE LOOPED BEHIND EACH BLADE.

|  |                                    |                                       |                                       |                 |   |   |                                   |
|--|------------------------------------|---------------------------------------|---------------------------------------|-----------------|---|---|-----------------------------------|
| <br>Certificate of Authorization<br>Earth Tech Canada Inc.<br>No. 730 Expiry: April 30, 2007 | B.M.<br>ELEV.                      | <br>Frederickson Cooper<br>ARCHITECTS | <br>A Type International Ltd. Company | ENGINEER'S SEAL | <br><b>THE CITY OF WINNIPEG</b><br>WATER AND WASTE DEPARTMENT<br>ENGINEERING DIVISION |   |                                   |
|  |                                    |                                       |                                       | DESIGNED BY: GD |   | CHECKED BY: PVL/AMA                         | ORIGINAL SIGNED BY: A. M. AFTANAS |
|  |                                    |                                       |                                       | DRAWN BY: DL    |   | APPROVED BY: AHL                            | 2007/01/31                        |
|  |                                    |                                       |                                       | SCALE: N.T.S.   |   | RELEASED FOR CONSTRUCTION BY: R. SOROKOWSKI | CONSULTANT DRAWING NO. WS-H0520   |
|  | 01 792-2006 ADDENDUM 2 07/03/20 DJ |                                       |                                       |                 | CITY FILE NUMBER  |   |                                   |
|  | 00 ISSUED FOR TENDER 07/01/31 DL   |                                       |                                       |                 | SHEET OF  |   |                                   |
|  | NO. REVISIONS DATE BY              | DATE 2007/01/26                       | DATE 2007/01/31                       |                 | CITY DRAWING NUMBER   |   |                                   |
|  |                                    |                                       |                                       |                 | 1-0601S-G-H0520-001-010   |   |                                   |