


**STEAM BOILER FEED PUMP P-S706A**

TYPICAL FOR P-S707A

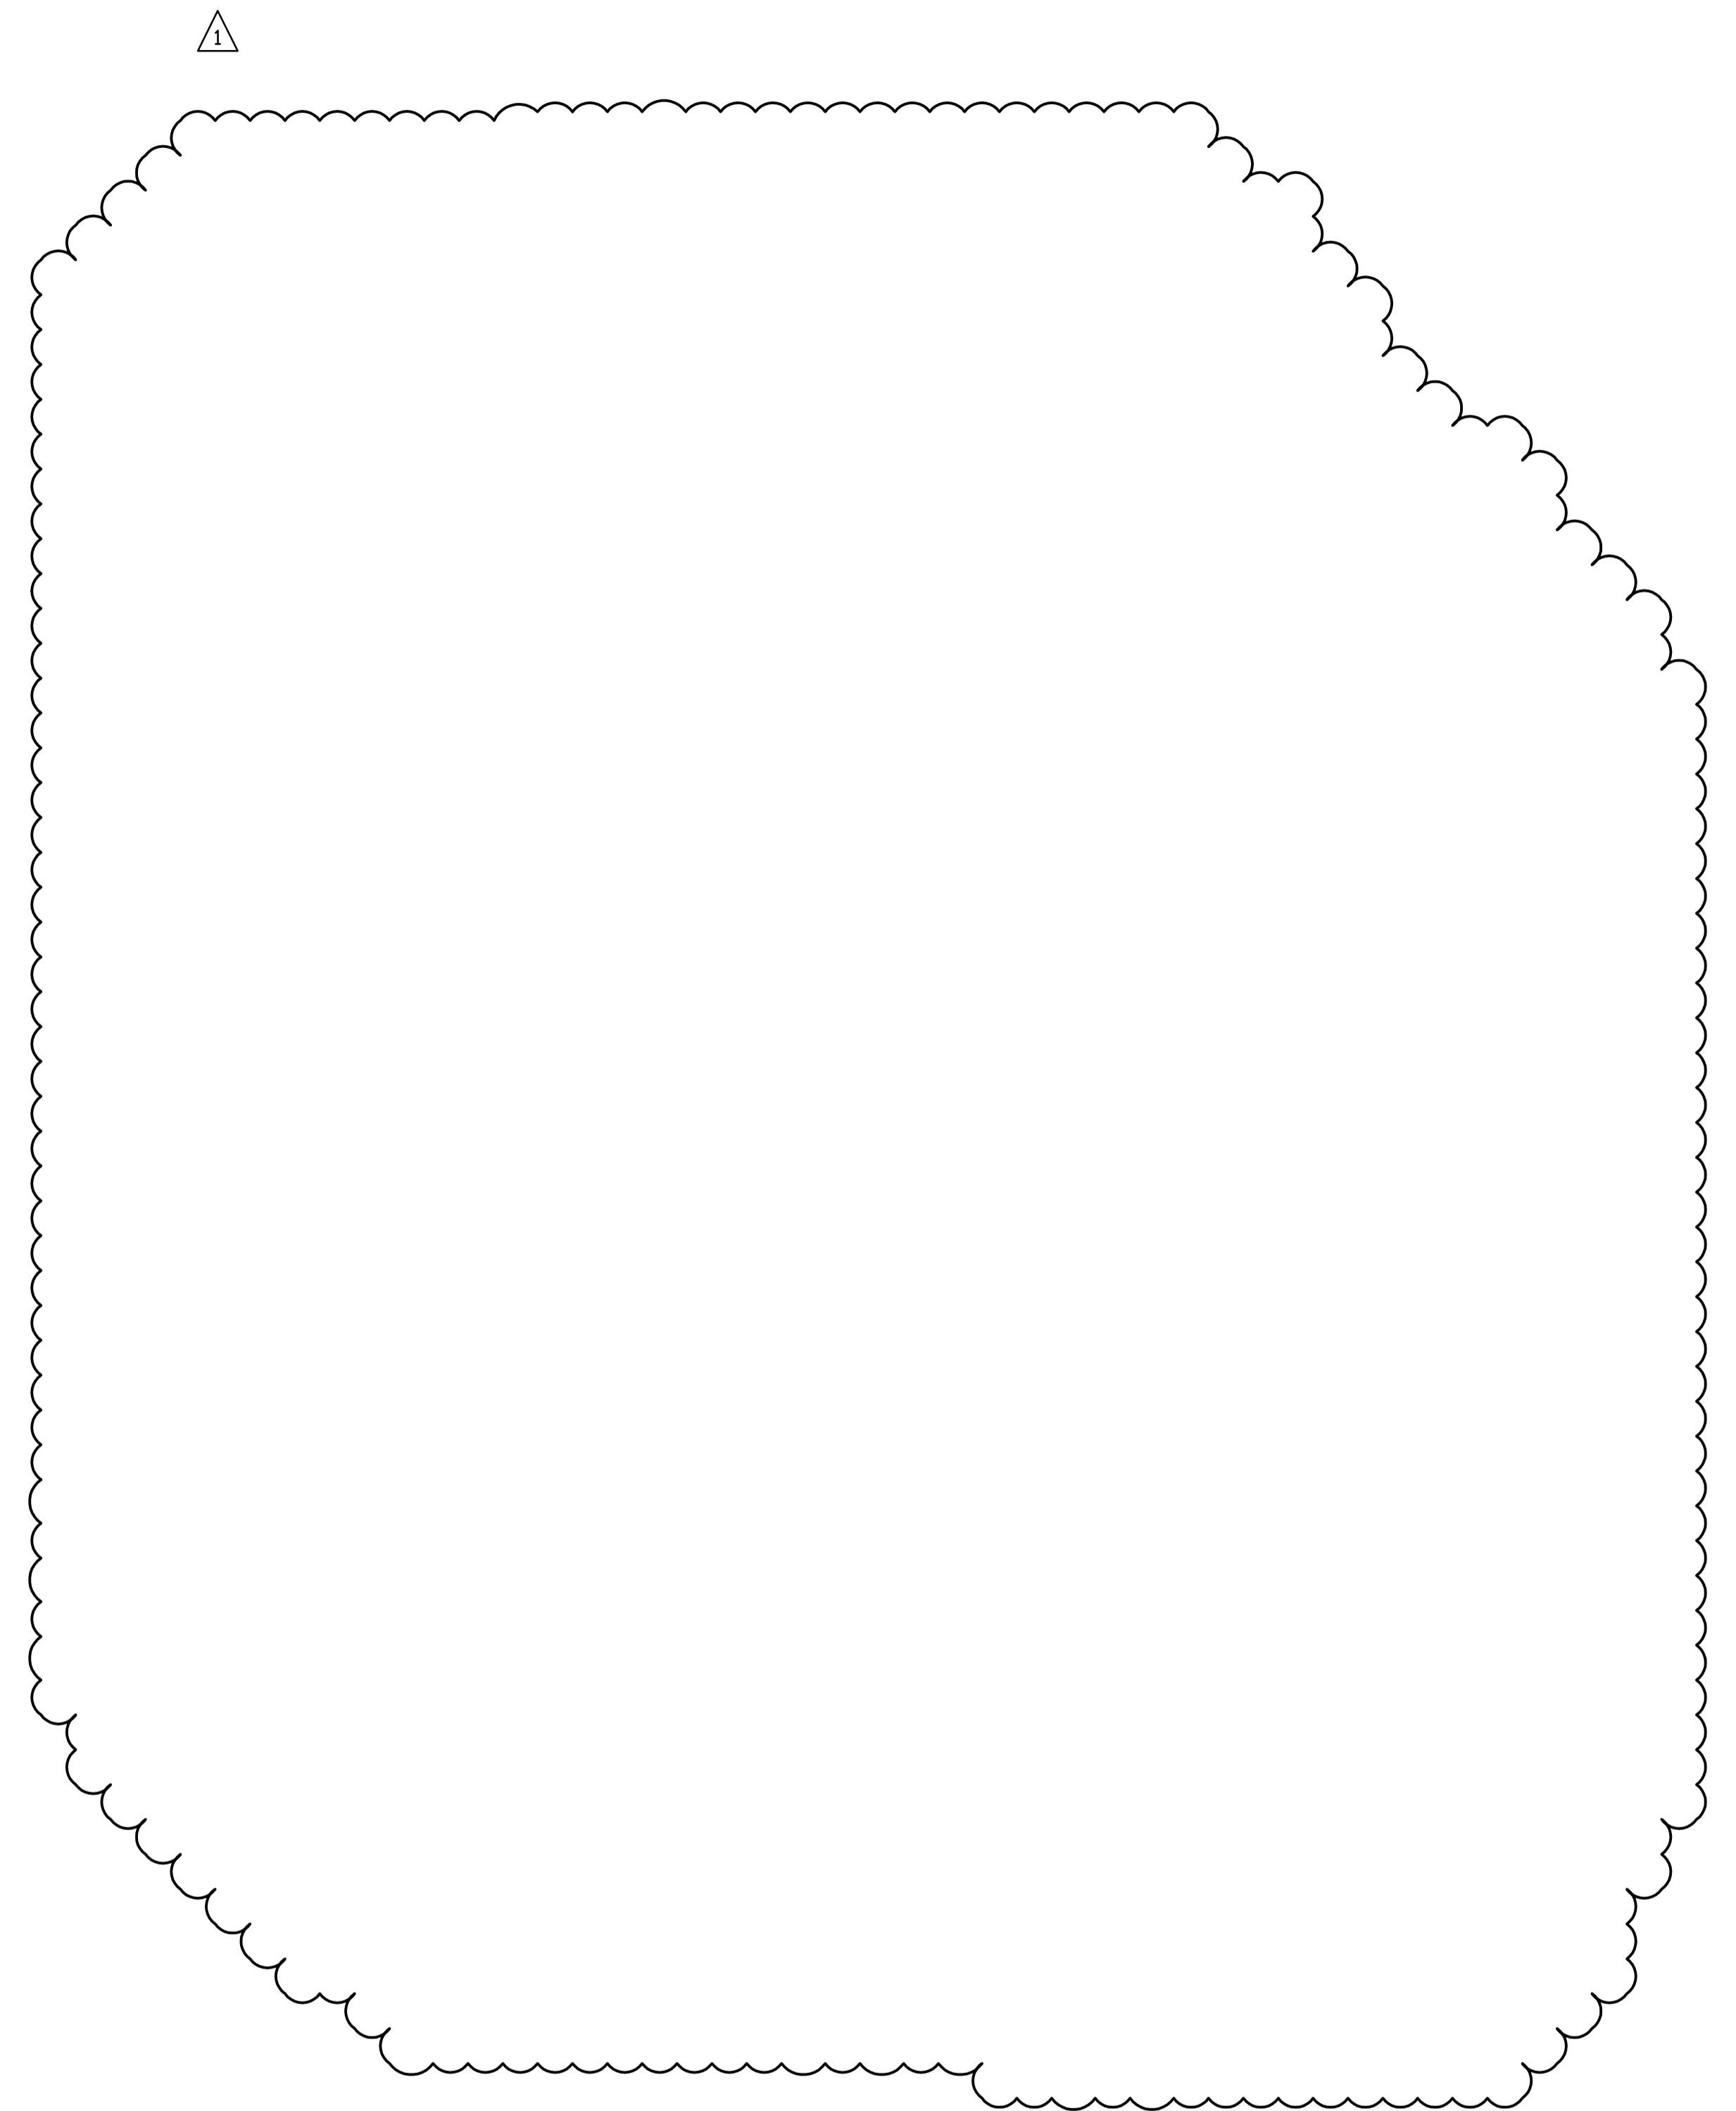

<p><b>APEGM</b> Certificate of Authorization Earth Tech Canada Inc. No. 730 Expiry: April 30, 2007</p>	B.M. ELEV.	<p>Frederickson Cooper ARCHITECTS</p>	<p>EarthTech A Tyco International Ltd. Company</p>	ENGINEER'S SEAL	<p><b>THE CITY OF WINNIPEG</b> WATER AND WASTE DEPARTMENT ENGINEERING DIVISION</p>		
				DESIGNED BY: BLM		CHECKED BY: PS	ORIGINAL SIGNED BY: P. STRYK
				DRAWN BY: ERC		APPROVED BY: AHL	2007/01/31
				SCALE: NTS		RELEASED FOR CONSTRUCTION BY: R. SOROKOWSKI	CONSULTANT DRAWING NO. WS-E0513
	01 792-2006 ADDENDUM 2 07/03/21 ERC				CITY FILE NUMBER		
	00 ISSUED FOR TENDER 07/01/31 ERC				SHEET OF		
	NO. REVISIONS DATE BY	DATE 2007/01/15	DATE 2007/01/31		CITY DRAWING NUMBER		
					1-0601S-H-E0513-001-010		