




4 SOUTH ELEVATION
WJ-B0403 1:30

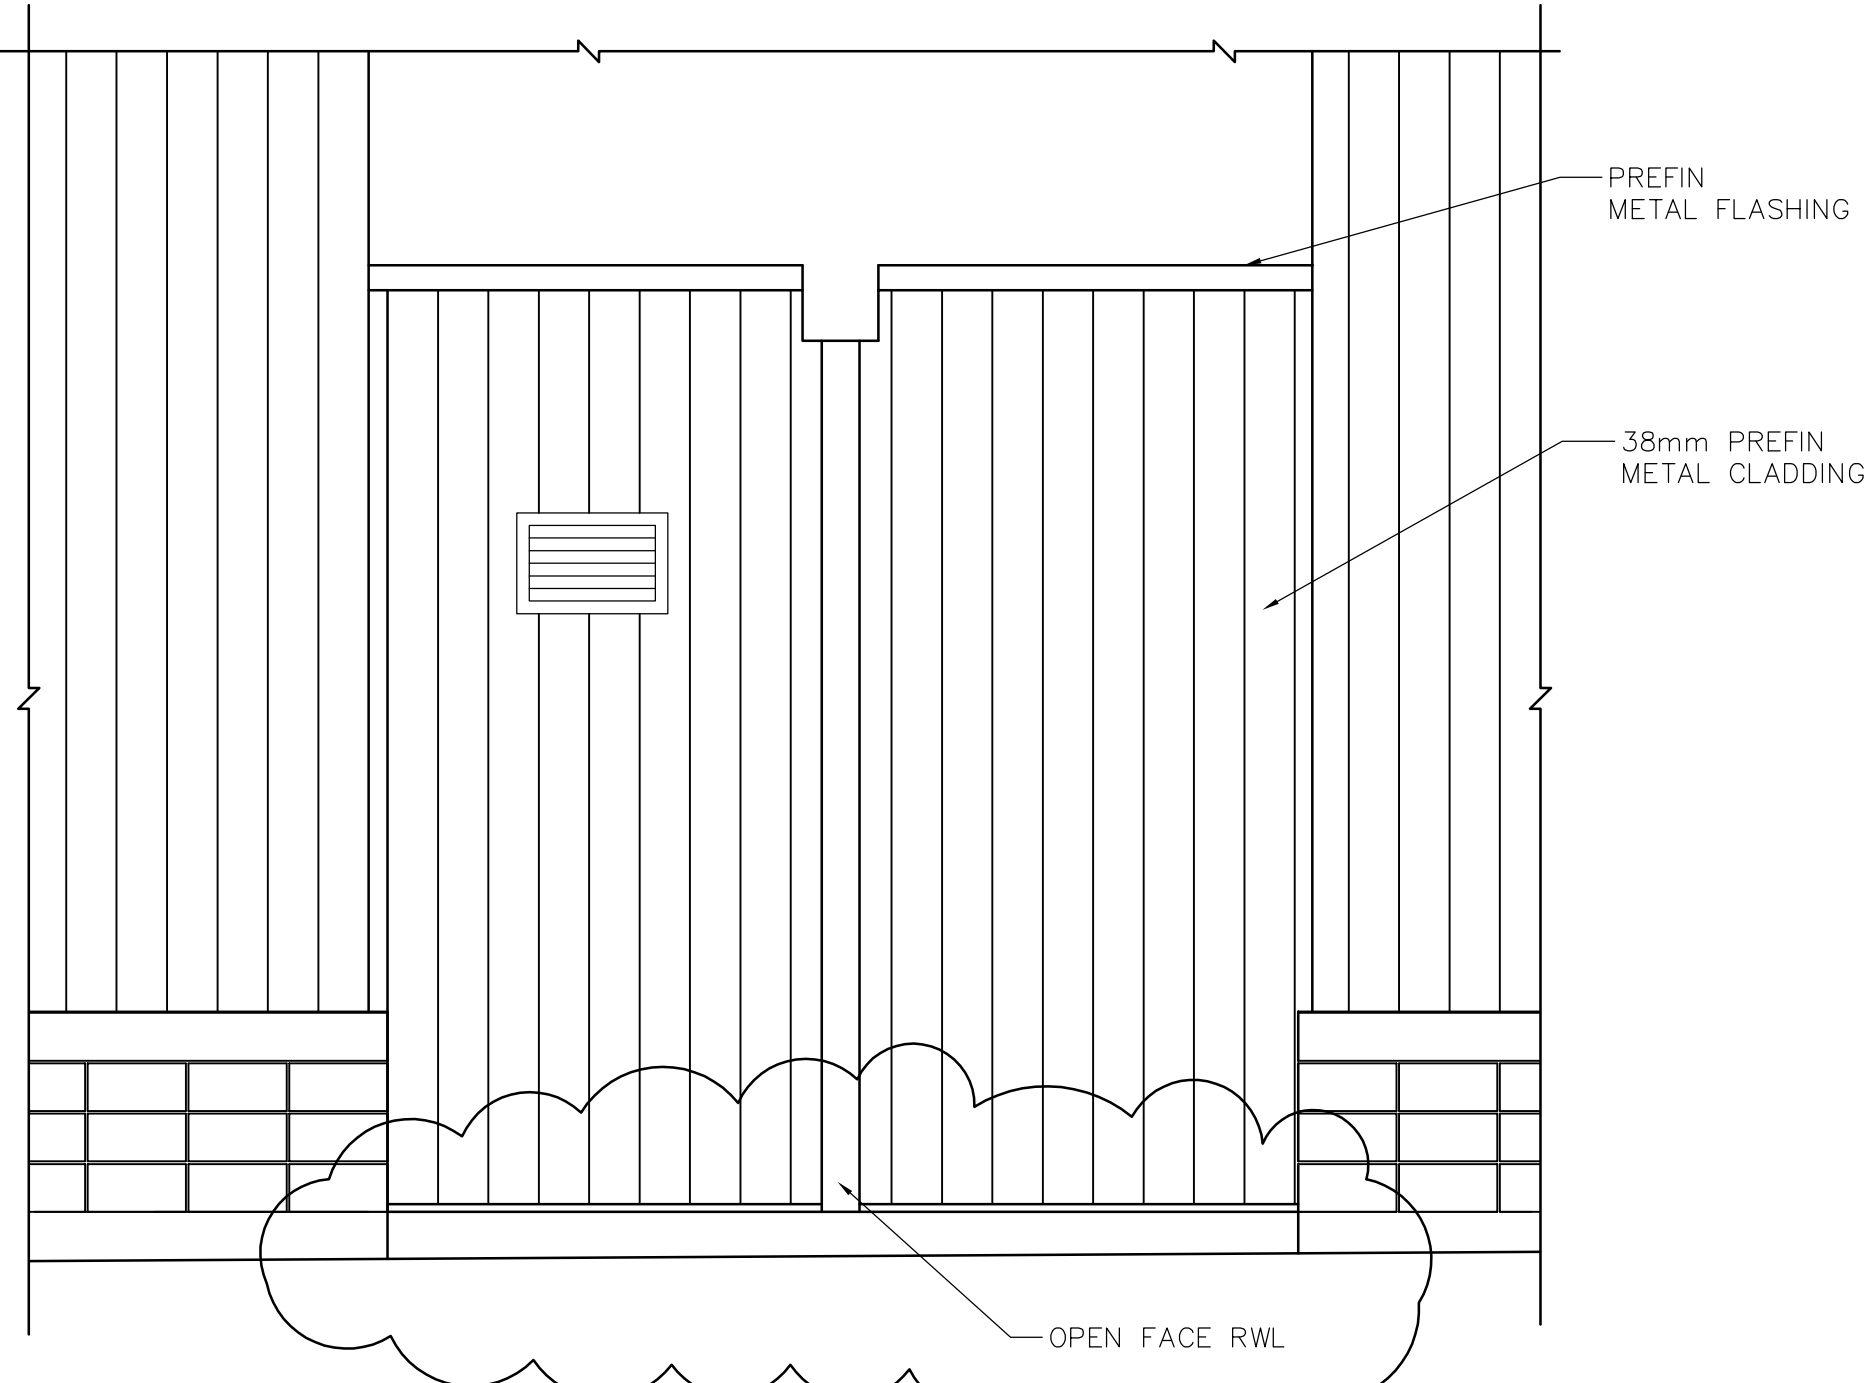


5 NORTH ELEVATION
WJ-B0403 1:30

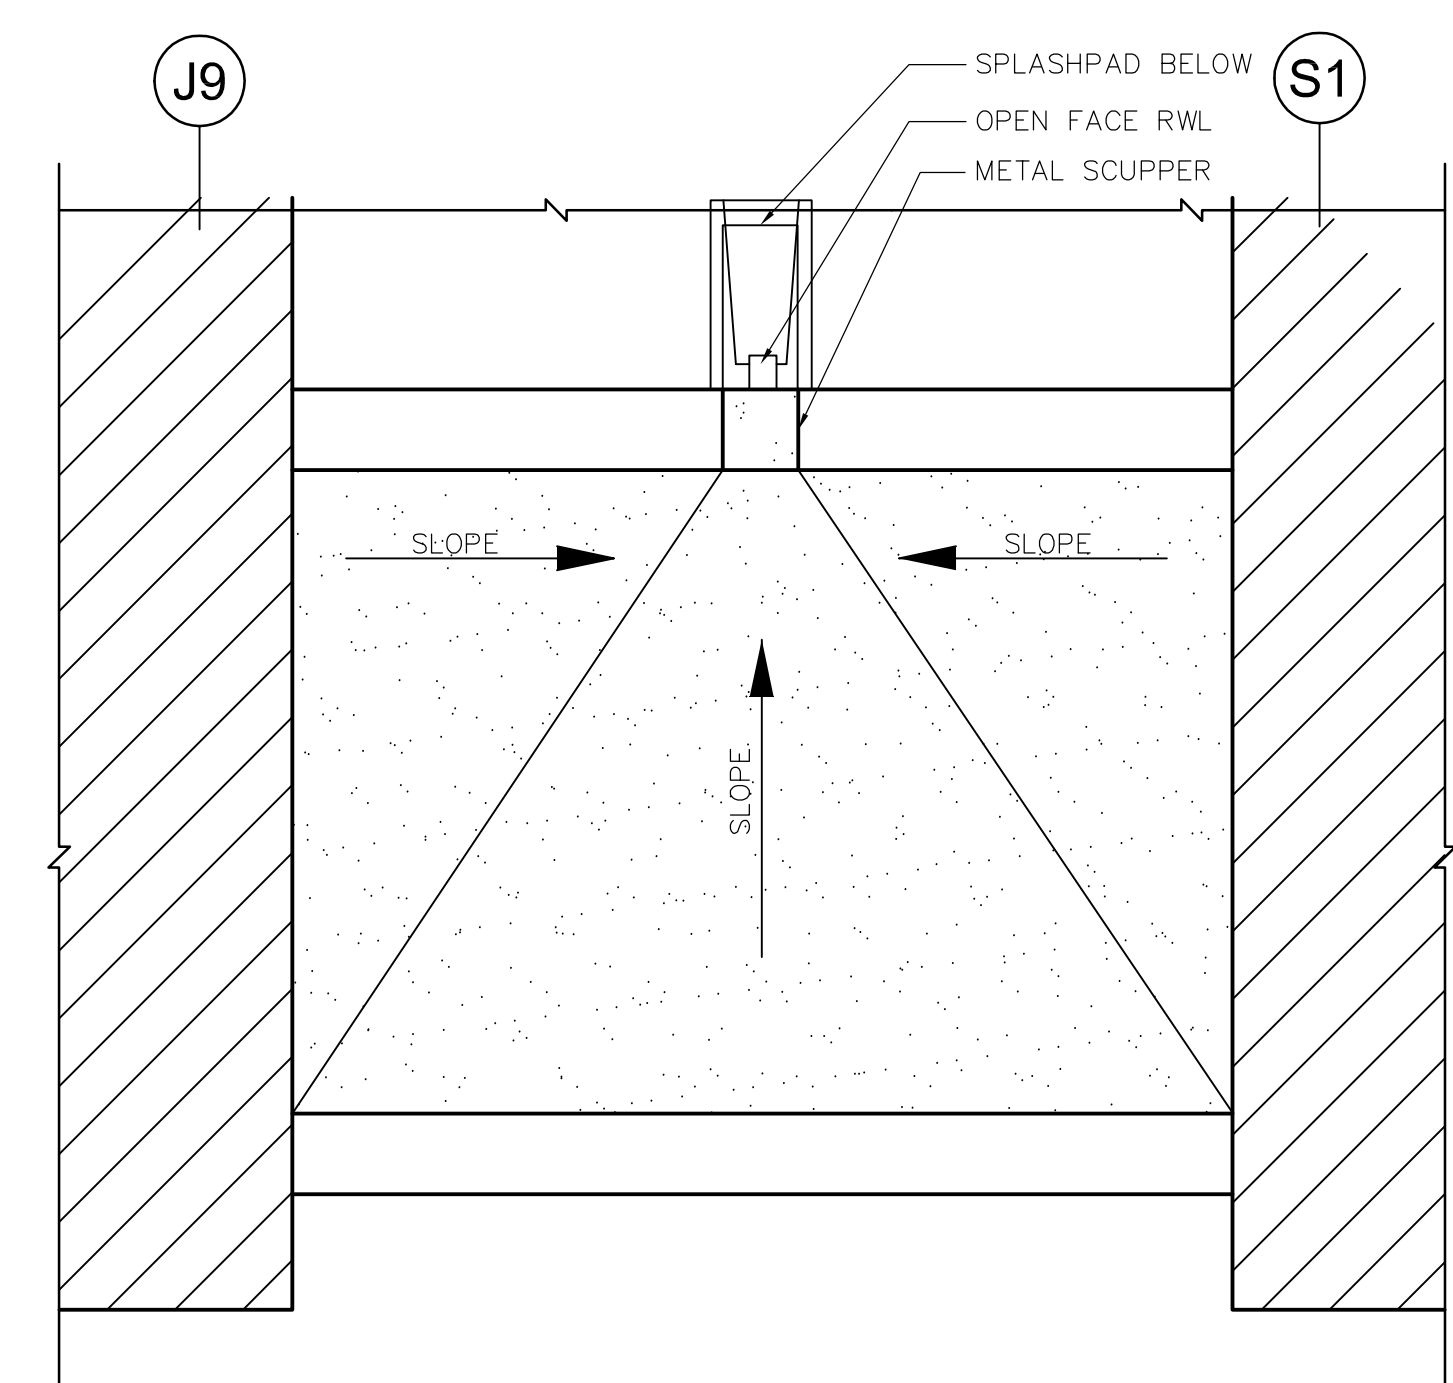


6 ROOF PLAN
WJ-B0403 1:30

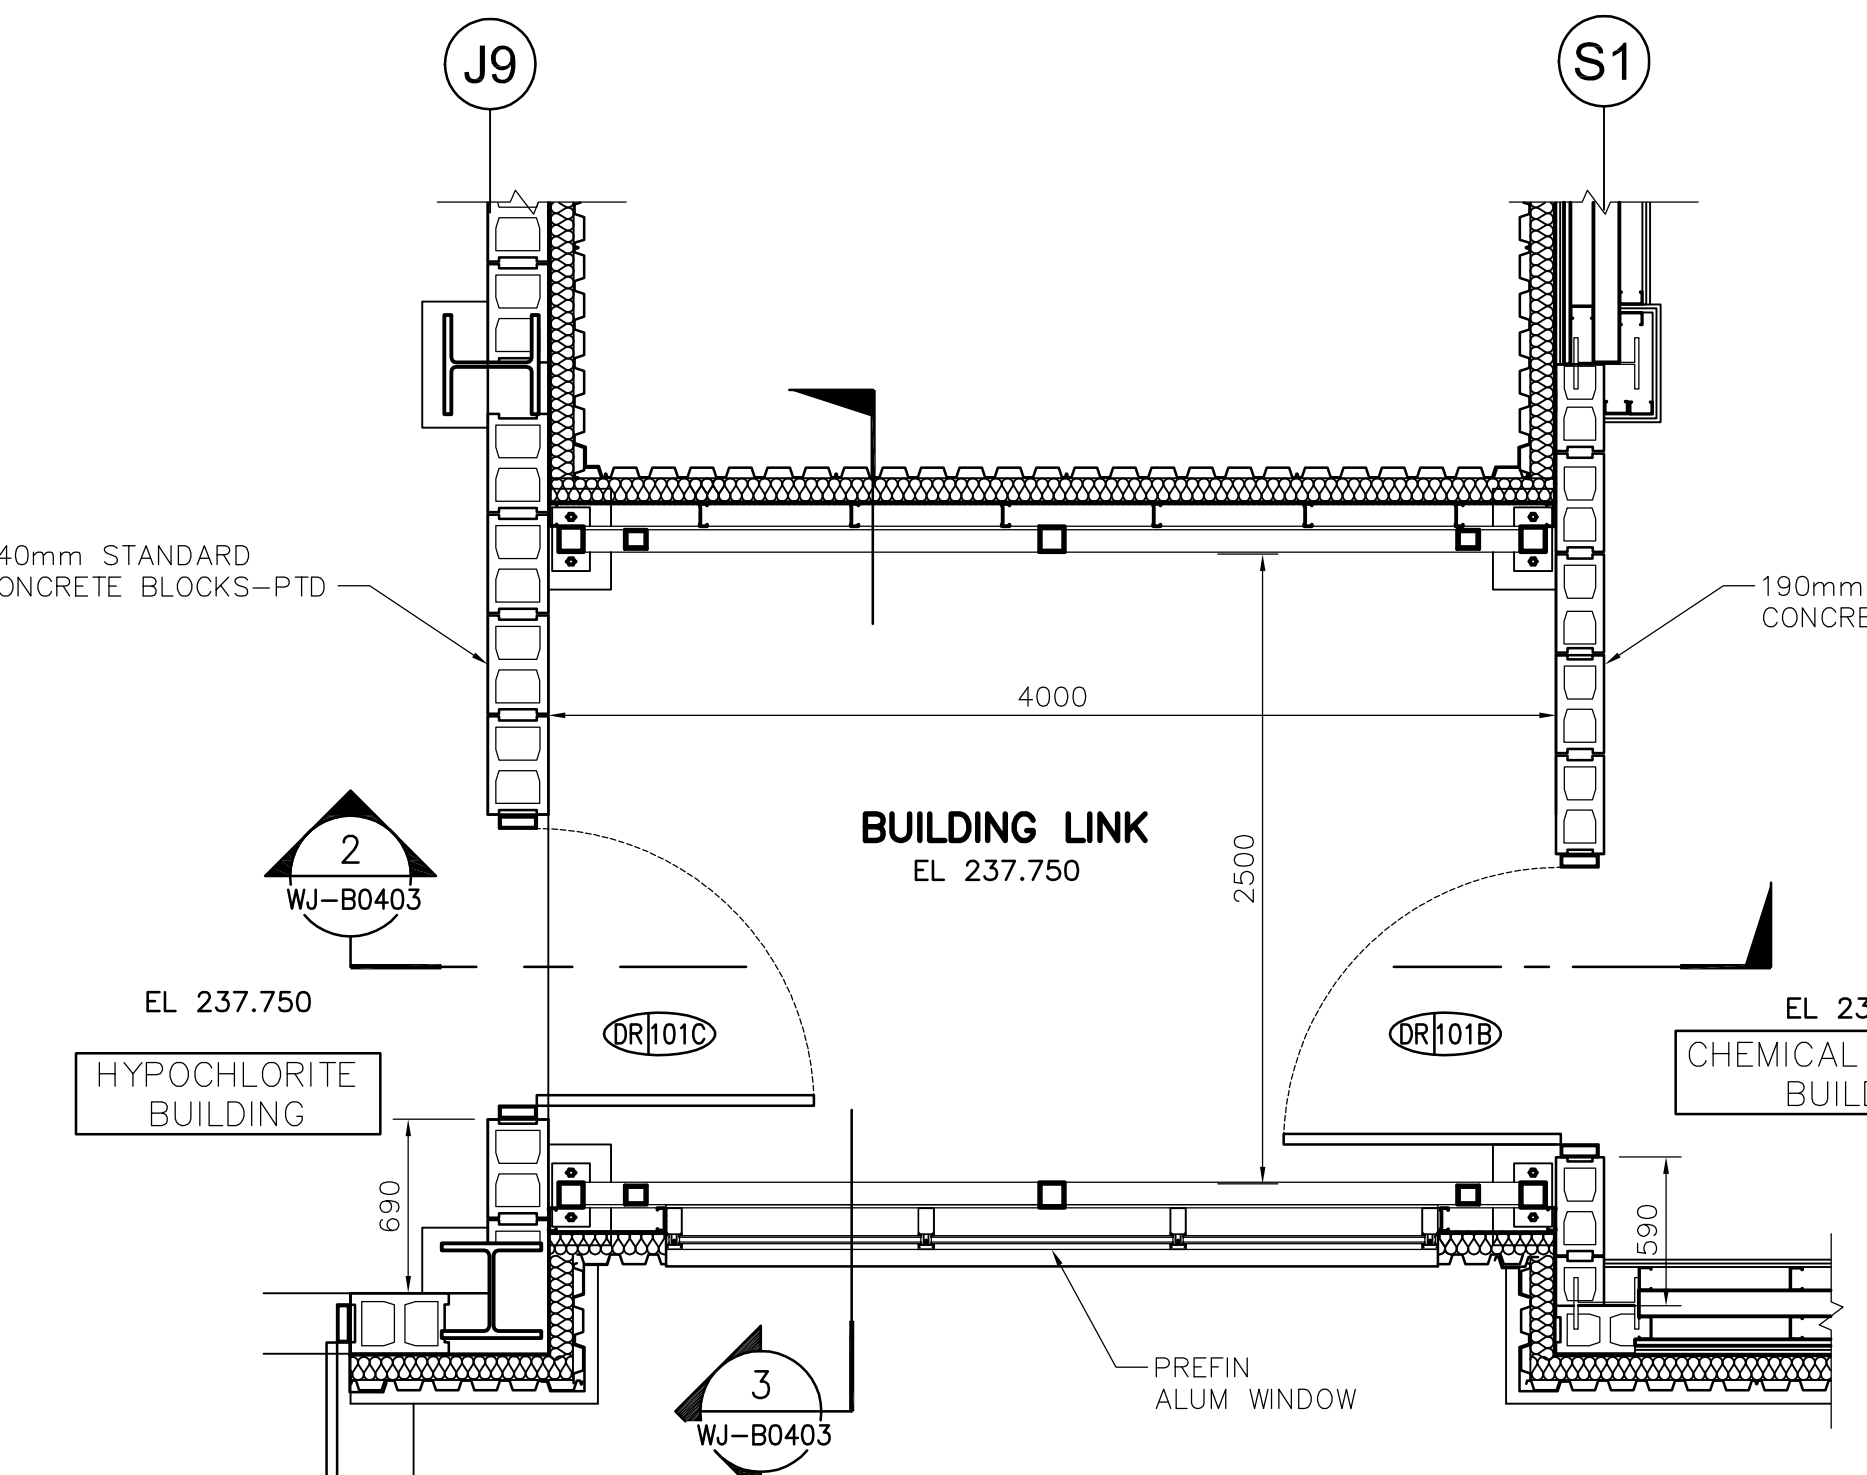

1 FLOOR PLAN
WJ-B0403 1:30

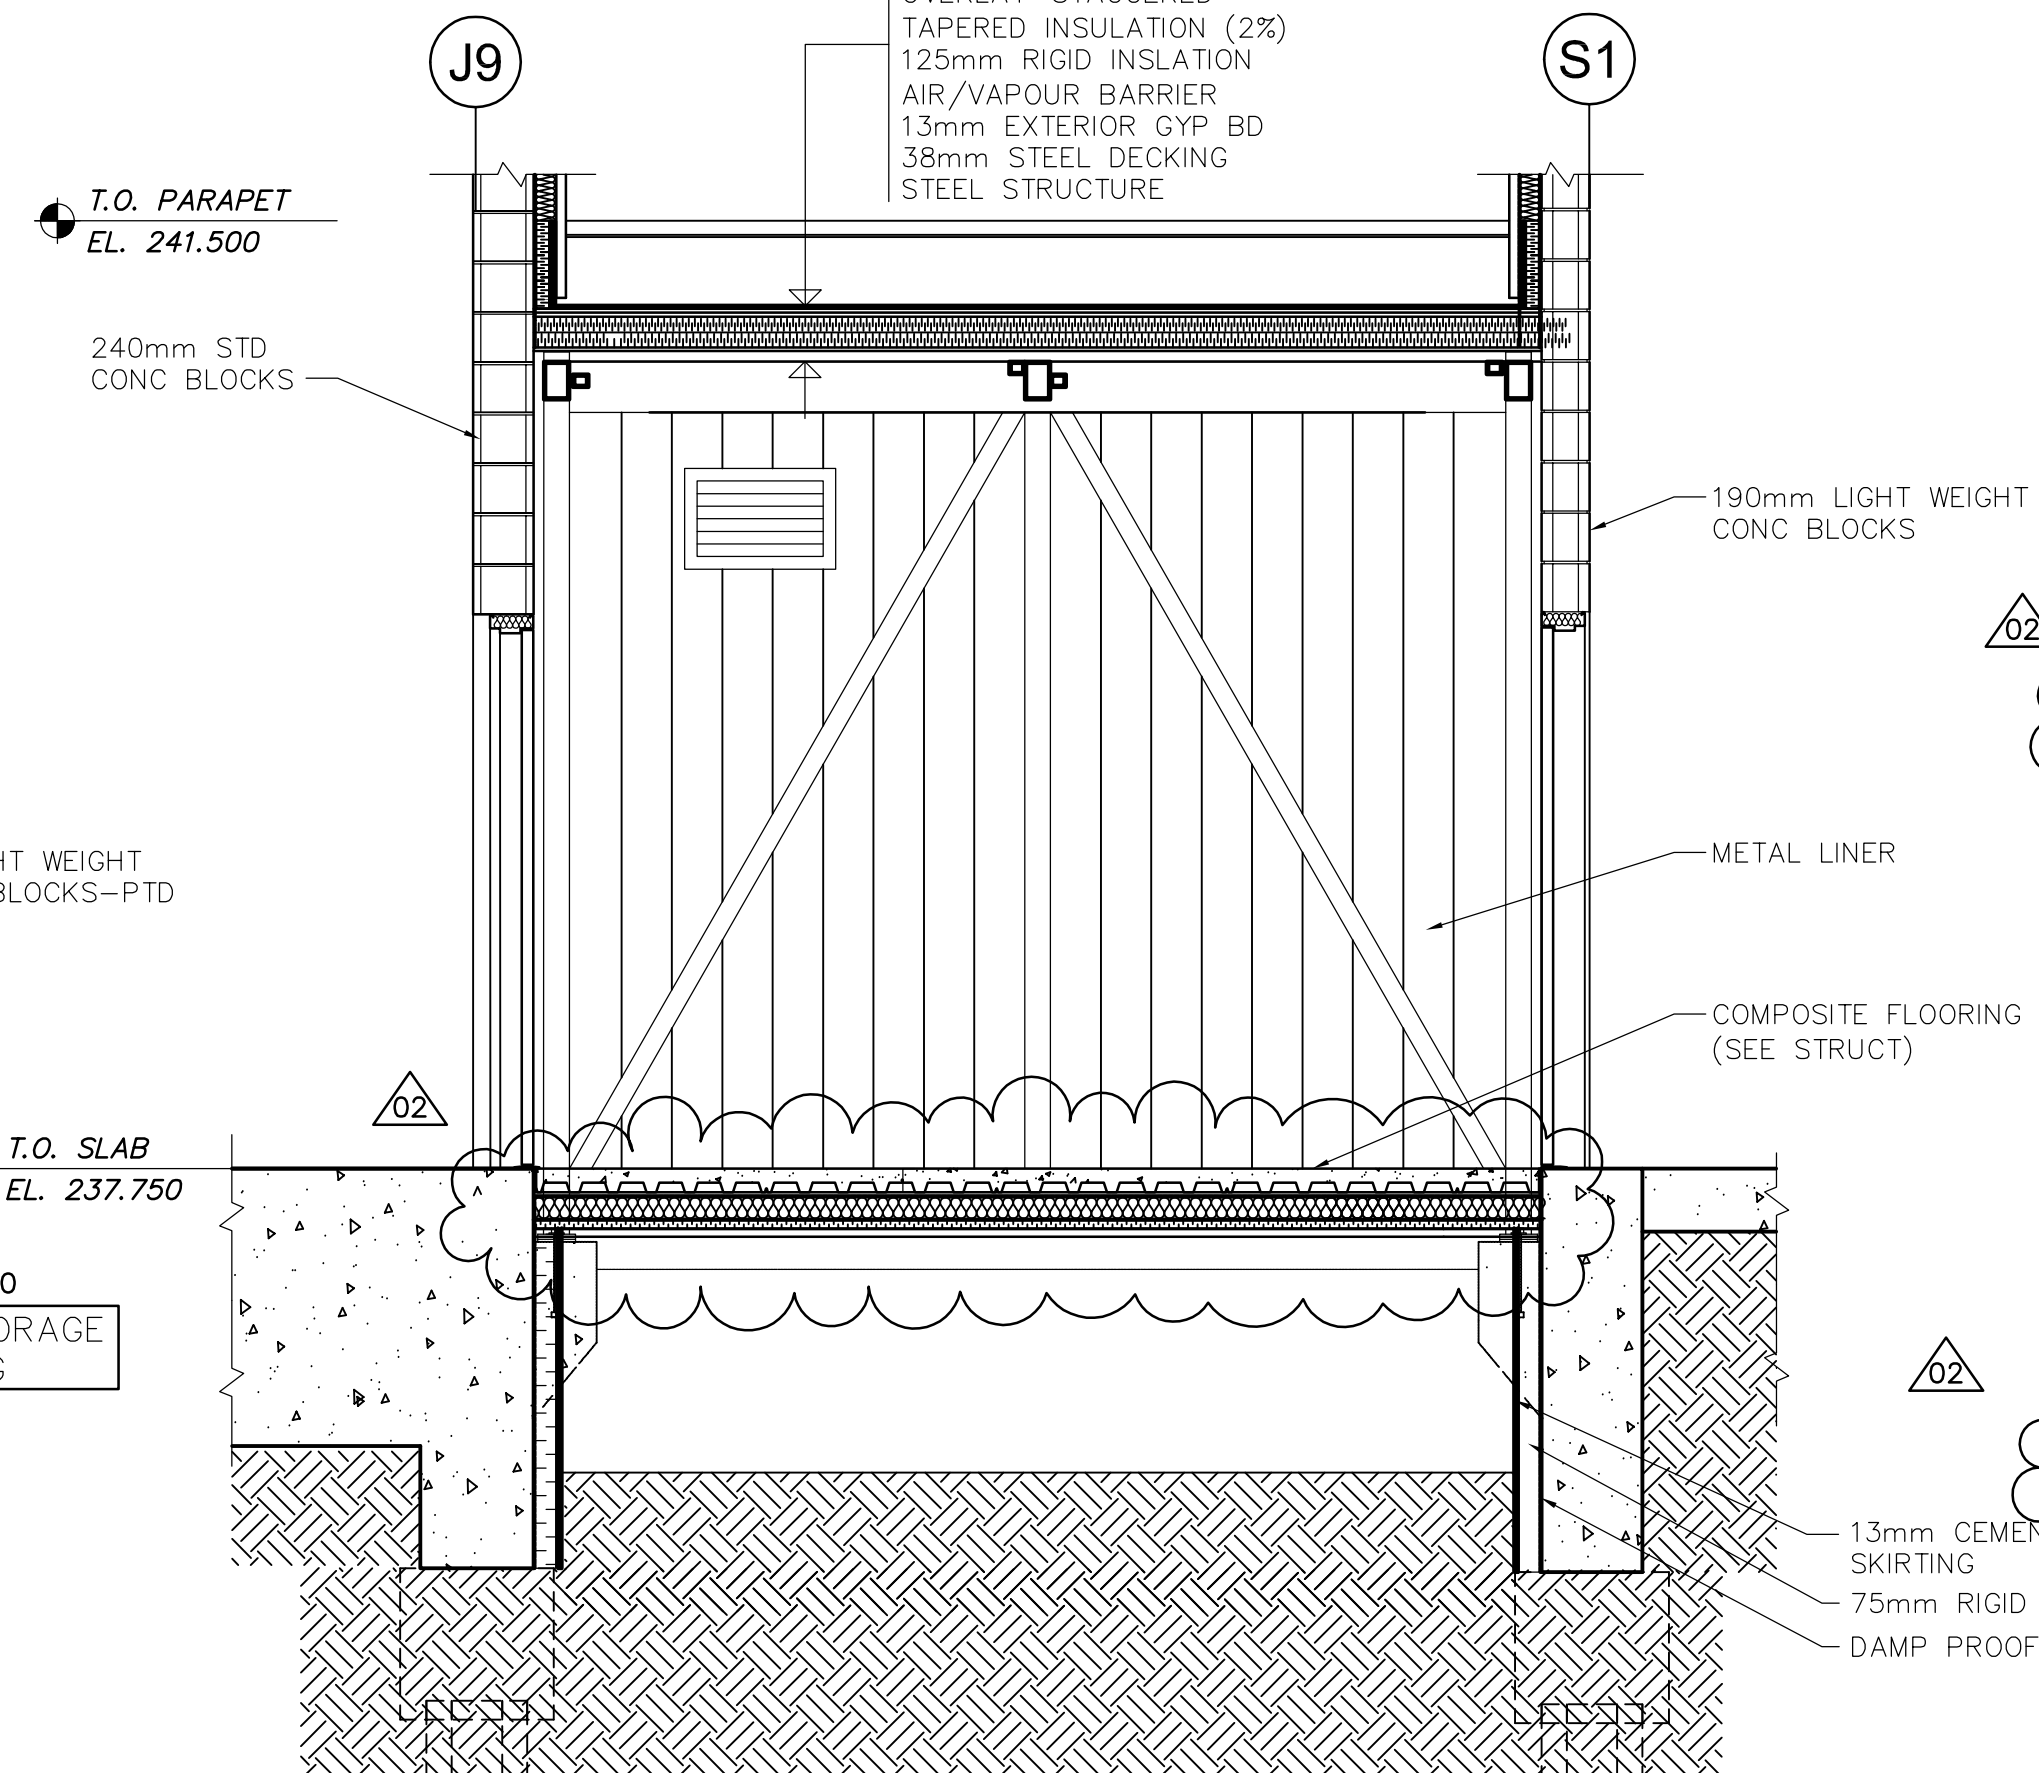

2 SECTION A
WJ-B0403 1:30

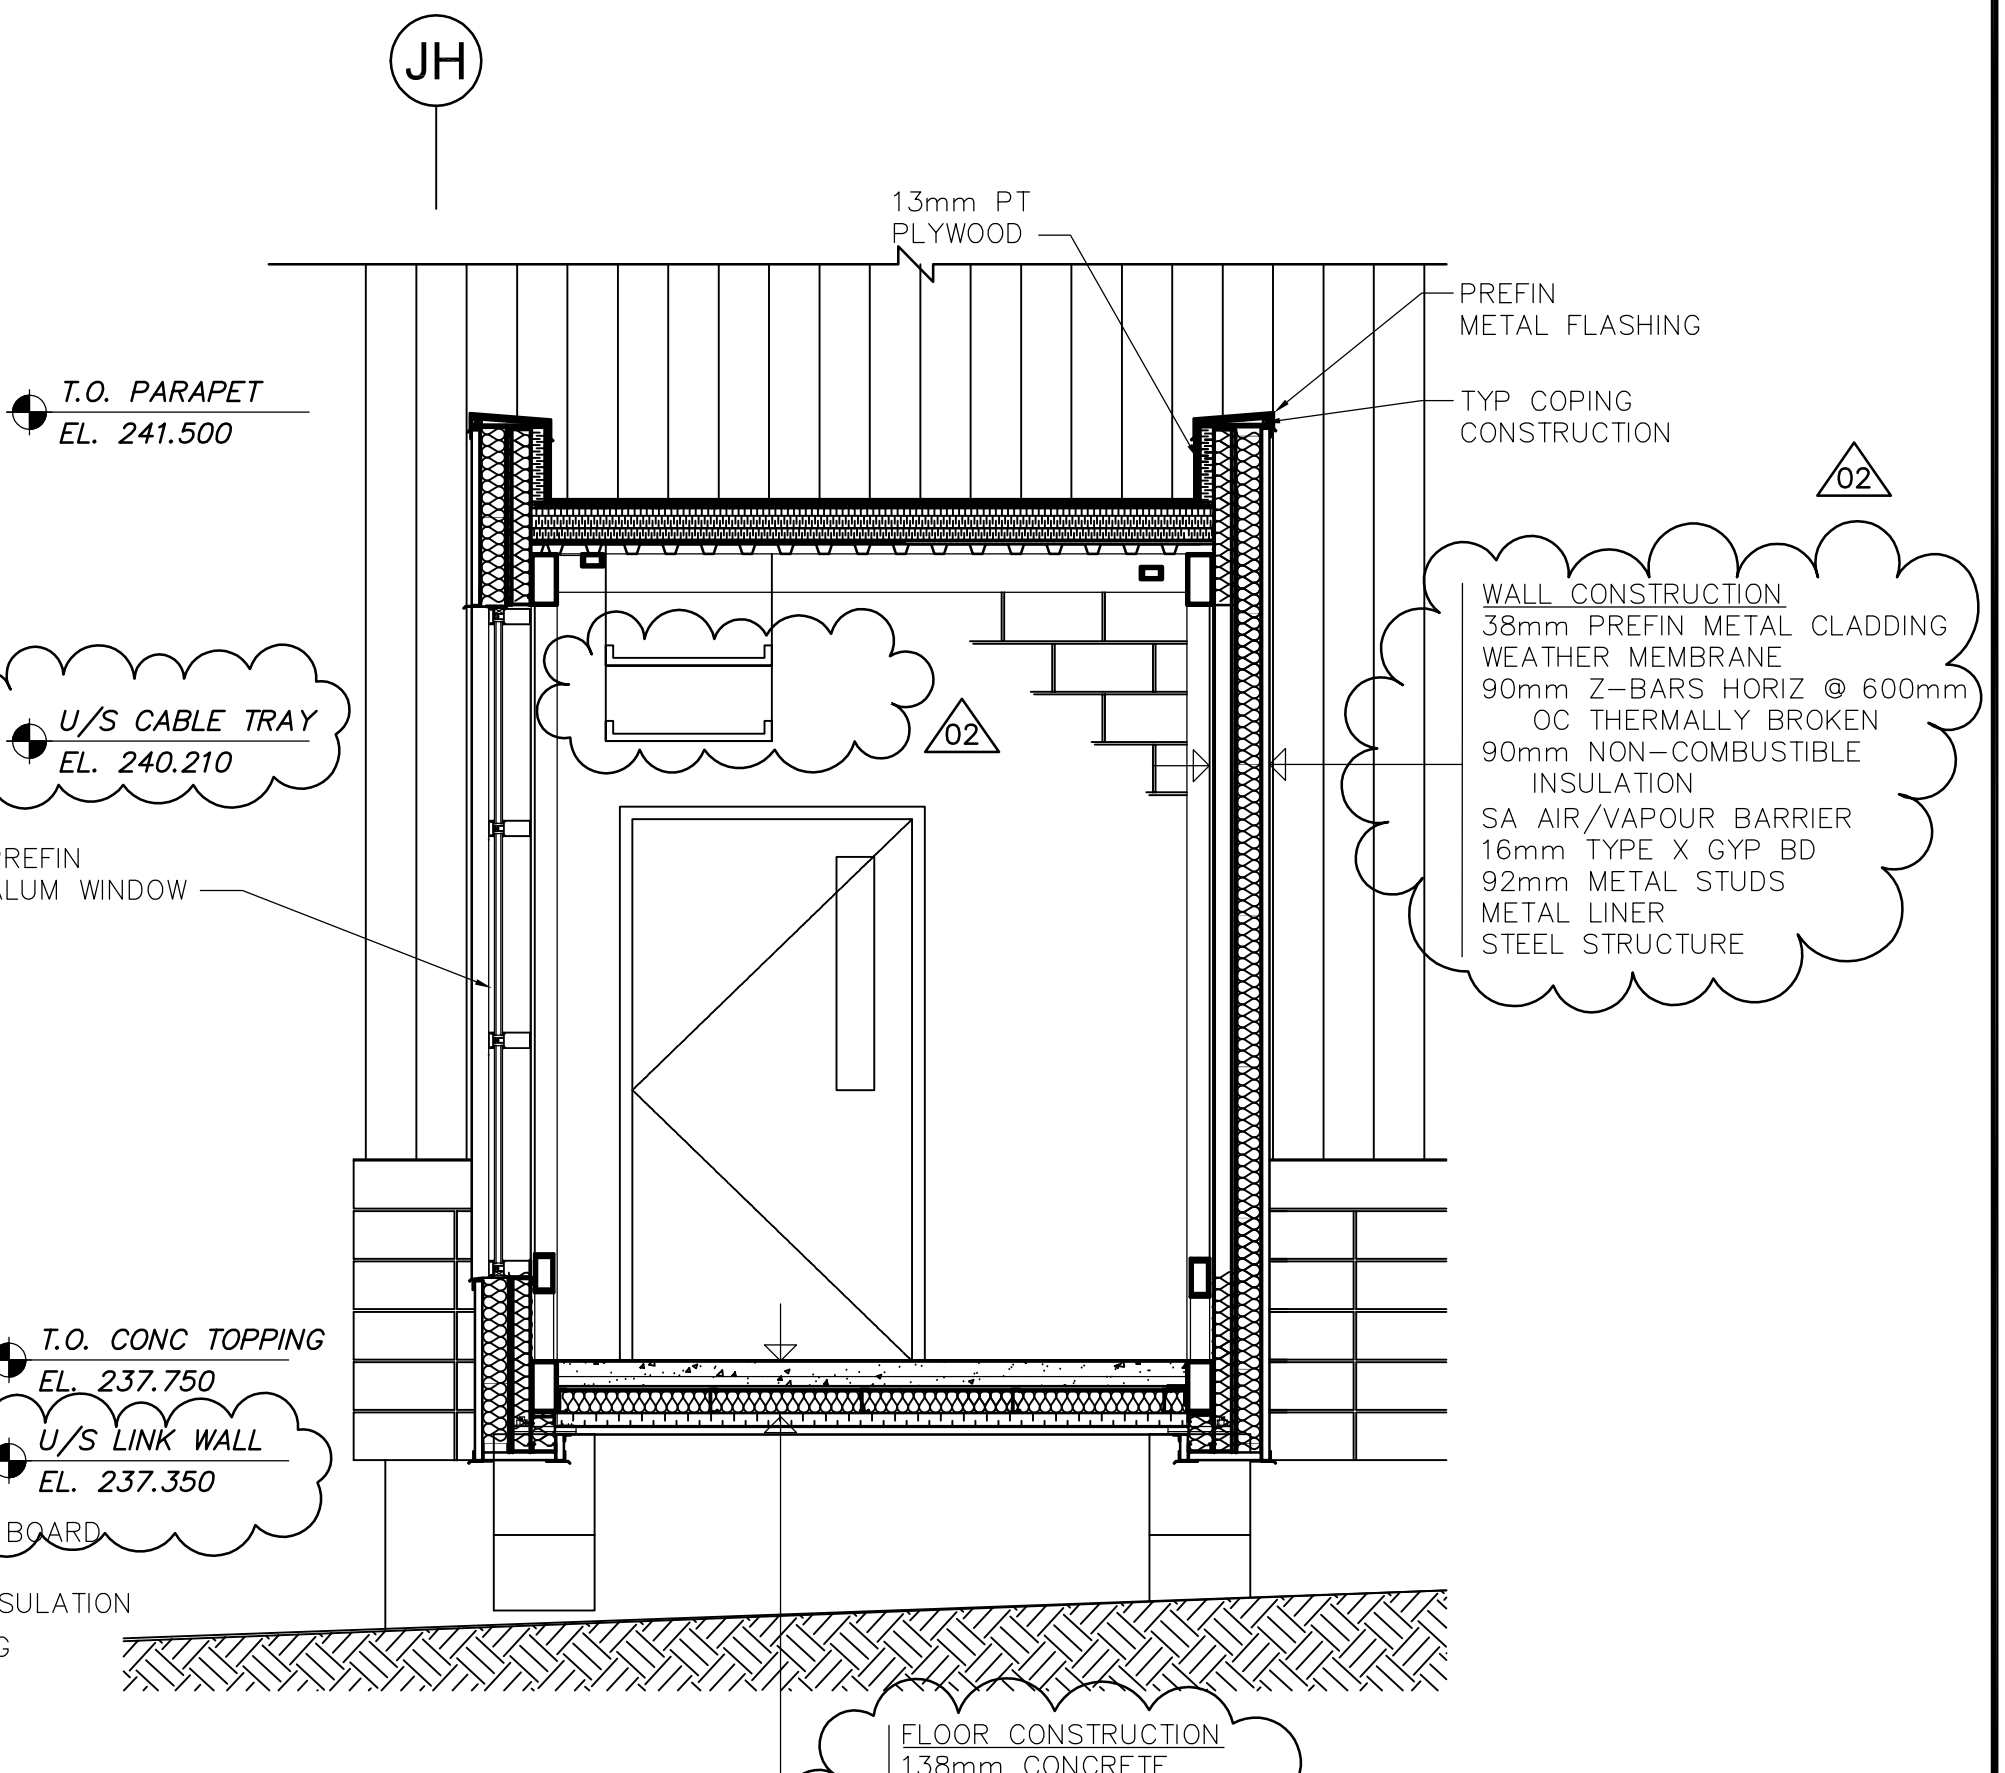

3 SECTION B
WJ-B0403 1:30

ROOF CONSTRUCTION
2-PLY MOD-BIT ROOFING
2 LAYERS INSULATION
OVERLAY-STAGGERED
TAPERED INSULATION (2%)
125mm RIGID INSULATION
AIR/VAPOUR BARRIER
13mm EXTERIOR GYP BD
38mm STEEL DECKING
STEEL STRUCTURE

WALL CONSTRUCTION
38mm PREFIN METAL CLADDING
WEATHER MEMBRANE
90mm Z-BARS HORIZ @ 600mm
OC THERMALLY BROKEN
90mm NON-COMBUSTIBLE
INSULATION
SA AIR/VAPOUR BARRIER
16mm TYPE X GYP BD
92mm METAL STUDS
METAL LINER
STEEL STRUCTURE

FLOOR CONSTRUCTION
138mm CONCRETE
38mm METAL DECK
13mm EXT GYP BD
AIR VAPOUR BARRIER
92mm STEEL STUDS
BATT INSULATION (R12)
50mm RIGID INSULATION
PREFIN METAL SOFFIT SYSTEM



NO.	REVISIONS	DATE	BY
02	792-2006 ADDENDUM 3	07/03/30	AL
01	792-2006 ADDENDUM 2	07/03/20	AL
00	ISSUED FOR TENDER	07/01/31	AL

DESIGNED BY	NC	CHECKED BY	LK
DRAWN BY	AL	APPROVED BY	AHL
SCALE:	AS SHOWN		
RELEASED FOR CONSTRUCTION BY:	R. SOROKOWSKI		
DATE	2006/10/02	DATE	2007/01/31

ENGINEER'S SEAL
ORIGINAL SIGNED BY
NEIL COOPER
2007/01/31
CONSULTANT DRAWING NO.
WJ-B0403

THE CITY OF WINNIPEG
WATER AND WASTE DEPARTMENT
ENGINEERING DIVISION

WATER TREATMENT PLANT
SODIUM HYPOCHLORITE GENERATION BUILDING
SODIUM HYPOCHLORITE AND CHEMICAL STORAGE BUILDING

ARCHITECTURAL
BUILDING LINK DETAILED PLAN & SECTIONS

CITY FILE NUMBER
SHEET OF
CITY DRAWING NUMBER
1-0601J-A-B0403-001-02D