


1 PROFILE
H=1:500 V=1:20

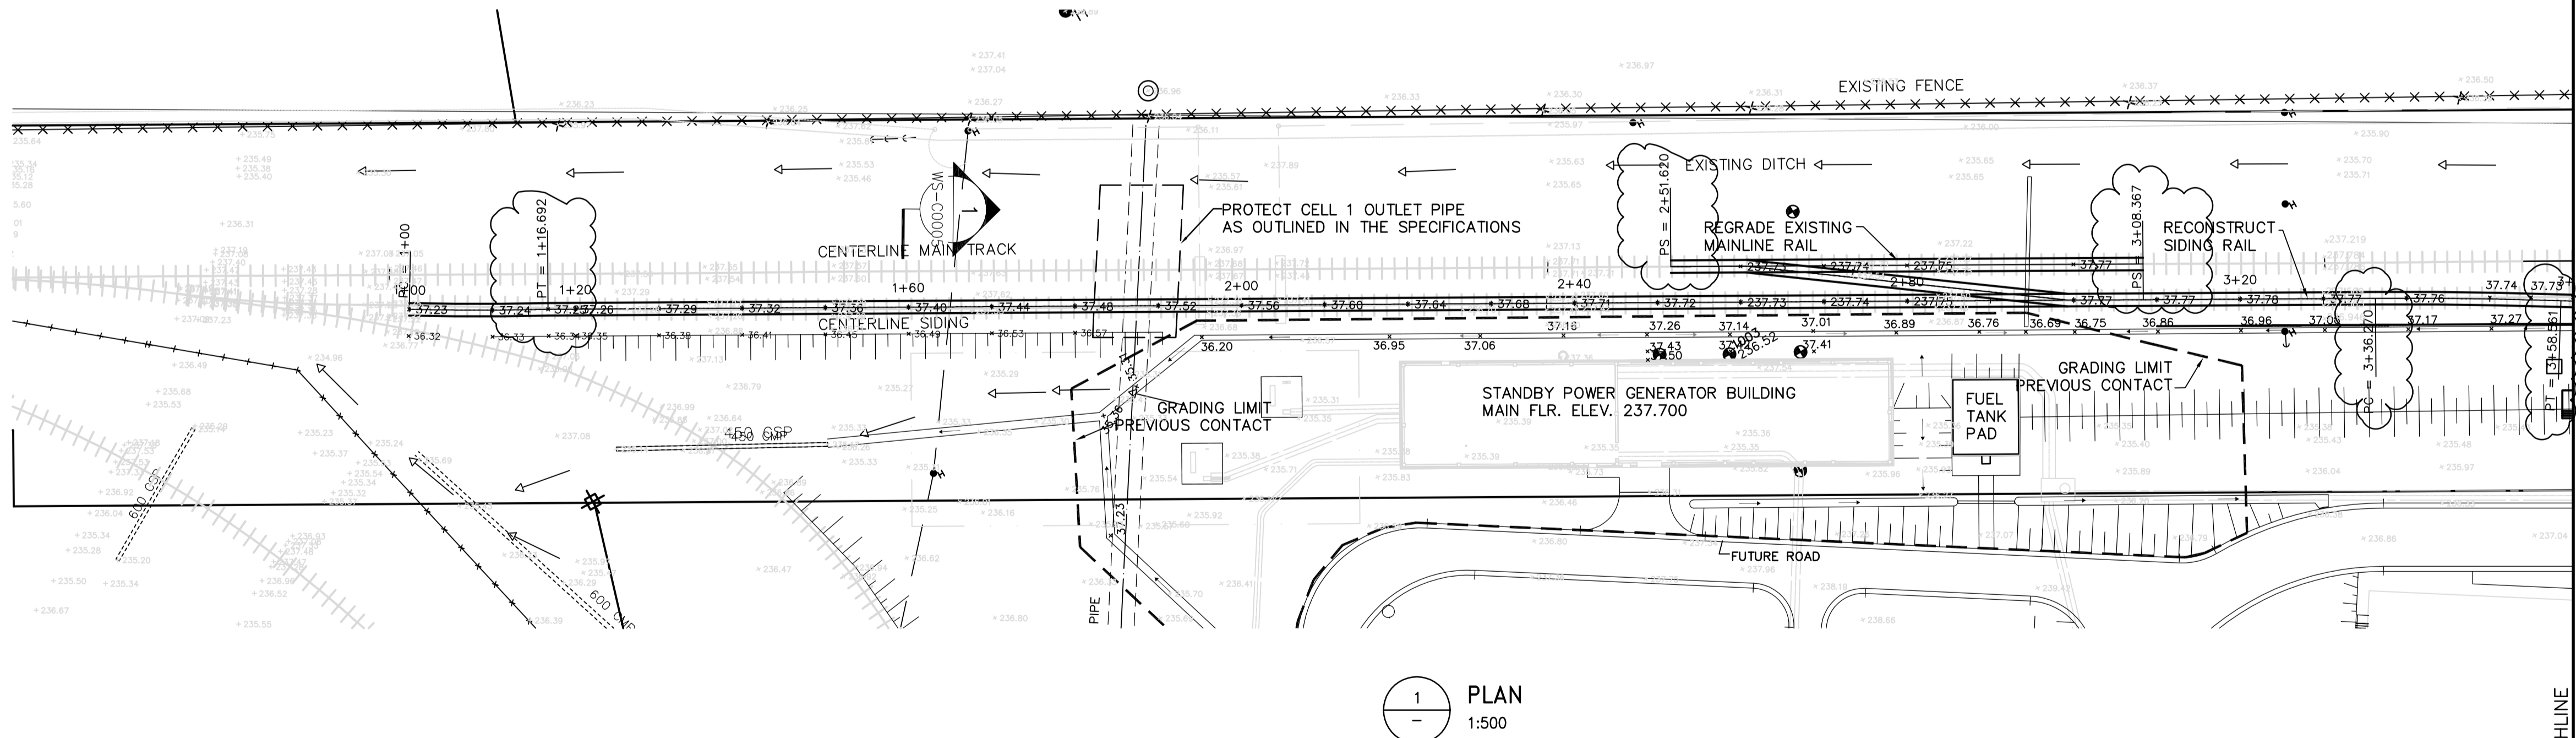

1 PLAN
1:500

MATCHLINE
3+60

BENCHMARK NOTES:

DRAWING COORDINATES ARE UTM NAD83 - SCALE FACTOR 0.99983			
B.M. No.	NORTHING	EASTING	ELEVATION
PILE 136	5523873.734	647764.406	236.242
PILE 133	5523256.606	647782.387	236.056

NOTE: PILE No. 136 MAY BE REVISED PRIOR TO CONSTRUCTION. CONTRACT ADMINISTRATOR TO PROVIDE NEW ELEVATION AND COORDINATES.

- REFERENCE NOTES:
- ADD 200.00 TO DESIGN GRADES OBTAIN GEODETIC DATUM
 - ALL EXISTING UNDERGROUND UTILITIES SHALL BE CONFIRMED PRIOR TO CONSTRUCTION.
 - ALL SITE SURFACE WORKS SHALL BE IN ACCORDANCE WITH THE C.O.W. STANDARD CONSTRUCTION SPECIFICATIONS

150 mm W.M.	WATERMAIN	150 mm W.M.	HYDRO M.T.S.	---	LIGHT STANDARD
◇	HYDRANT	+	CONCRETE	---	ANCHOR
○	VALVE	○	ASPHALT	---	POLE
300mm L.D.S.	LAND DRAINAGE SEWER	300mm L.D.S.	PROPERTY LINE	---	CONTOURS
250mm W.W.S.	WASTEWATER SEWER	250mm W.W.S.	SURVEY BAR	---	RAIL X-ING SIGNAL
○	MANHOLE	●	ELEVATION	---	RAILWAY TRACK
□	CATCH BASIN	232.750	TREE	---	DITCH
▽	CURB INLET	300φ	ANODE	---	
+	JUNCTIONS		CONCRETE SIDEWALK	---	
---	CULVERT		FENCE	---	
---	GAS			---	
---	EXISTING	---	EXISTING	---	EXISTING
---	LEGEND - PLAN	---	LEGEND - PLAN	---	LEGEND - PLAN
---	PROPOSED	---	PROPOSED	---	PROPOSED

APEGM
Certificate of Authorization
Earth Tech Canada Inc.
No. 730 Expiry: April 30, 2007

B.M. ELEV.			
01	792-2006 ADDENDUM 3	07/03/26	JC
00	ISSUED FOR TENDER	07/01/31	JC
NO. REVISIONS		DATE	BY

CH2M HILL
Frederickson Cooper ARCHITECTS

EarthTech
A Tyco International Ltd. Company

DESIGNED BY	BSK	CHECKED BY	JC
DRAWN BY	BSK	APPROVED BY	AHL
SCALE:	1:500	RELEASED FOR CONSTRUCTION BY:	R. SOROKOWSKI
DATE	2007/01/31	DATE	2007/01/31

ENGINEER'S SEAL
PROVINCE OF MANITOBA
ORIGINAL SIGNED BY
J.N. CRANG
REGISTERED PROFESSIONAL ENGINEER

CONSULTANT DRAWING NO.
WS-C0003

THE CITY OF WINNIPEG
WATER AND WASTE DEPARTMENT
ENGINEERING DIVISION

WATER TREATMENT PLANT
BULK CHEMICAL BUILDING
SODIUM HYPOCHLORITE AND CHEMICAL STORAGE BUILDINGS

CIVIL
RAILWAY CONSTRUCTION
PLAN & PROFILE

CITY FILE NUMBER	
SHEET OF	
CITY DRAWING NUMBER	1-06015-A-C0003-001-01D