



PLAN STAIR # 11
1:30

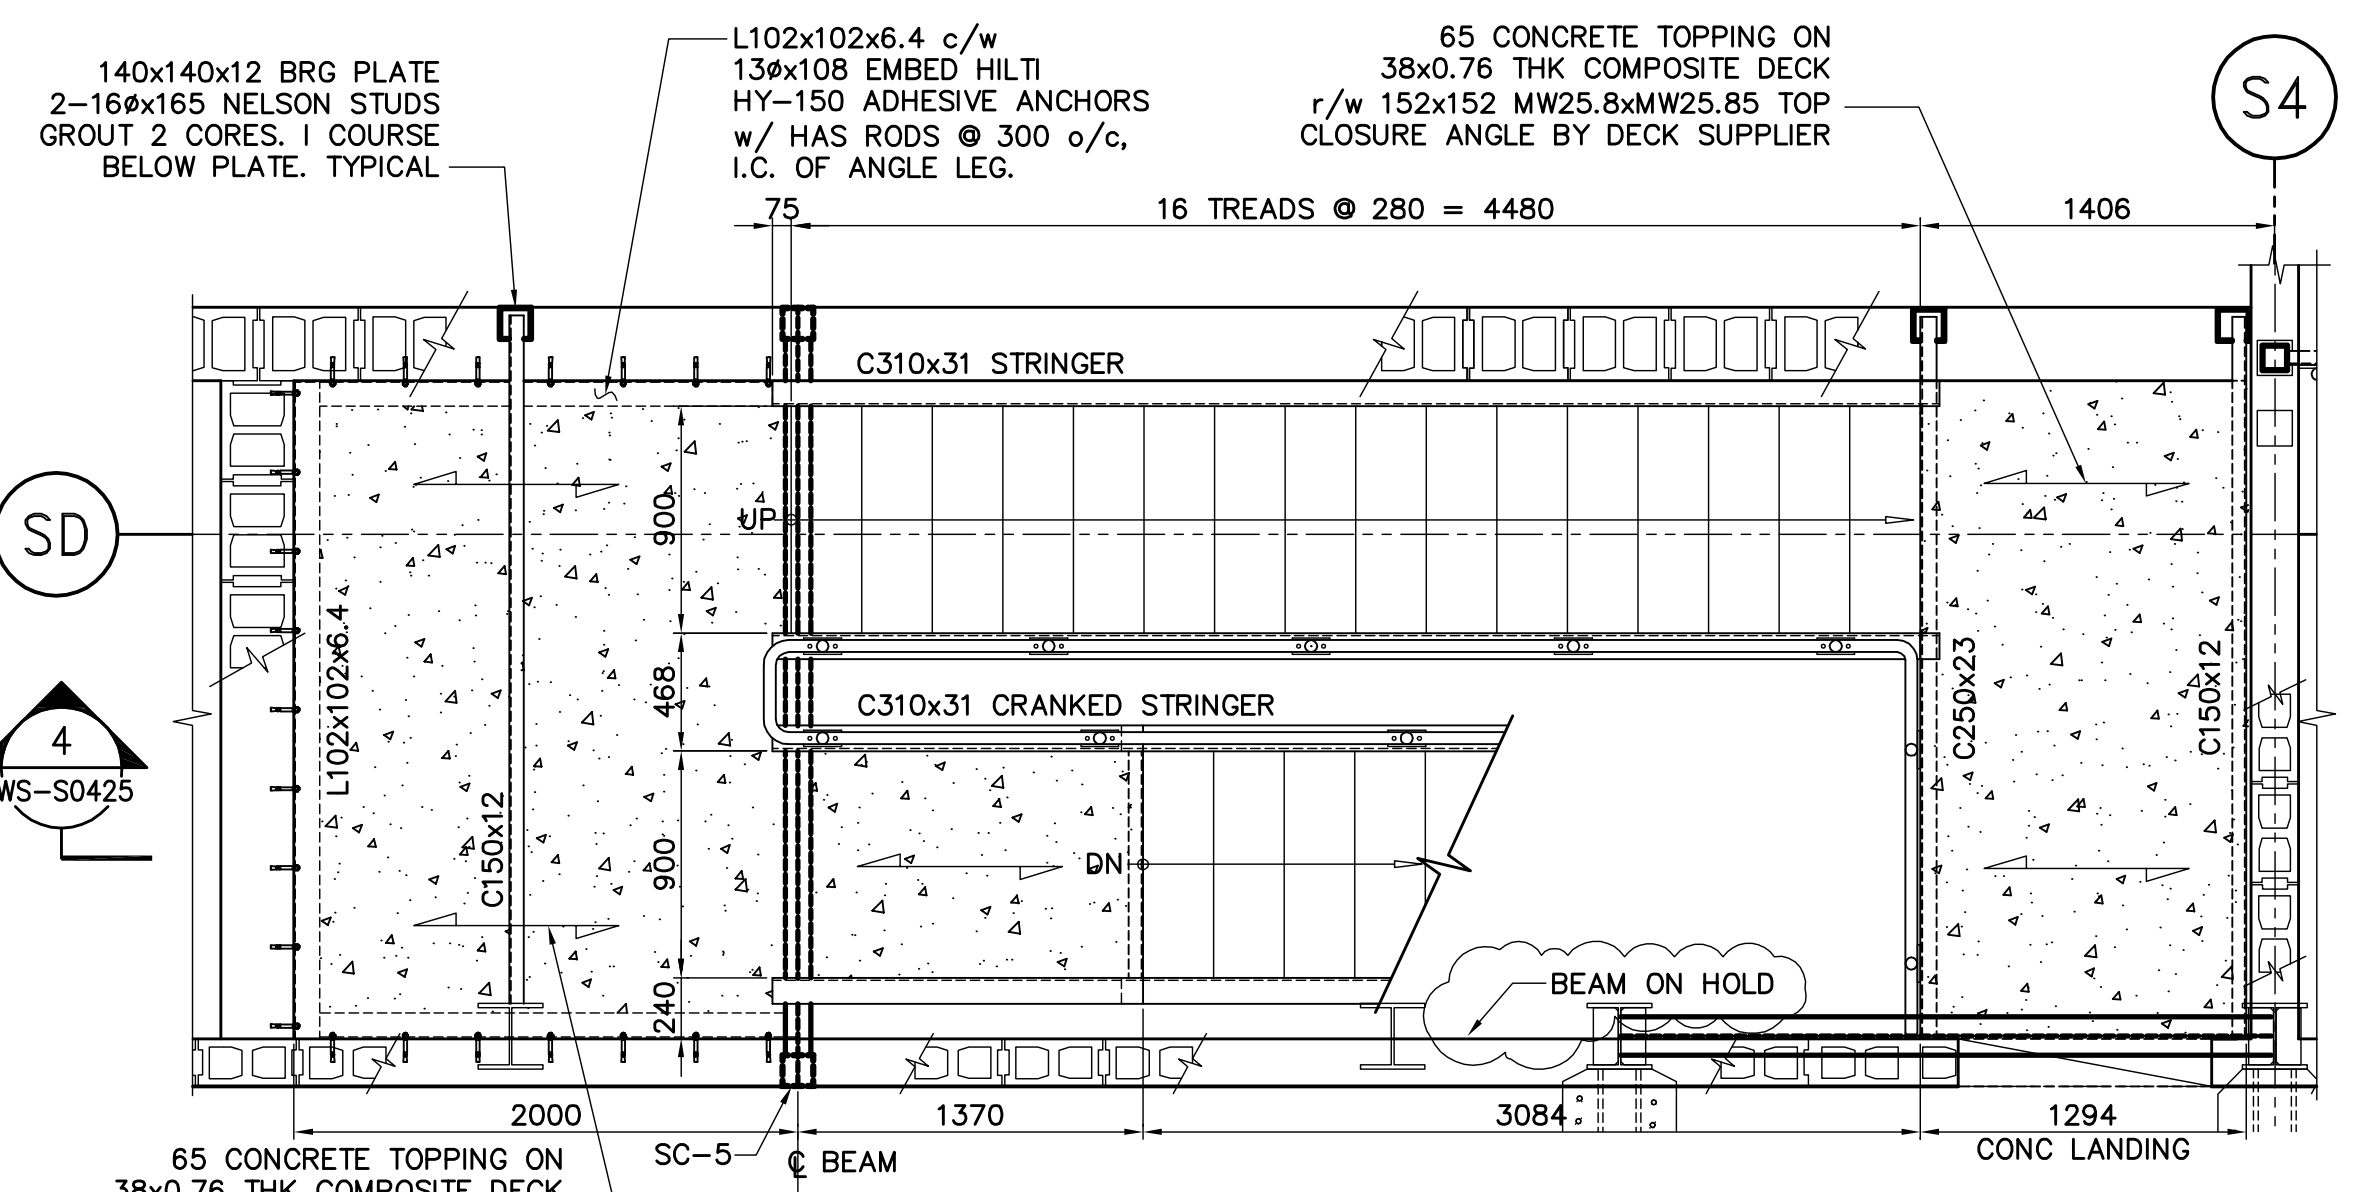


PLAN STAIR @ ELEV. 242.105 & ELEV. 245.000
1:30


NOTE:
ALL STAIR STRINGERS REVISED TO C310x31

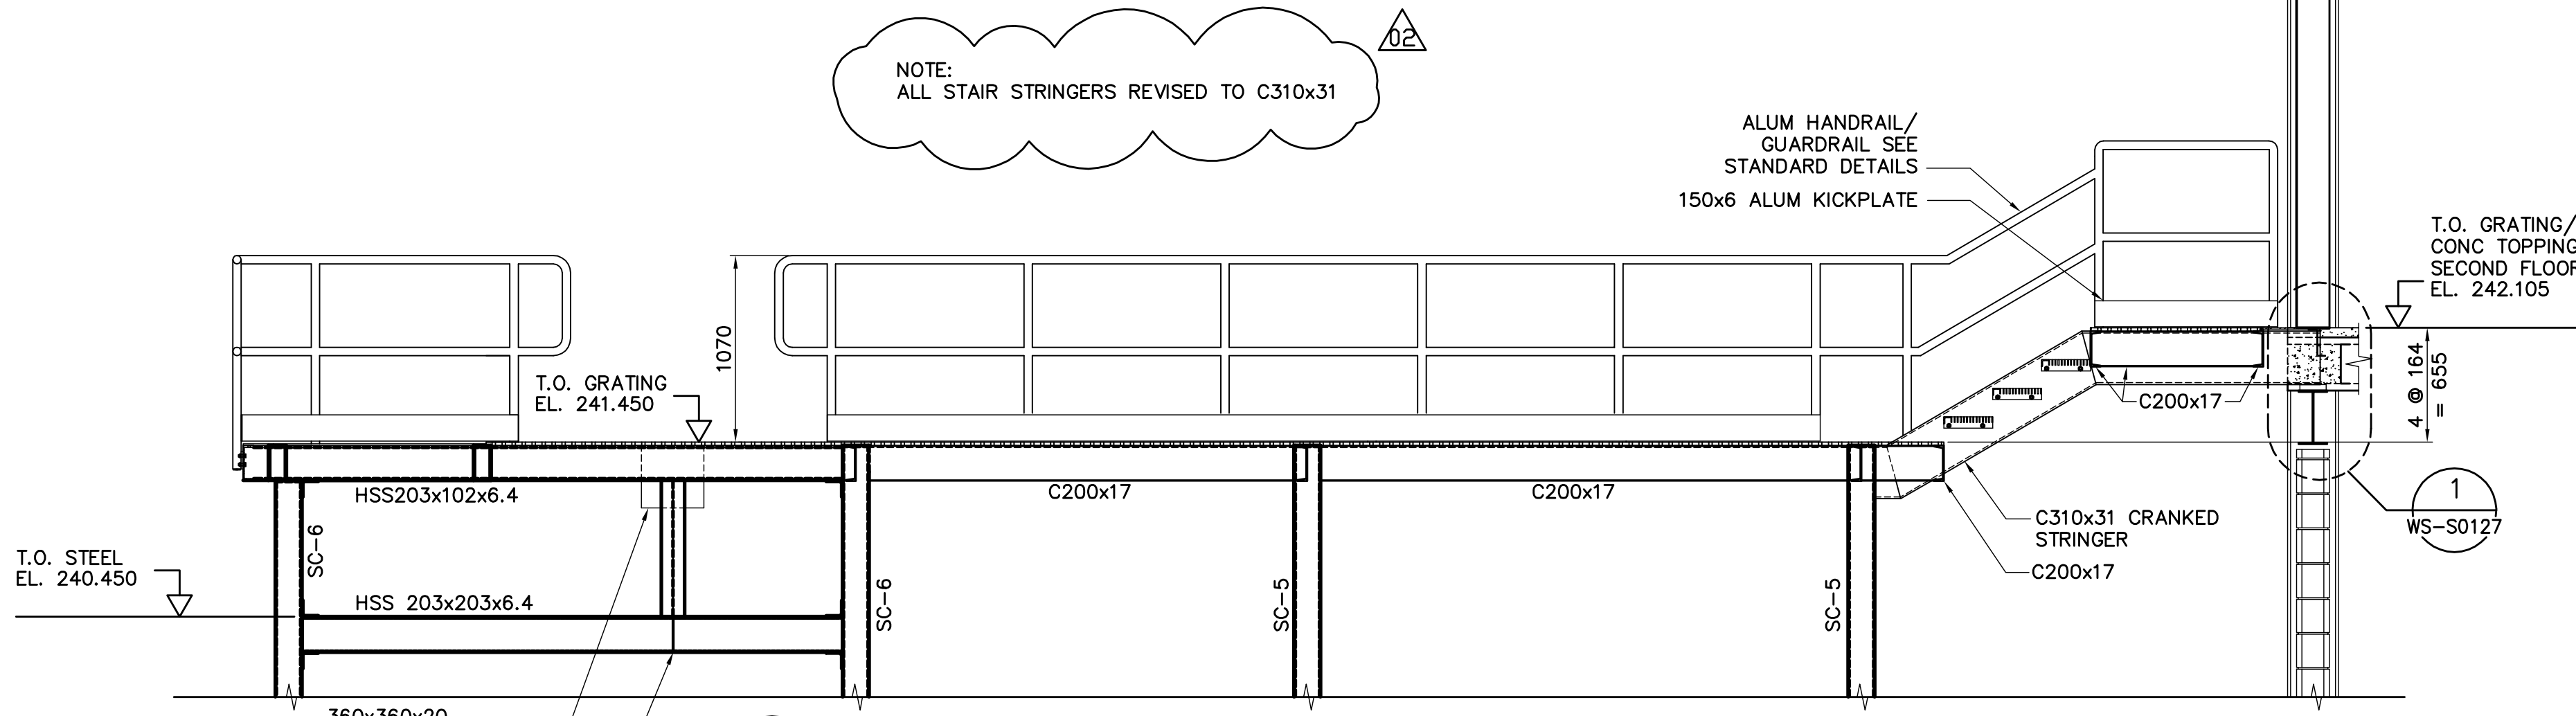


SECTION 3
1:30

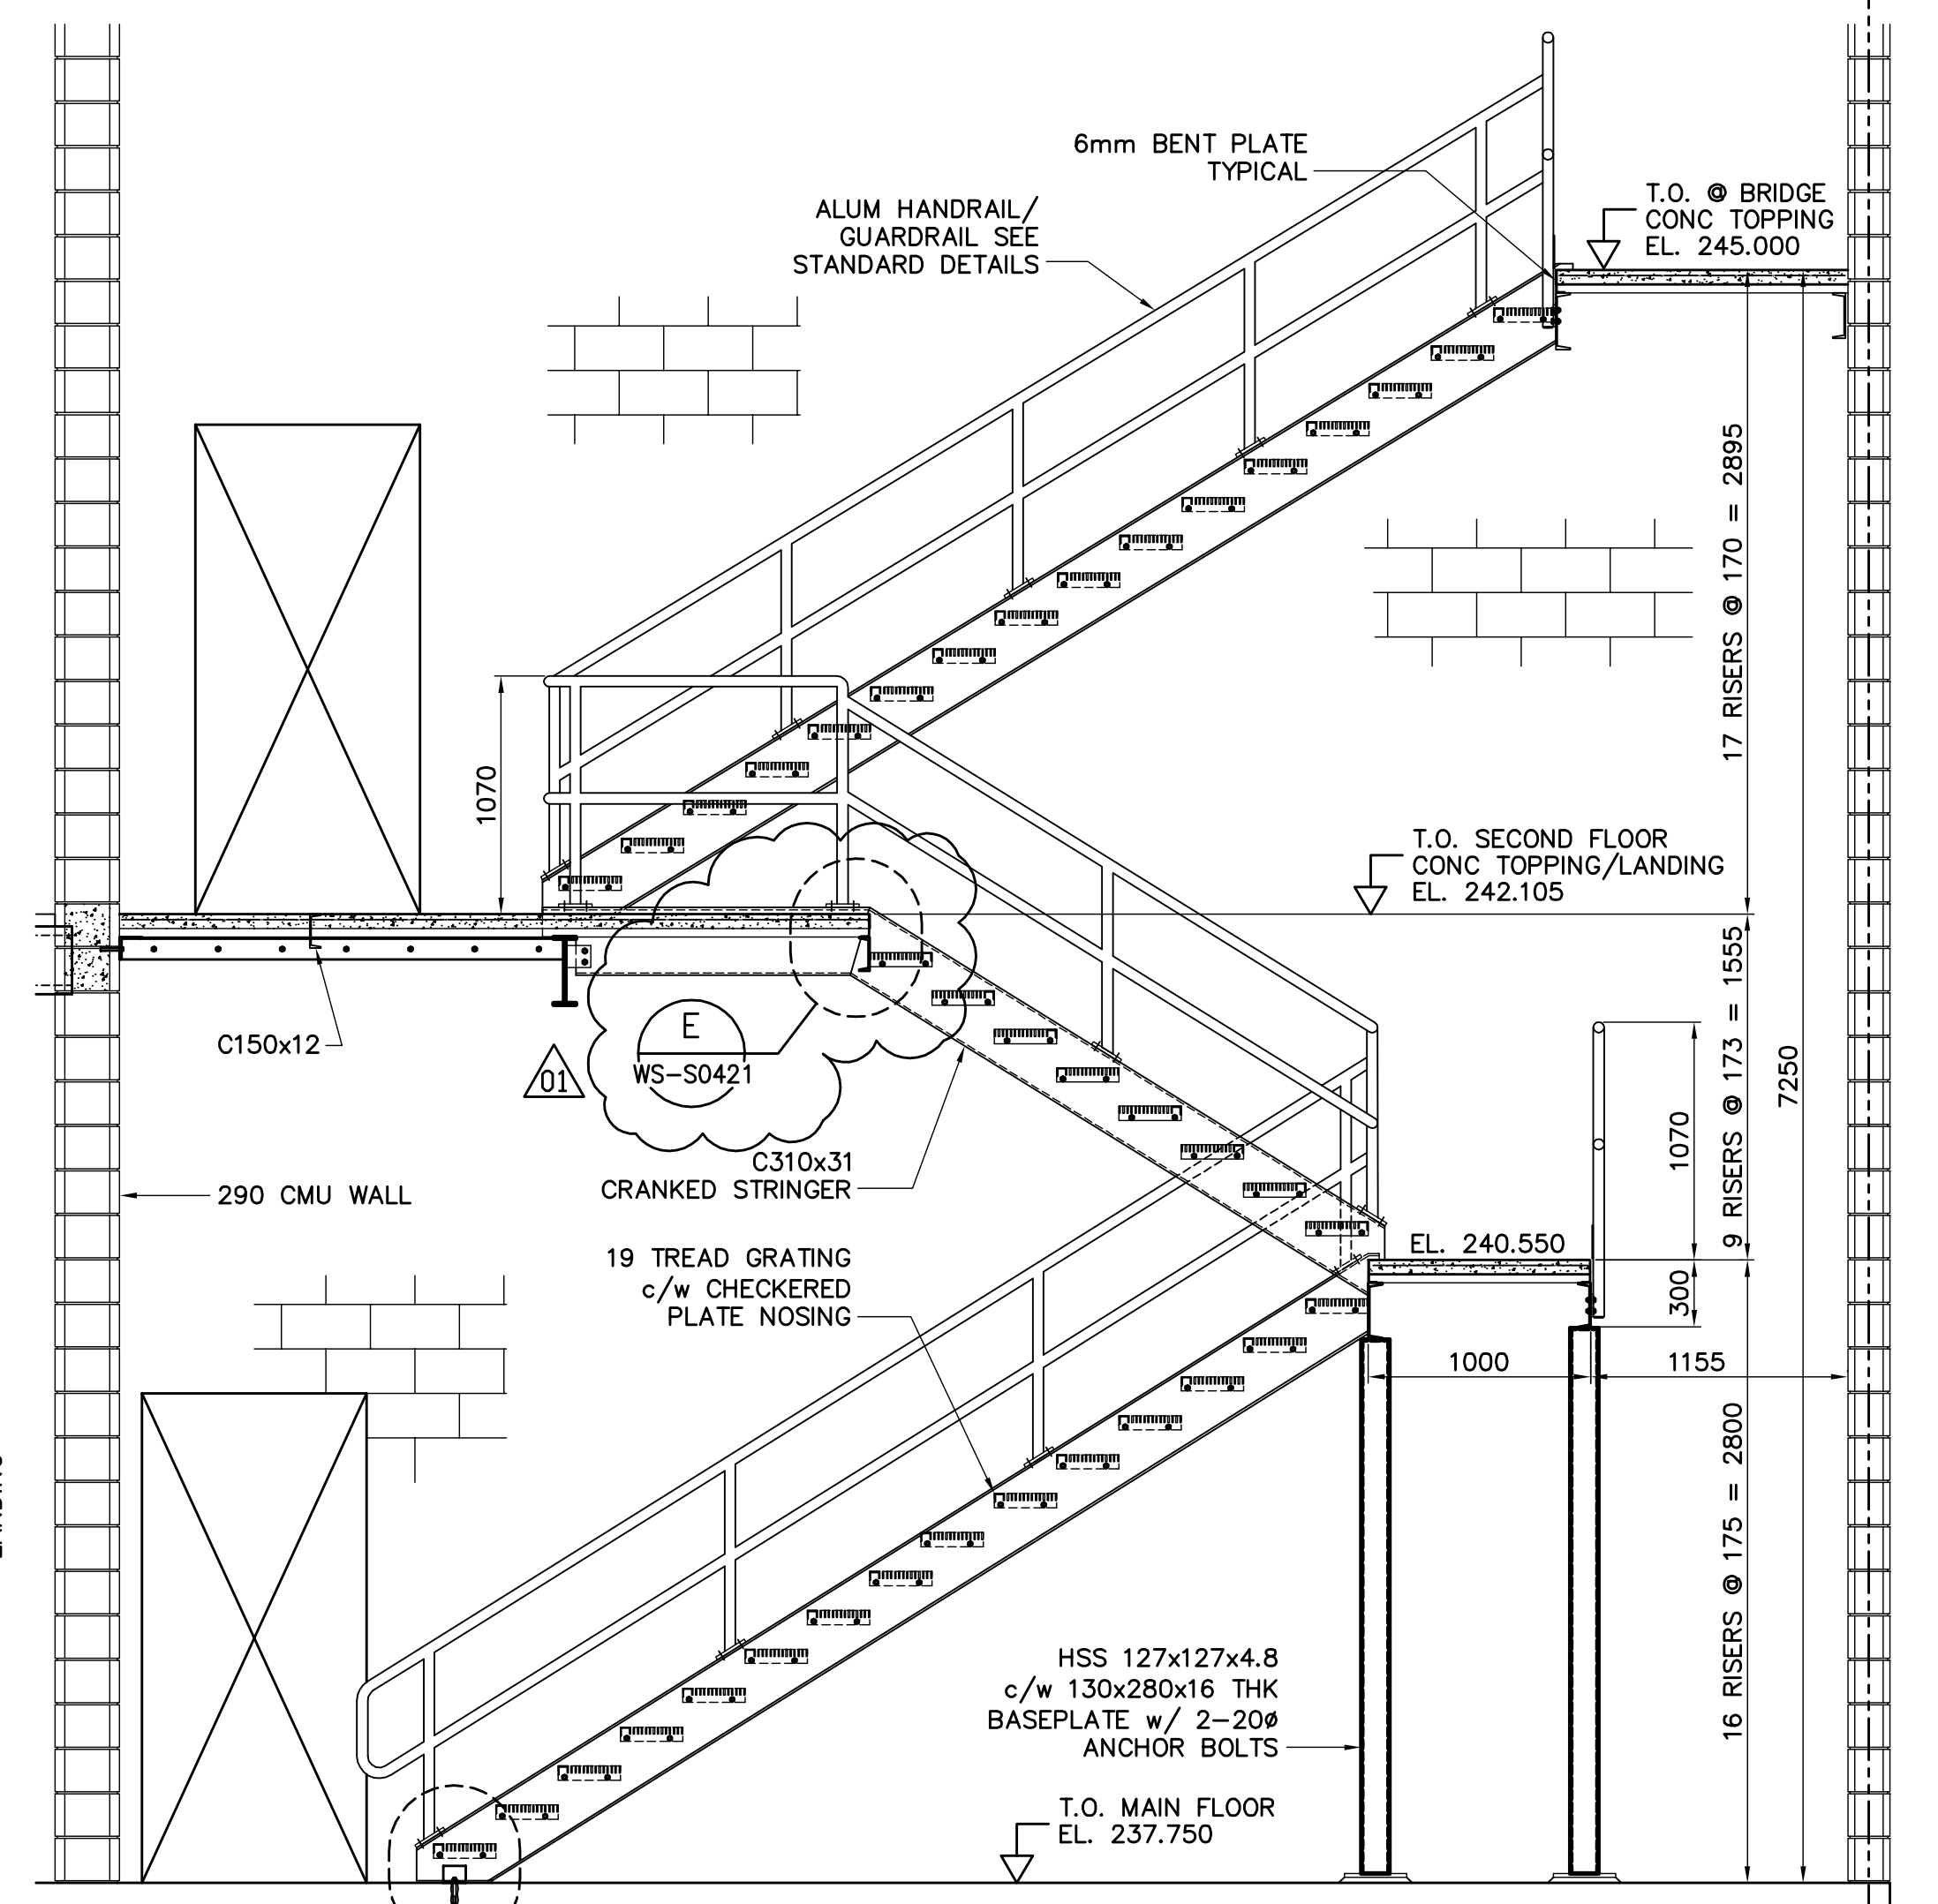

SECTION 4
1:30

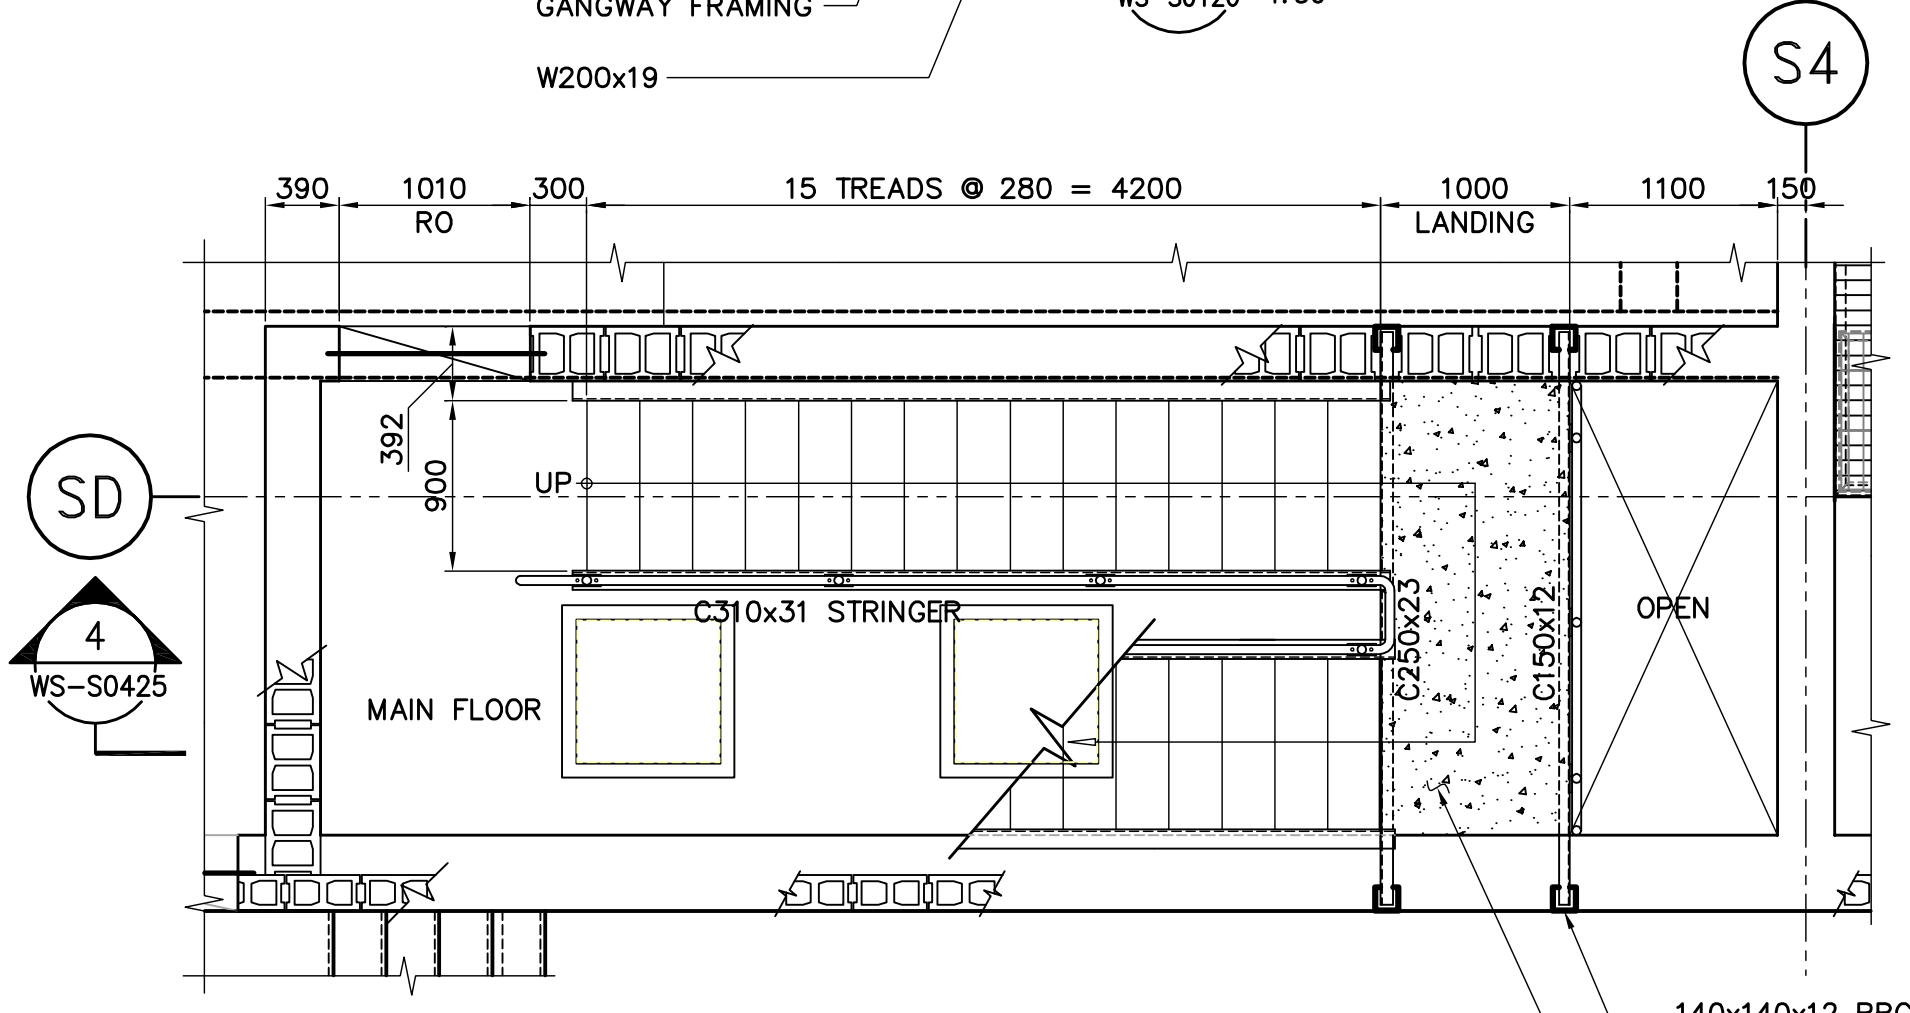

PLAN STAIR @ ELEV. 237.750
1:40

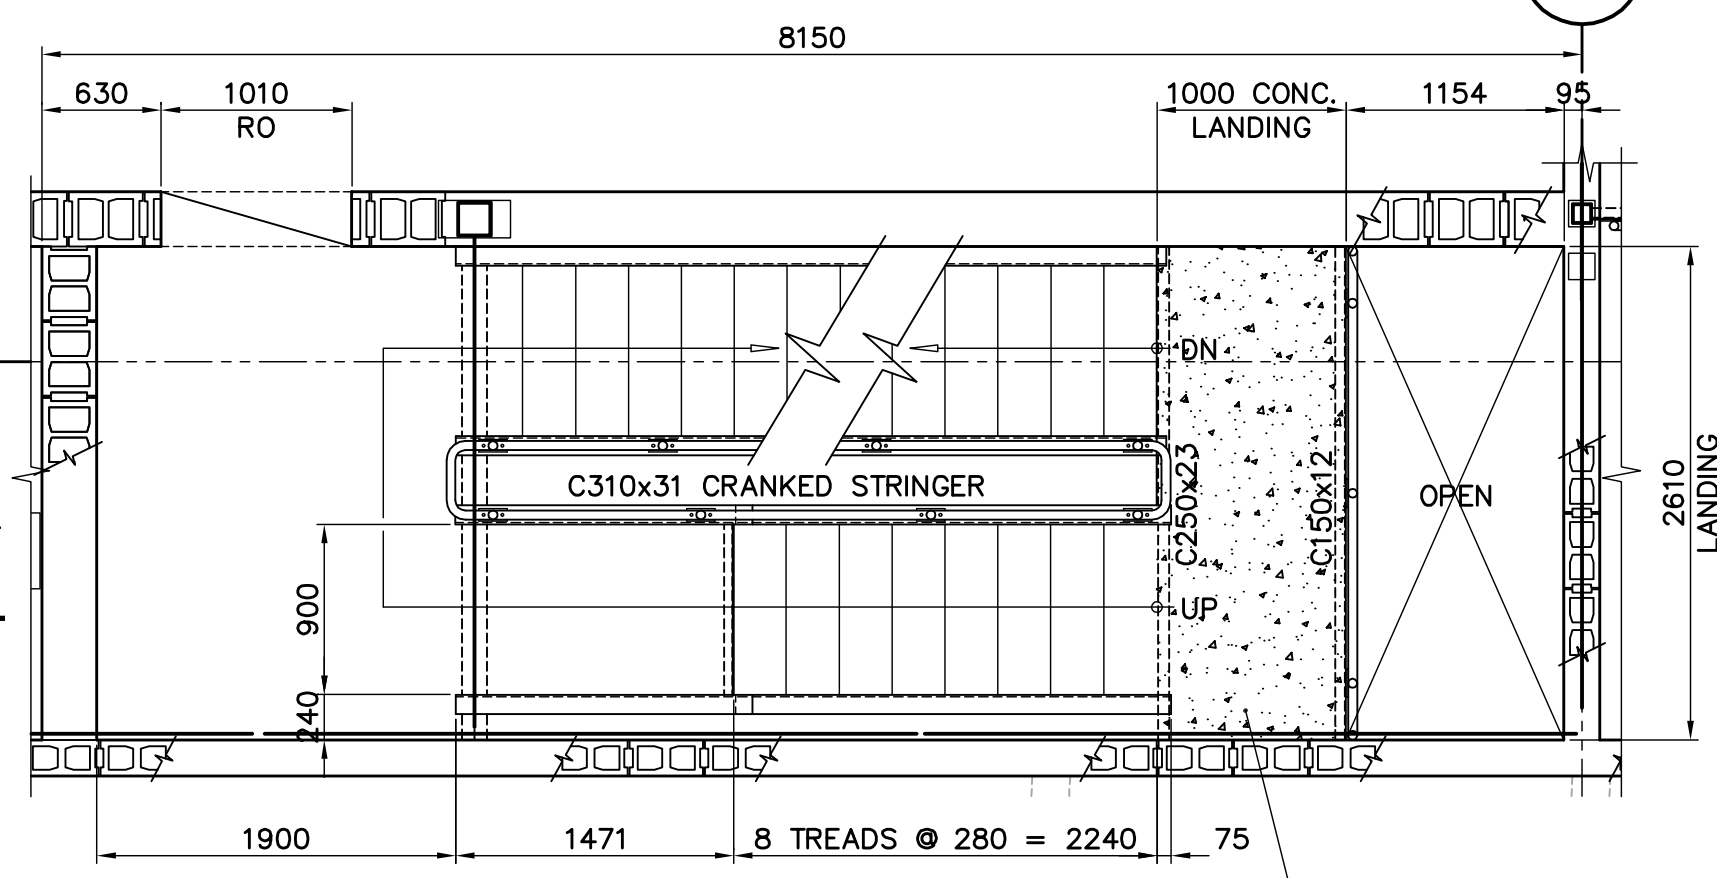

PLAN STAIR @ ELEV. 240.550
1:40

65 CONCRETE TOPPING ON
38x0.76 THK COMPOSITE DECK
r/w 152x152 MW25.8xMW25.85 TOP
CLOSURE ANGLE BY DECK SUPPLIER

65 CONC. TOPPING ON
38x0.76 THK COMPOSITE DECK
r/w 152x152 MW25.8xMW25.85 TOP
CLOSURE ANGLE BY DECK SUPPLIER



B.M. ELEV.		 		ENGINEER'S SEAL		 WATER AND WASTE DEPARTMENT ENGINEERING DIVISION	
		Frederickson Cooper ARCHITECTS		ORIGINAL SIGNED BY A. POCHANART 2007/01/31		WATER TREATMENT PLANT BULK CHEMICAL BUILDING SODIUM HYPOCHLORITE AND CHEMICAL STORAGE BUILDING	
DESIGNED BY: ARA CHECKED BY: AP DRAWN BY: WDB APPROVED BY: AHL		SCALE: AS NOTED RELEASED FOR CONSTRUCTION BY: R. SOROKOWSKI		CONSULTANT DRAWING NO. WS-S0425		CITY FILE NUMBER SHEET OF CITY DRAWING NUMBER 1-06019-A-S0425-001-02D	
02 792-2006 ADDENDUM 3 07/03/30 WDB 01 792-2006 ADDENDUM 2 07/03/22 WDB 00 ISSUED FOR TENDER 07/01/31 WDB		NO. REVISIONS DATE BY DATE 2006/09/16 DATE 2007/01/31				STRUCTURAL CATWALK STAIRS AND PLATFORMS DETAILS	