



PLAN VIEW - STAIR # 13
1:30


NOTE: ALL STAIR STRINGERS REVISED TO C310x31

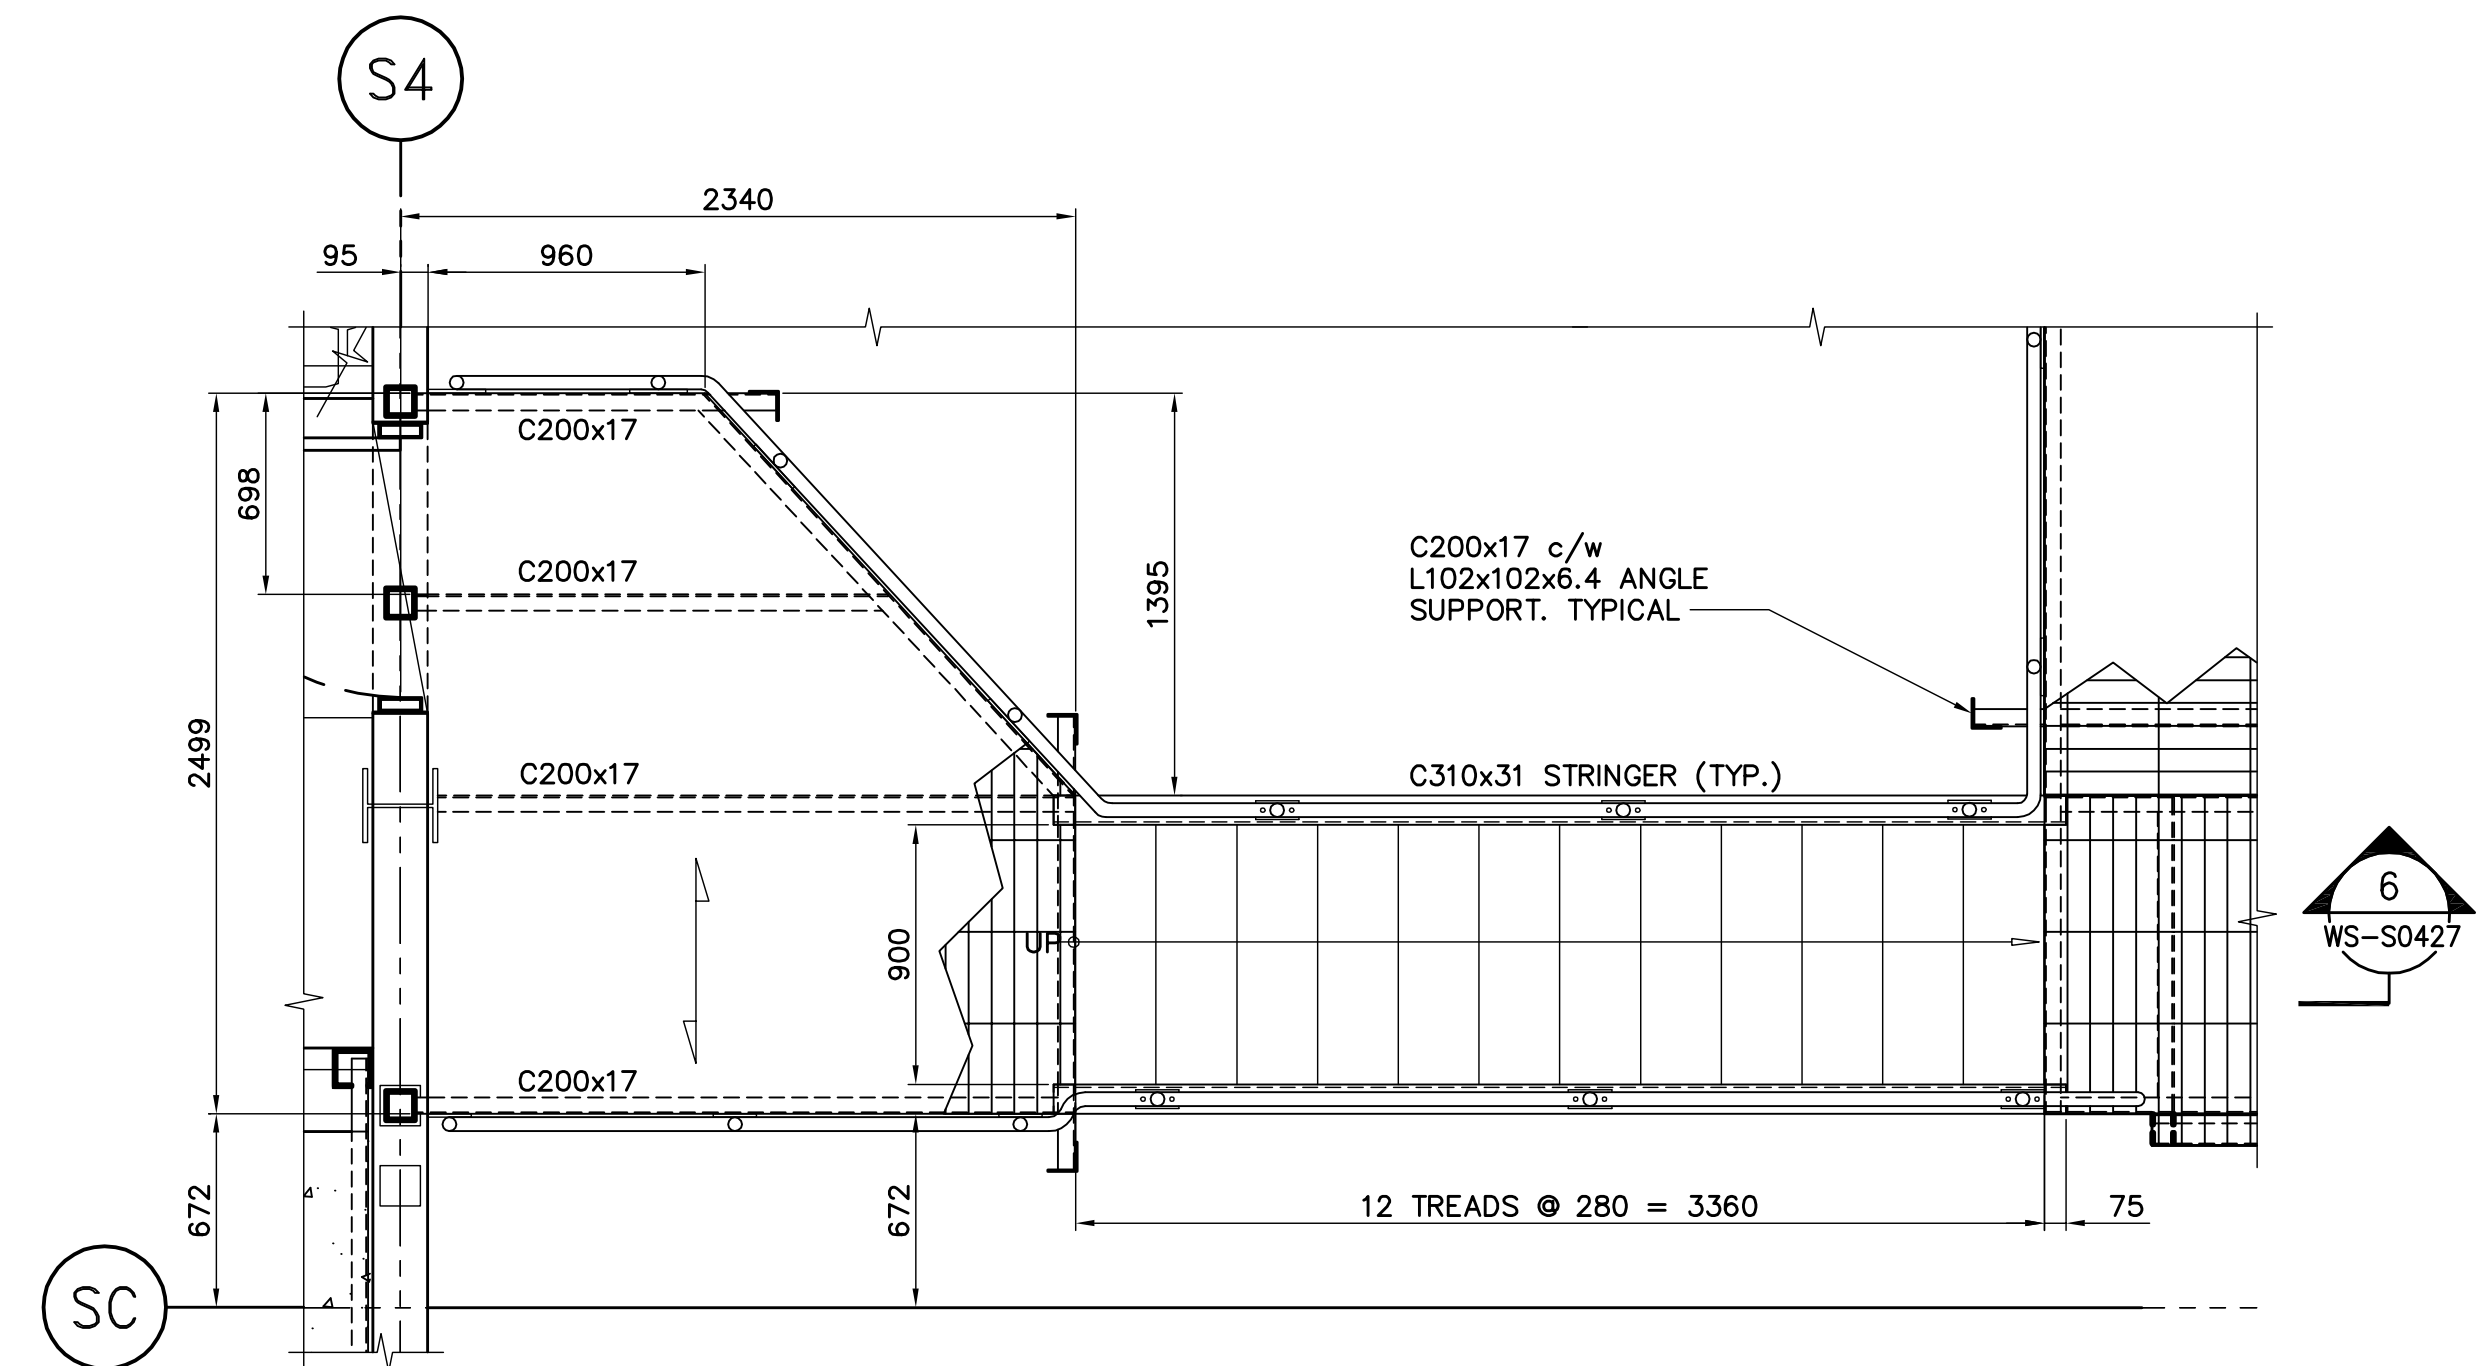

PLAN VIEW - STAIR # 14
1:30

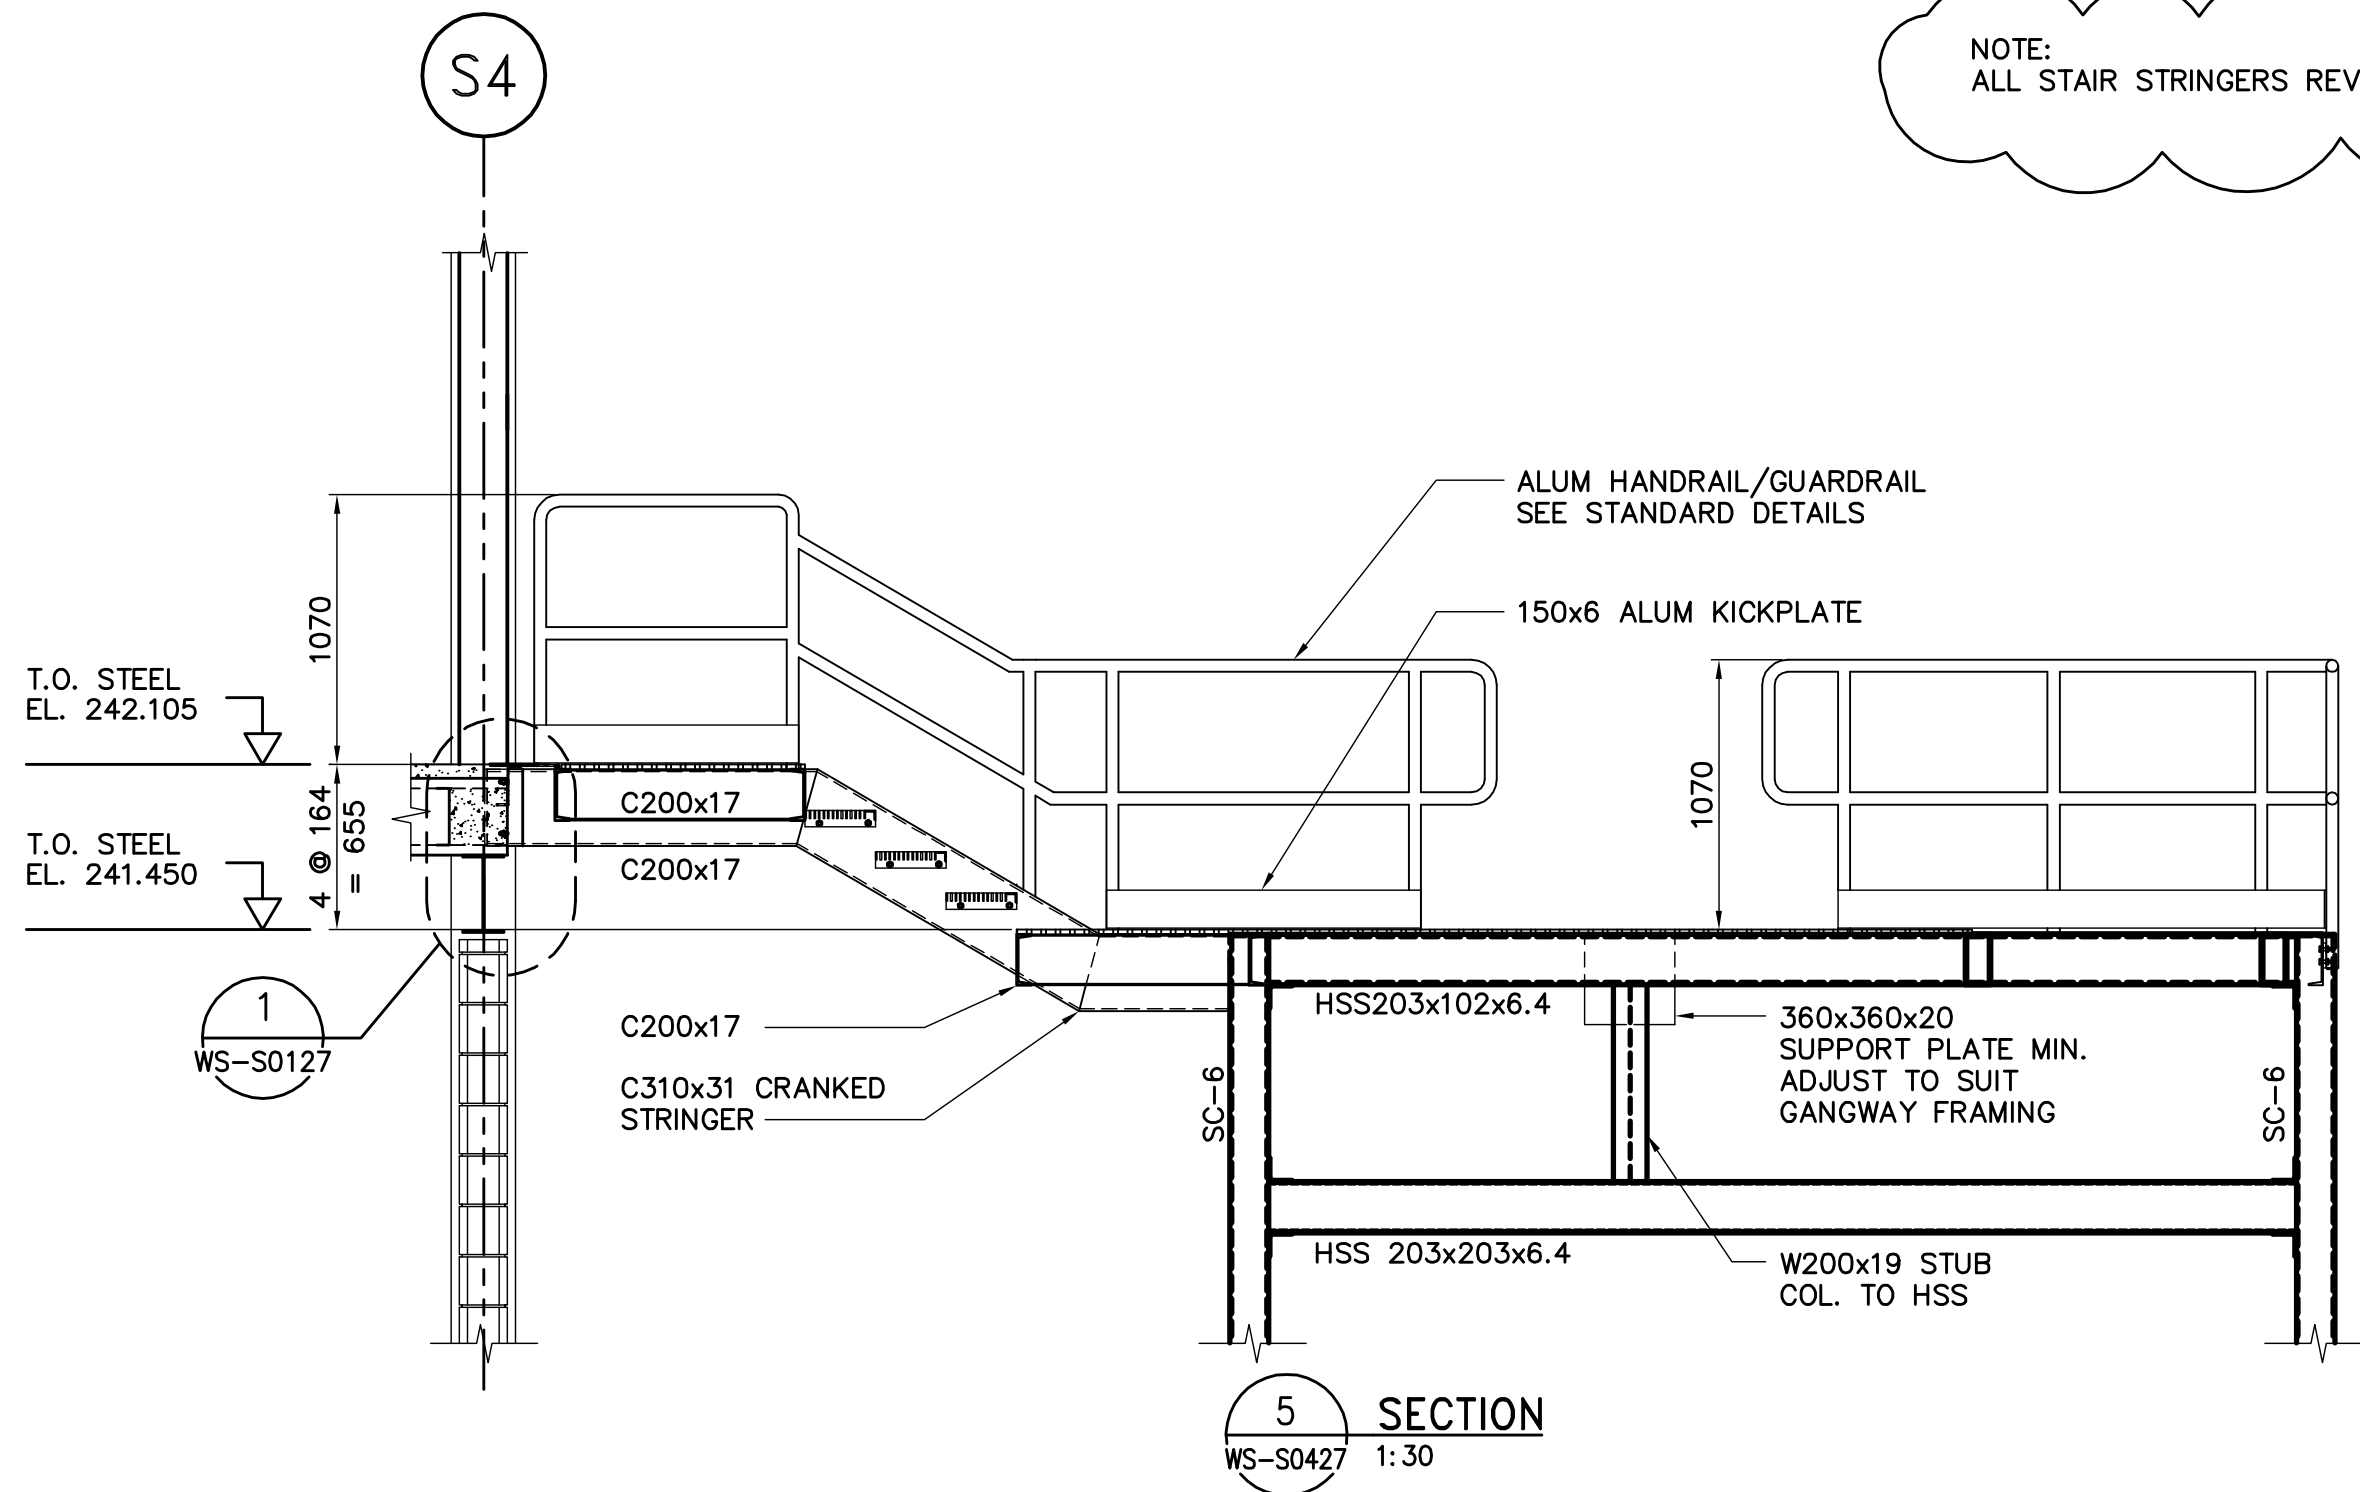

SECTION 5
WS-S0427 1:30

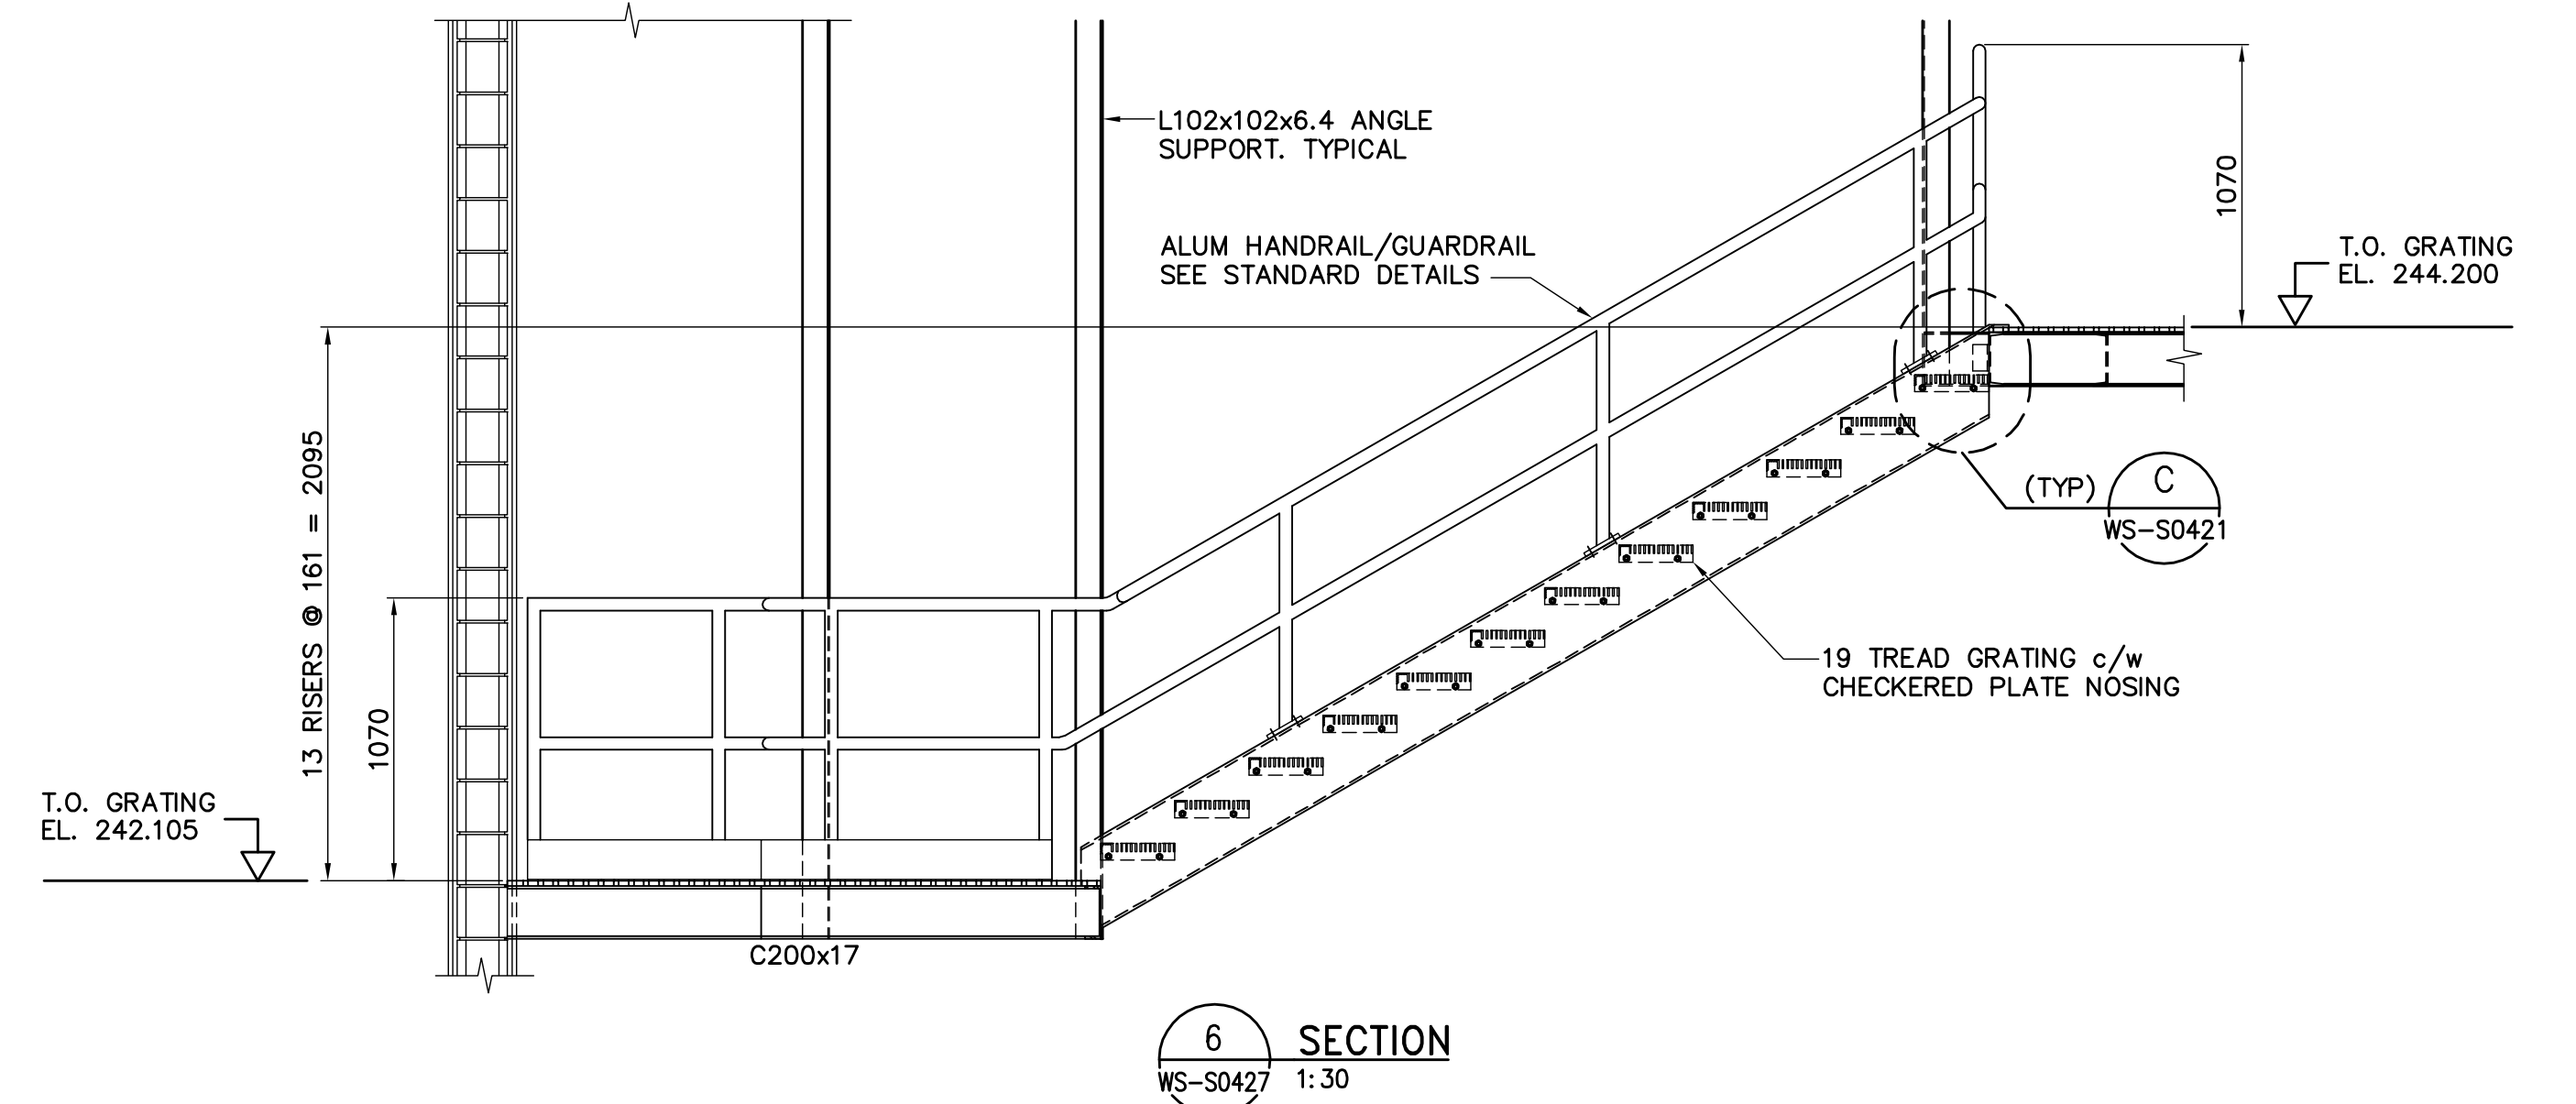

SECTION 6
WS-S0427 1:30



B.M. ELEV.		 Frederickson Cooper ARCHITECTS		 A Tyco International Ltd. Company		ENGINEER'S SEAL		 THE CITY OF WINNIPEG WATER AND WASTE DEPARTMENT ENGINEERING DIVISION	
		DESIGNED BY	ARA	CHECKED BY	AP	ORIGINAL SIGNED BY		CITY FILE NUMBER	
		DRAWN BY	WDB	APPROVED BY	AHL	A. POCHANART		SHEET OF	
		SCALE:	AS NOTED	RELEASED FOR CONSTRUCTION BY:		2007/01/31		CITY DRAWING NUMBER	
01 792-2006 ADDENDUM 3 07/03/30 WDB		DATE		R. SOROKOWSKI		CONSULTANT DRAWING NO.		PARTIAL CATWALK STAIRS AND PLATFORMS PLAN	
00 ISSUED FOR TENDER 07/01/31 WDB		DATE		2006/09/11		WS-S0427		1-0601S-A-S0427-001-0D	
NO. REVISIONS		DATE		DATE		DATE			