


COW-A3 (02/2006)

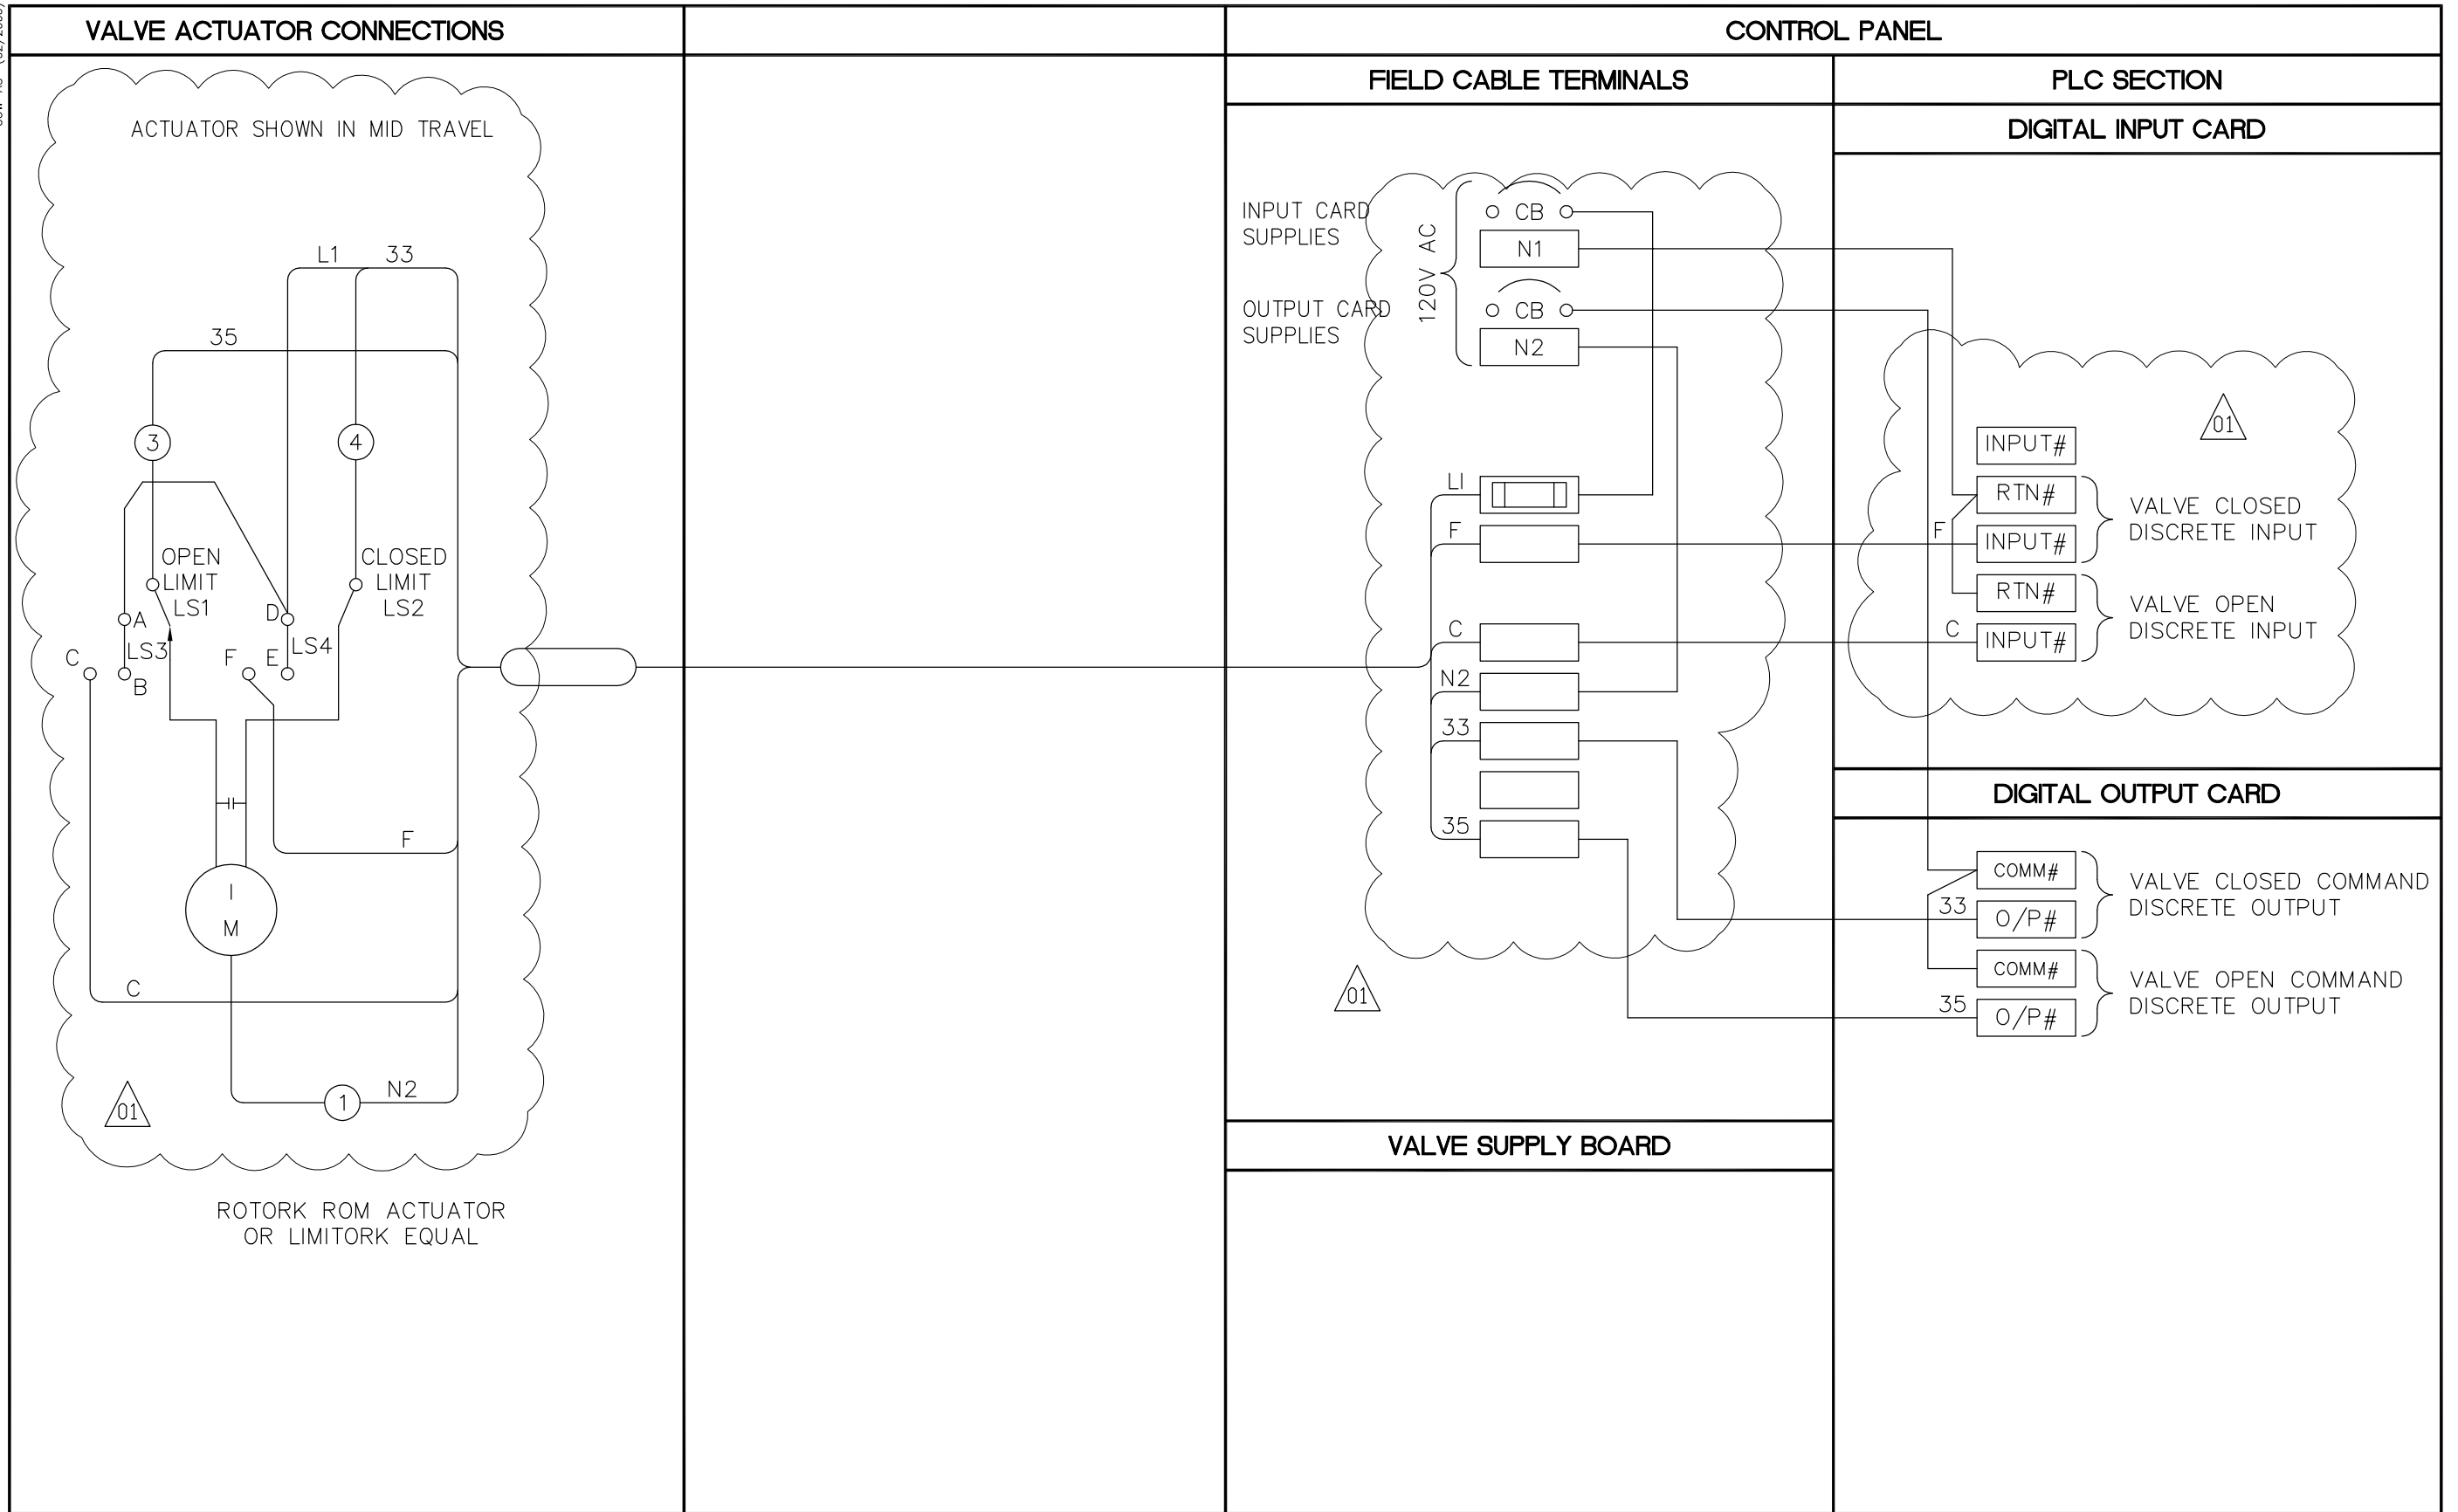

<p>APEGM Certificate of Authorization Earth Tech Canada Inc. No. 730 Expiry: April 30, 2007</p>	
--	--

<p>DESIGNED BY: NT DRAWN BY: GLG SCALE: NTS</p>		<p>CHECKED BY: SWT APPROVED BY: AHL RELEASED FOR CONSTRUCTION BY: R. SOROKOWSKI</p>	
01	792-2006 ADDENDUM 4	07/04/05	LAE
00	ISSUED FOR TENDER	07/01/31	LAE
NO.	REVISIONS	DATE	BY
		2007/01/19	

<p>ENGINEER'S SEAL ORIGINAL SIGNED BY: S.W. TORMEY 2007/01/31</p>	
<p>CONSULTANT DRAWING NO. WS-A0455</p>	

<p>THE CITY OF WINNIPEG WATER AND WASTE DEPARTMENT ENGINEERING DIVISION</p>	
<p>WATER TREATMENT PLANT BULK CHEMICAL BUILDING SODIUM HYPOCHLORITE AND CHEMICAL STORAGE BUILDING</p>	
<p>AUTOMATION / I&C MOTORIZED VALVE OPEN/CLOSE INSTRUMENTATION LOOP DIAGRAM</p>	
CITY FILE NUMBER	
SHEET OF	
CITY DRAWING NUMBER	1-0601S-H-A0455-001-01B