


COW-A3 (02/2006)

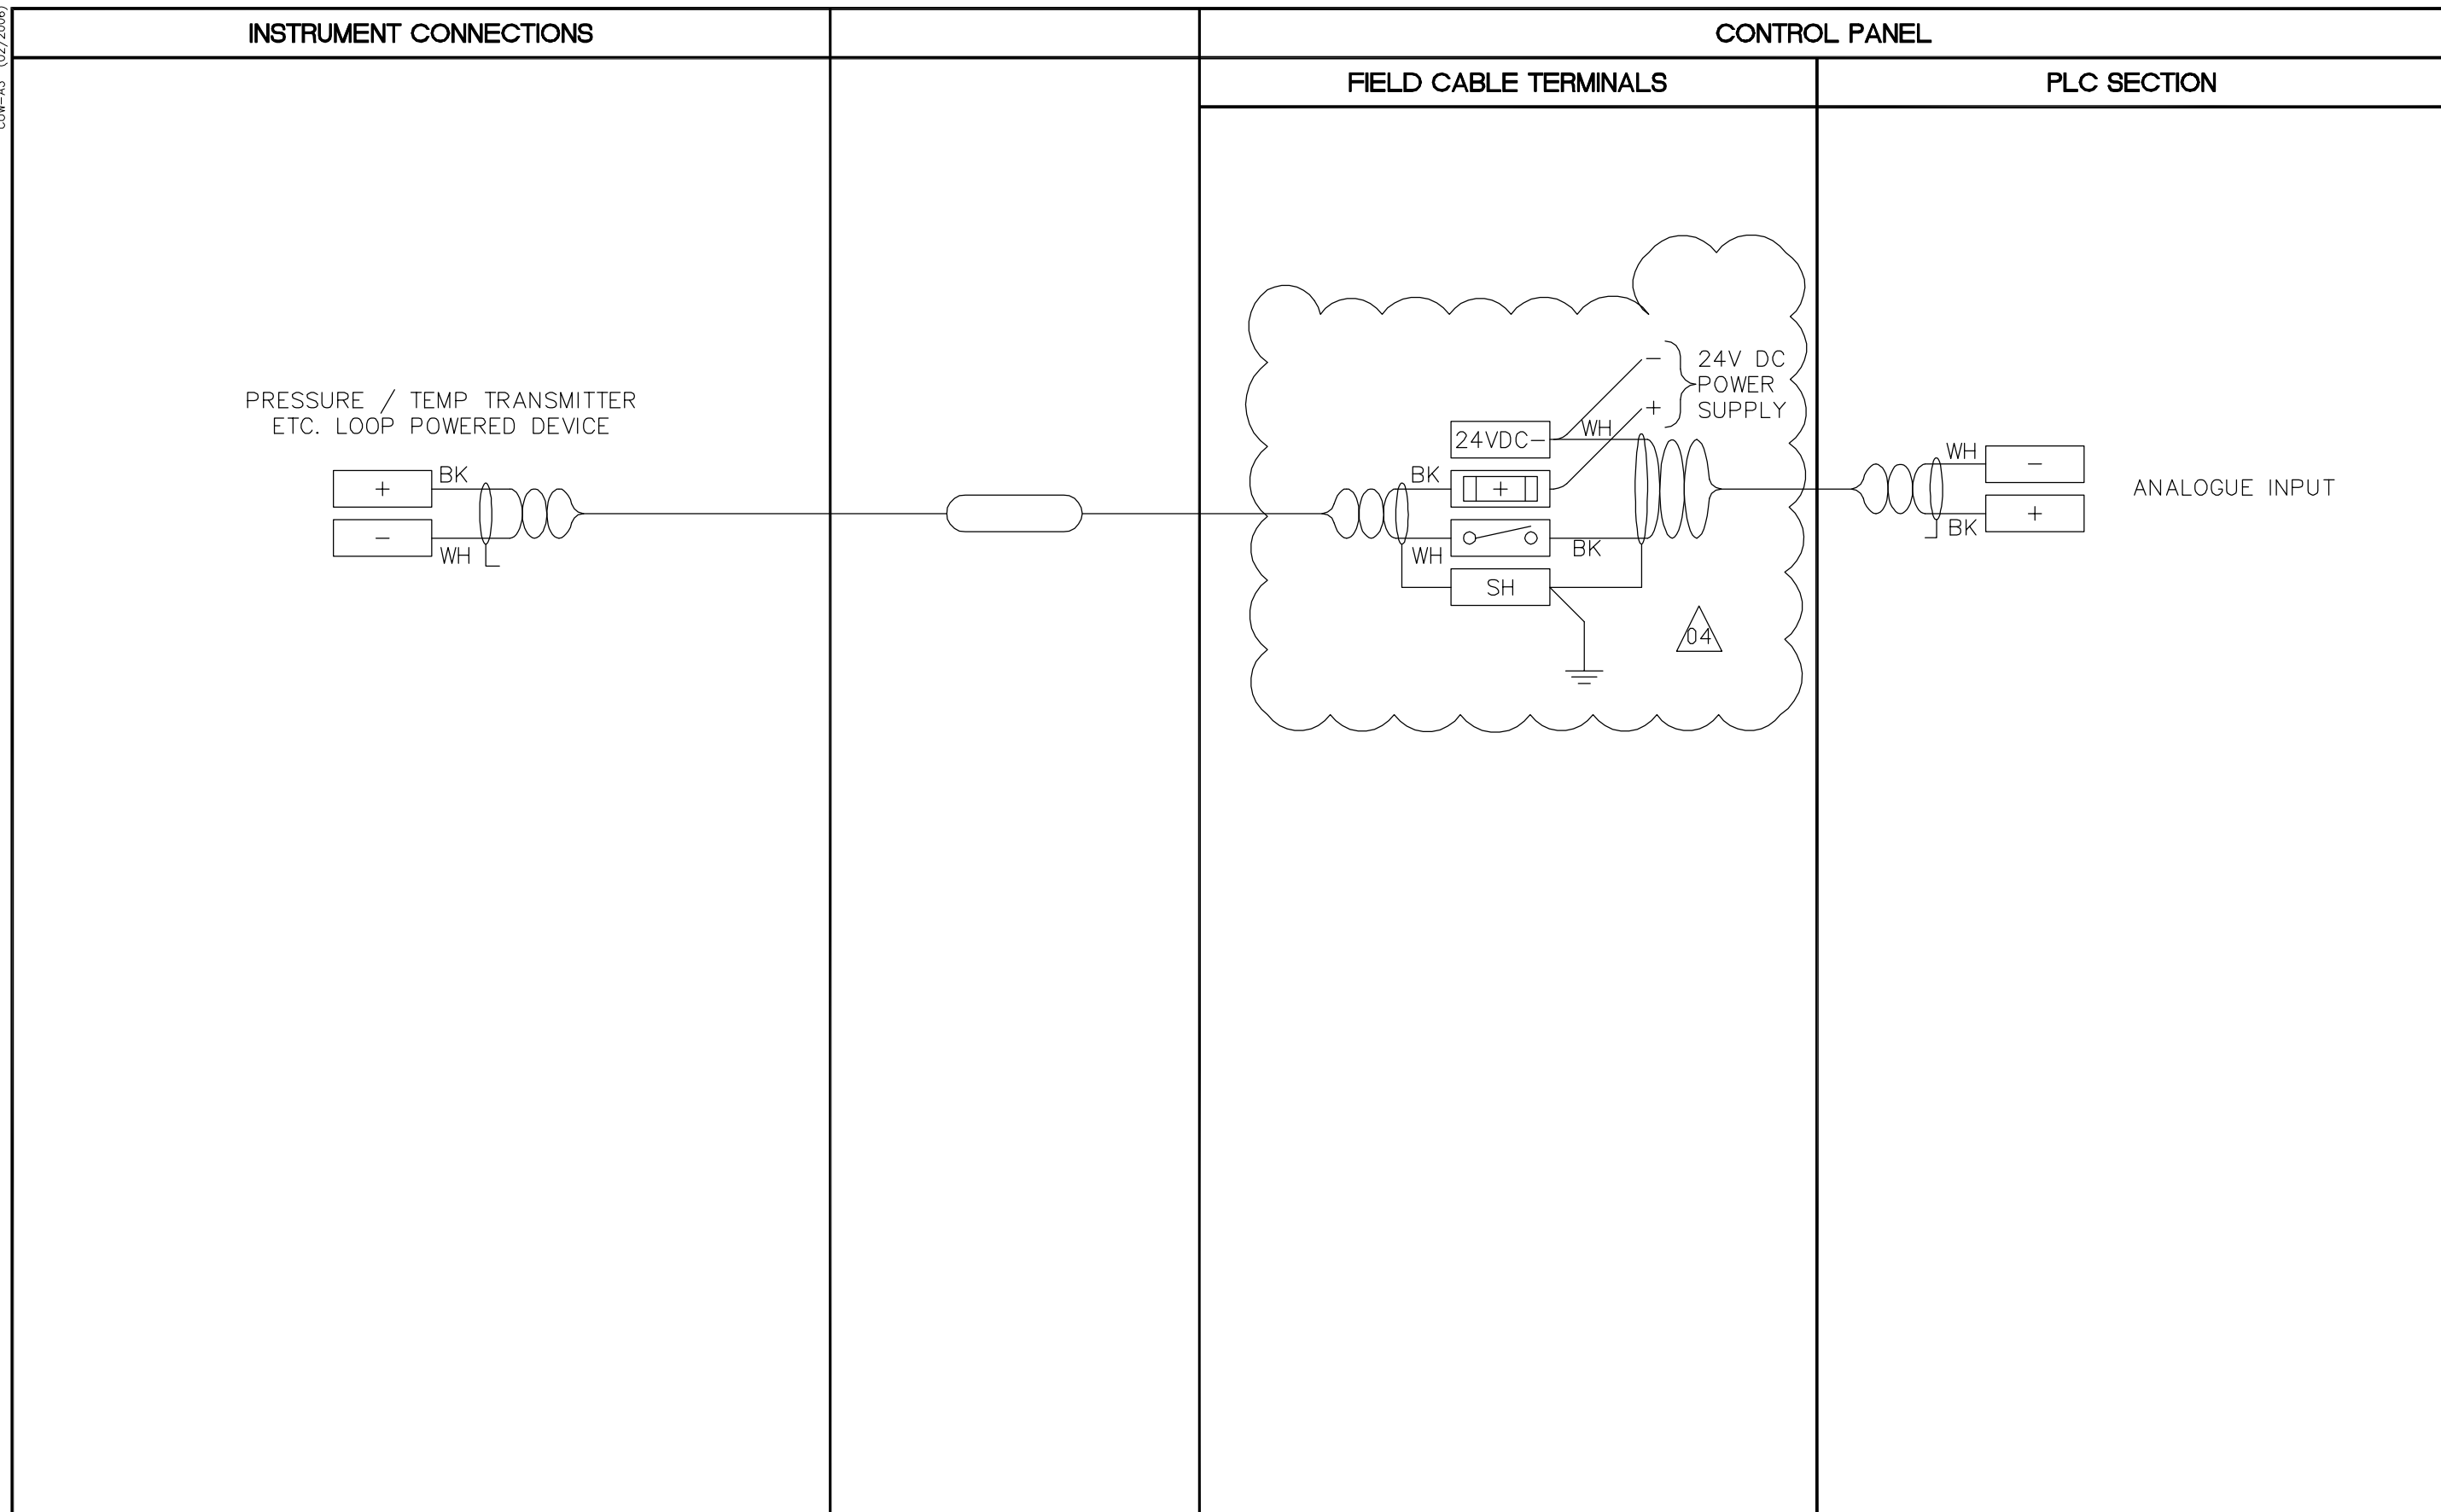

<p>APEGM Certificate of Authorization Earth Tech Canada Inc. No. 730 Expiry: April 30, 2007</p>	
--	--

B.M. ELEV.			
04	792-2006 ADDENDUM 5	07/04/11	LAE
03	35-2006 ISSUED FOR TENDER	07/03/19	LAE
02	792-2006 ISSUED FOR TENDER	07/02/15	LAE
01	ISSUED FOR CONSTRUCTION	06/07/28	JBC
00	ISSUED FOR TENDER	06/03/29	GLG
NO.	REVISIONS	DATE	BY

<p>CHEZ HILL Frederickson Cooper ARCHITECTS</p>	<p>Earth Tech ENGINEERING DIVISION</p>
DESIGNED BY: NT	CHECKED BY: SWT
DRAWN BY: GLG	APPROVED BY: AHL
SCALE: NTS	RELEASED FOR CONSTRUCTION BY: R. SOROKOWSKI
DATE: 2006/02/13	DATE: 2006/03/29

ENGINEER'S SEAL
ORIGINAL SIGNED BY
S.W. TORMEY
2006/03/29
CONSULTANT DRAWING NO. WB-A0465

<p>THE CITY OF WINNIPEG WATER AND WASTE DEPARTMENT ENGINEERING DIVISION</p>	
<p>WATER TREATMENT PLANT MAIN BUILDING MECHANICAL AND ELECTRICAL</p>	<p>CITY FILE NUMBER</p> <p>SHEET OF</p> <p>CITY DRAWING NUMBER</p> <p>1-0601B-H-A0465-001-04B</p>
<p>AUTOMATION / I&C TYPICAL LOOP POWERED ANALOGUE INPUT INSTRUMENTATION LOOP DIAGRAM</p>	