


CDW-A3 (02/2006)

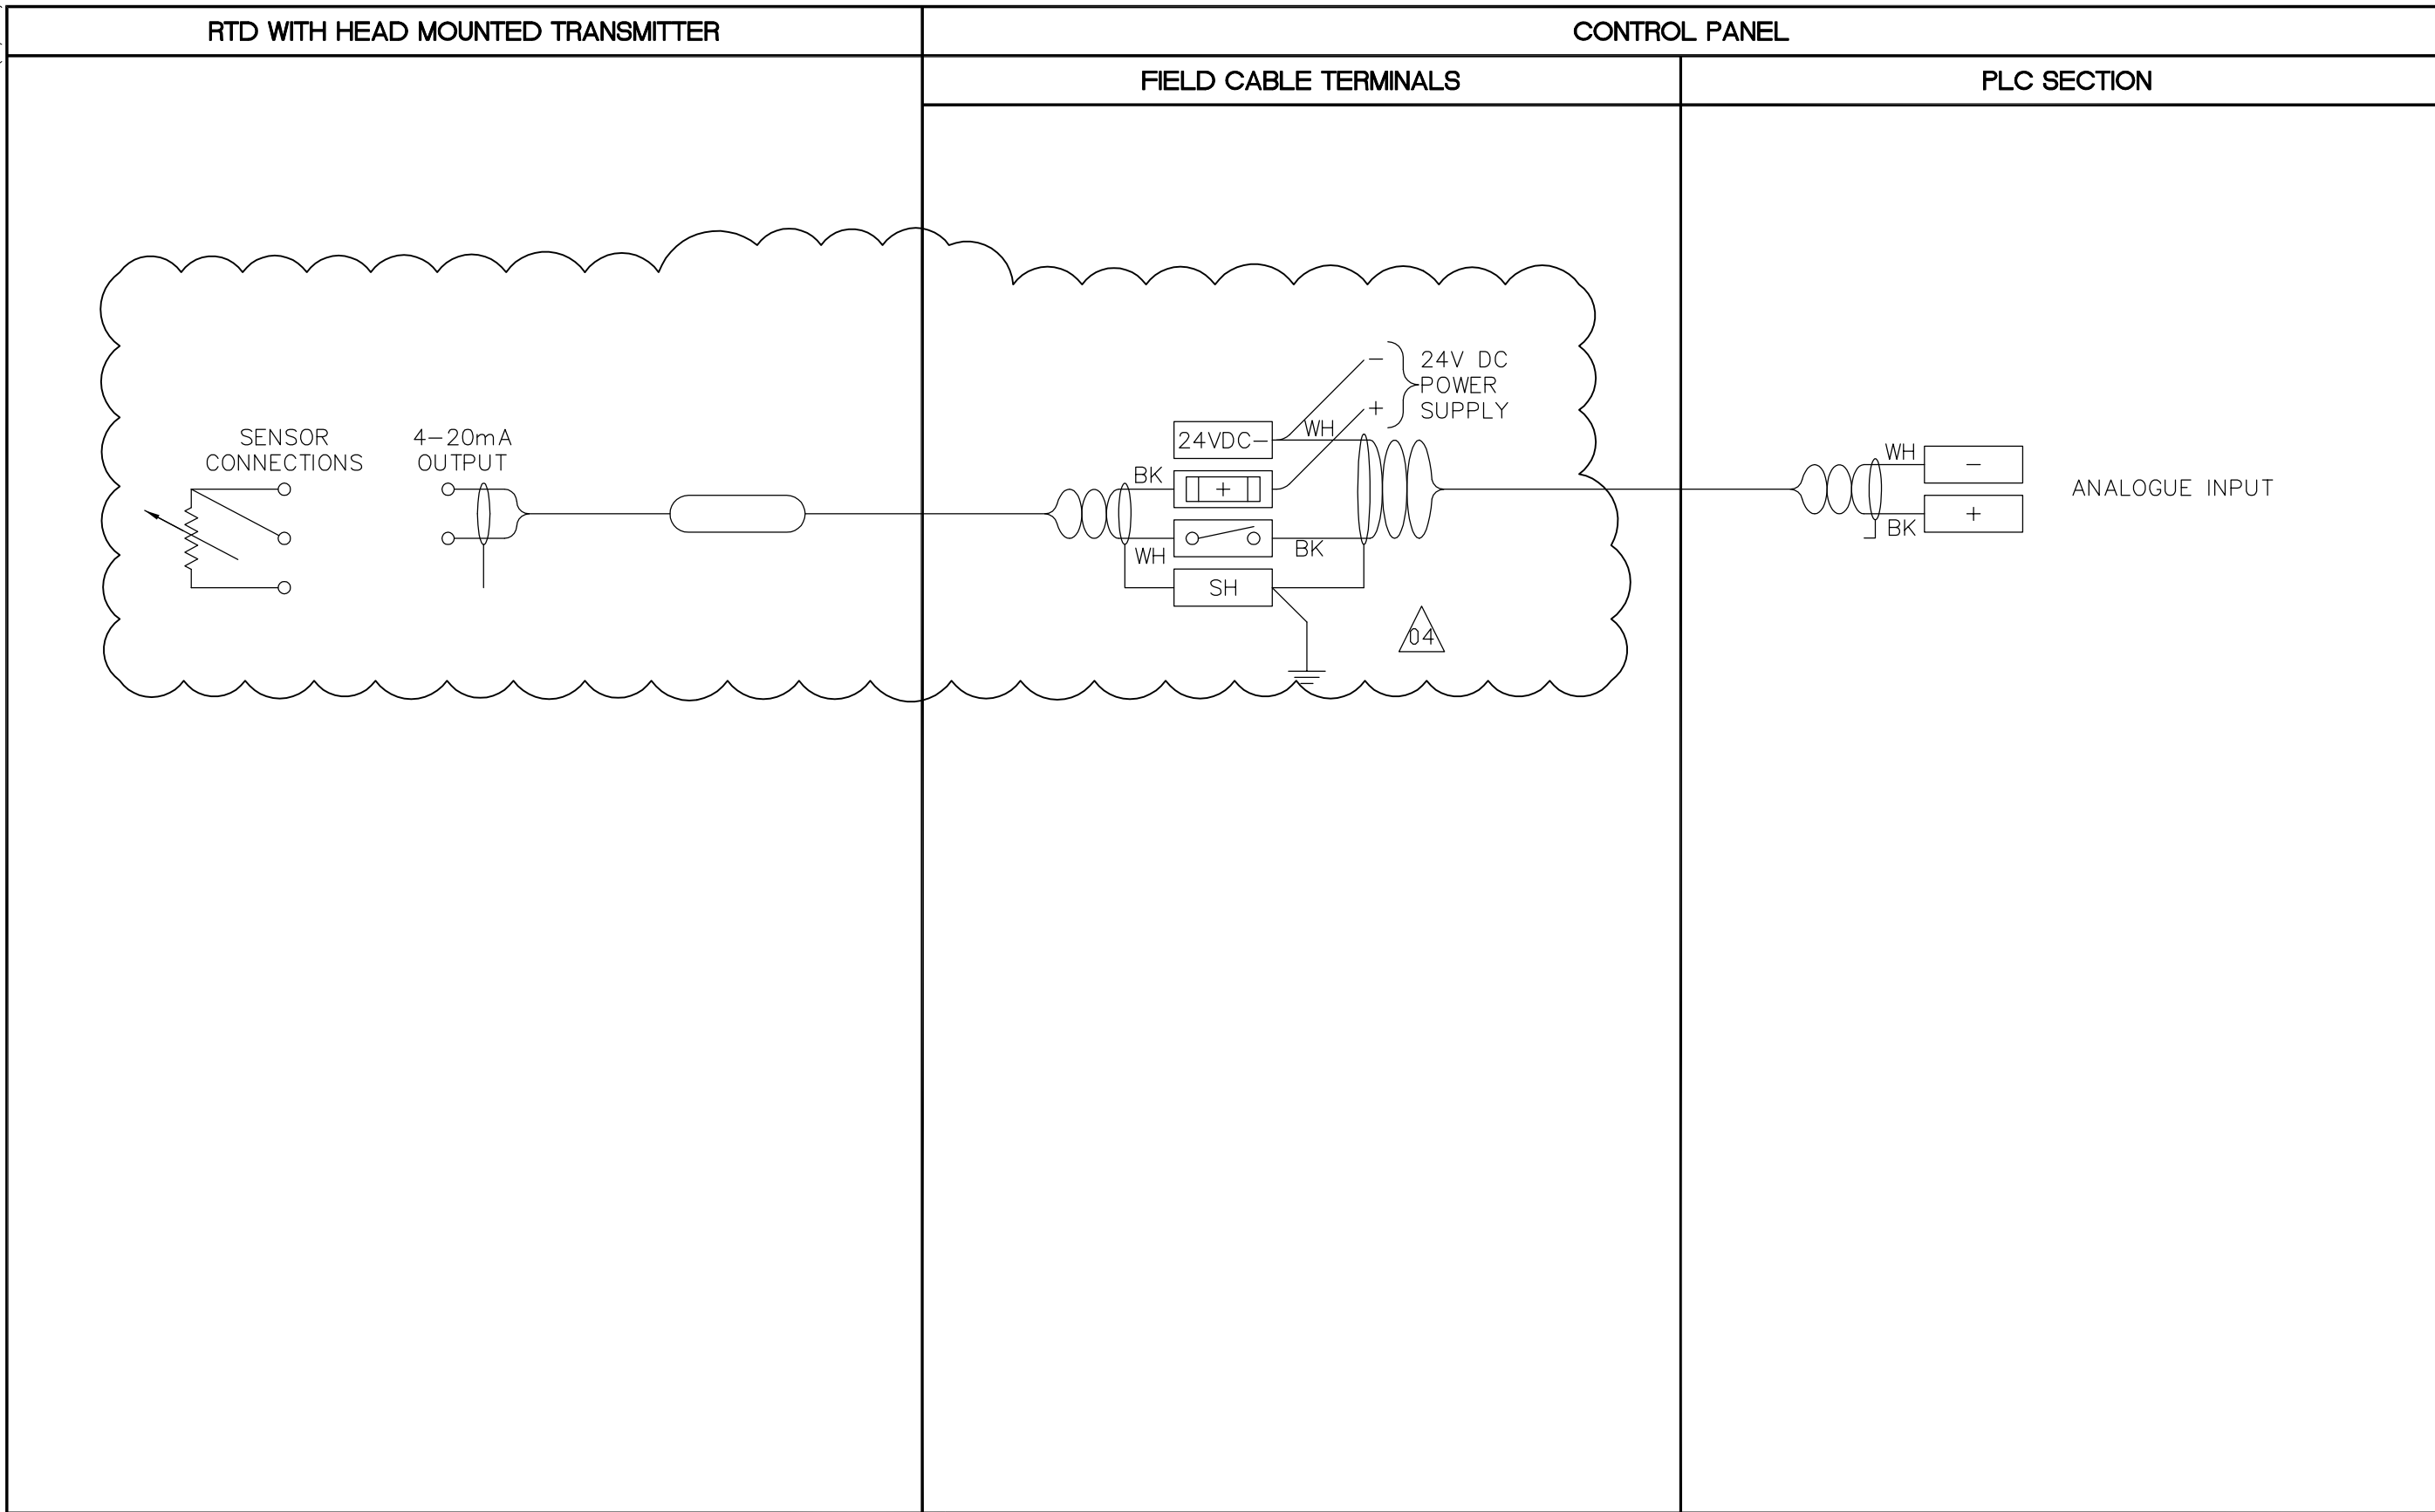

APCO
 Certificate of Authorization
 Earth Tech Canada Inc.
 No. 730 Expiry: April 30, 2007

B.M. ELEV.	DATE	BY	DESCRIPTION
	07/04/11	LAE	792-2006 ADDENDUM 5
	07/03/19	LAE	35-2006 ISSUED FOR TENDER
	07/02/15	LAE	792-2006 ISSUED FOR TENDER
	06/07/28	JBC	ISSUED FOR CONSTRUCTION
	06/03/29	GLG	ISSUED FOR TENDER
			REVISIONS

CH2M HILL Fredericson Cooper ARCHITECTS		EarthTech A Tech International Ltd. Company	
DESIGNED BY: NT	CHECKED BY: SWT	DRAWN BY: GLG	APPROVED BY: AHL
SCALE: NTS	RELEASED FOR CONSTRUCTION BY: R. SOROKOWSKI	DATE: 2006/02/13	DATE: 2006/03/29

ENGINEER'S SEAL
 ORIGINAL SIGNED BY
 S.W. TORMEY
 2006/03/29
 CONSULTANT DRAWING NO.
 WB-A0466

THE CITY OF WINNIPEG
 WATER AND WASTE DEPARTMENT
 ENGINEERING DIVISION

WATER TREATMENT PLANT
 MAIN BUILDING
 MECHANICAL AND ELECTRICAL

AUTOMATION / I&C
 TYPICAL 3 WIRE RTD
 INSTRUMENTATION LOOP DIAGRAM

CITY FILE NUMBER
 SHEET OF
 CITY DRAWING NUMBER
 1-0601B-H-A0466-001-04B