SHEET: COW-A1 (05/2005)

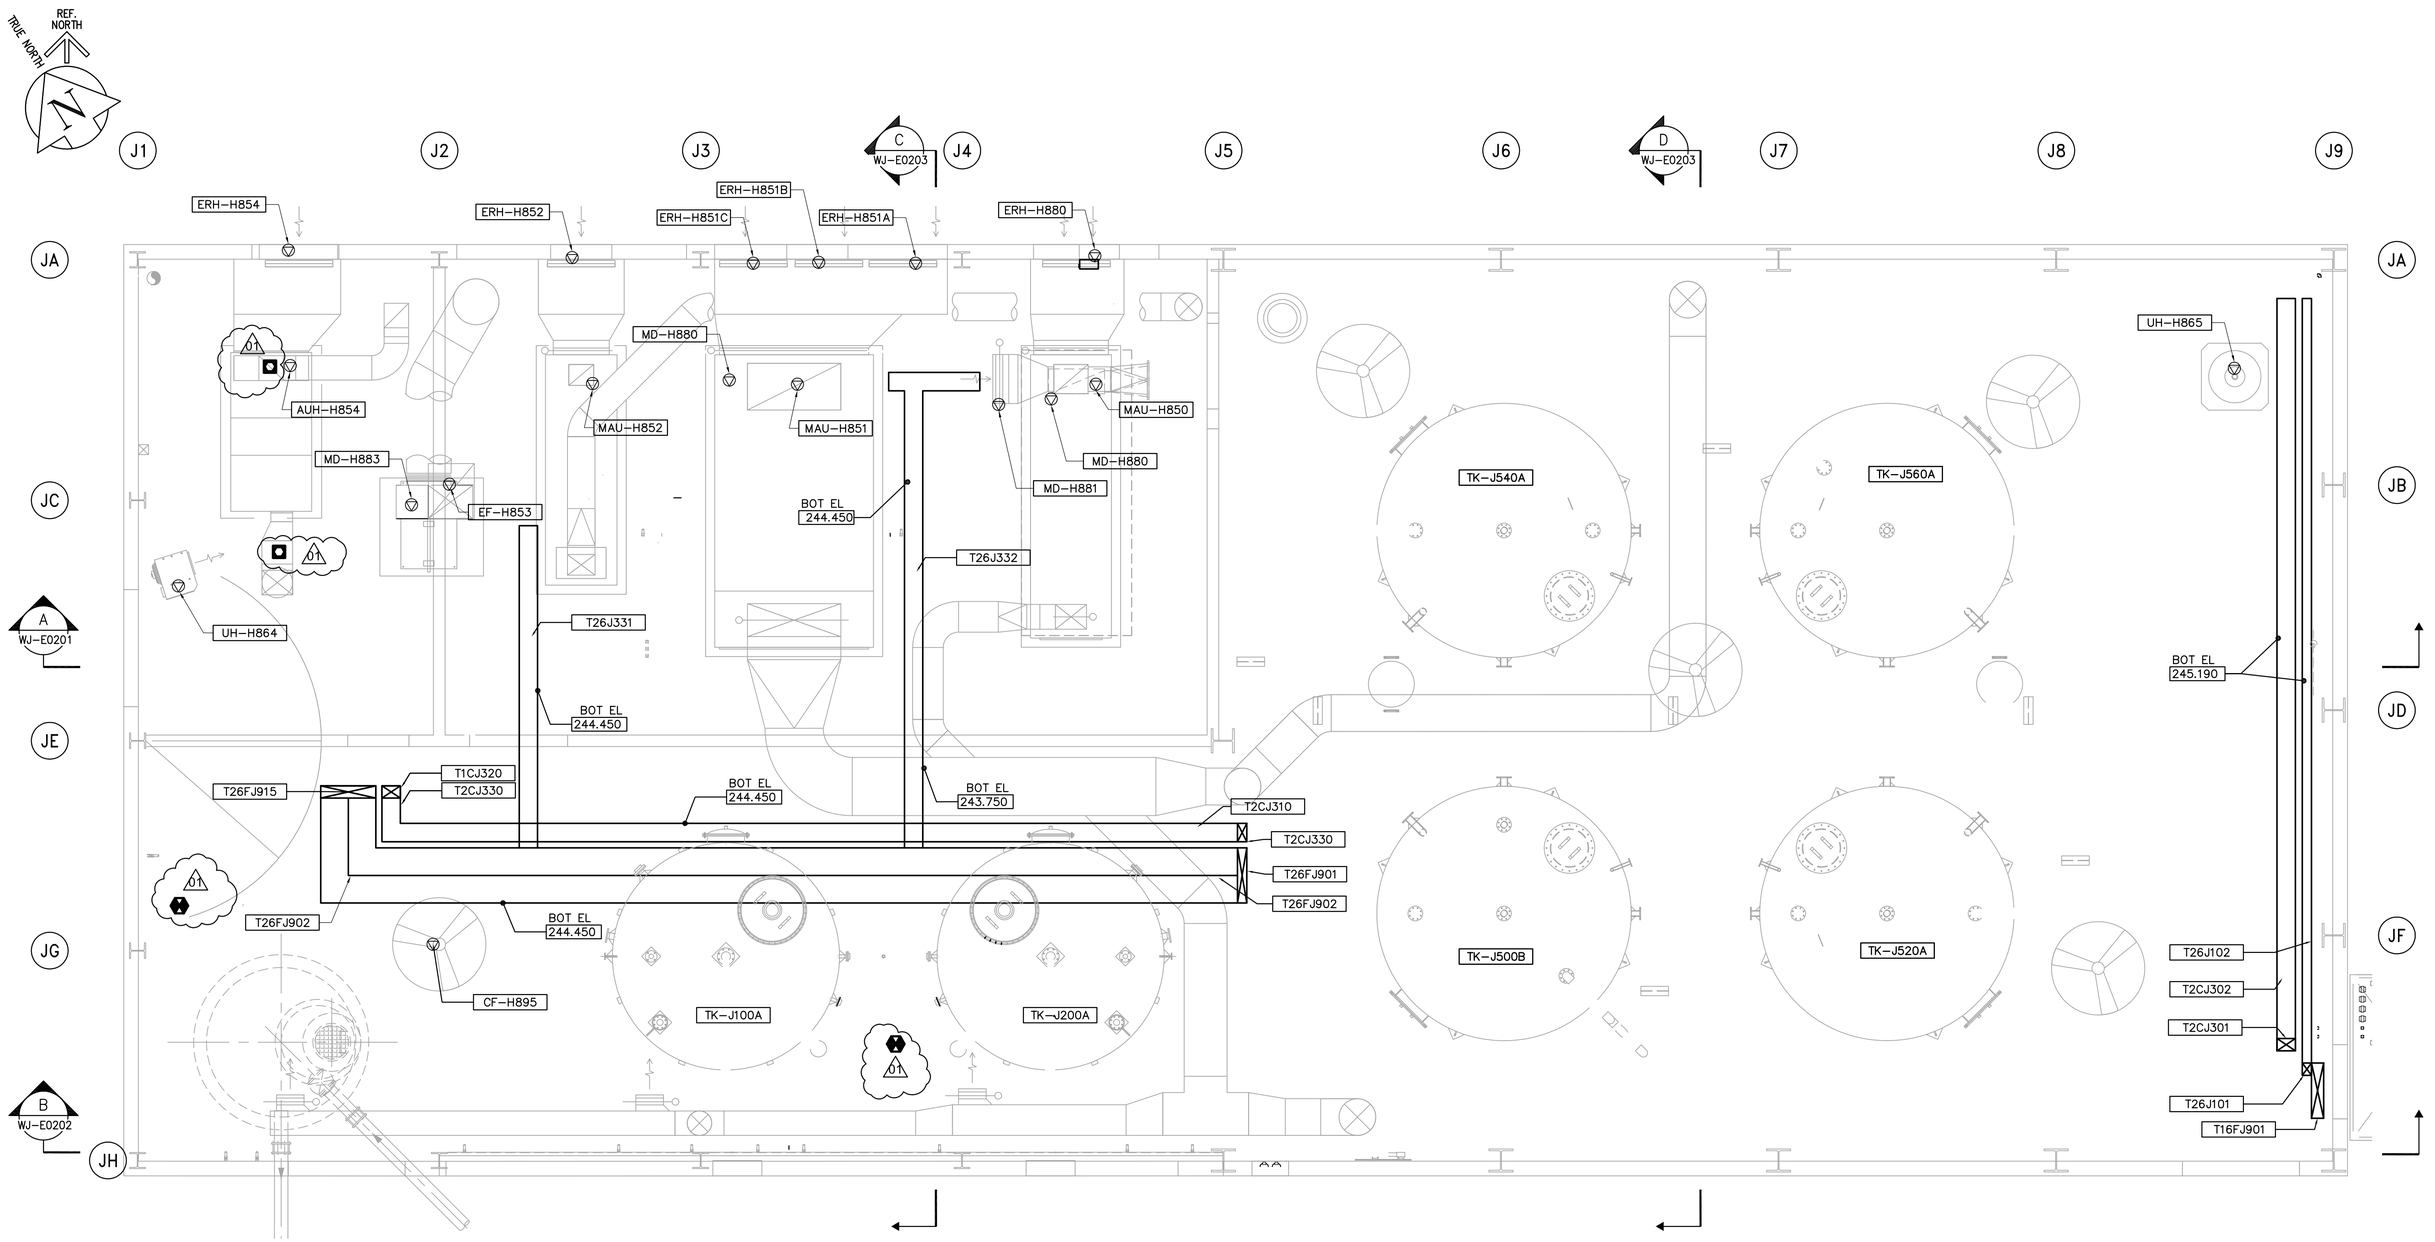

MEZZANINE FACILITY PLAN
1:50

CABLE TRAY TAGGING SEE DETAIL 3 WS-E0452

SCALE 1:50
SCALE 1:1
METRES 0 1 2 3 4 5
MILLIMETRES 0 20 40 60 80 100

- WALL MOUNTED BELL
- 01 SMOKE DETECTOR
- DUCT MOUNTED SMOKE DETECTOR
- MANUAL PULL STATION
- WALL MOUNTED HORN/STROBE
- WALL MOUNTED BELL/STROBE

B.M. ELEV.

NO.	REVISIONS	DATE	BY
01	792-2006 ADDENDUM 5	07/04/12	LL
00	ISSUED FOR TENDER	07/01/31	LL

CH2MHILL Fredericksen Cooper ARCHITECTS — EarthTech A Tyco International Ltd. Company

DESIGNED BY	LL	CHECKED BY	JRL
DRAWN BY	TL	APPROVED BY	AHL
SCALE:	1:50	RELEASED FOR CONSTRUCTION BY:	R. SOROKOWSKI
DATE	2006/08/29	DATE	2007/01/31

ENGINEER'S SEAL
ORIGINAL SIGNED BY
L.D. LLEWELLYN
2007/01/31

CONSULTANT DRAWING NO.
WJ-E0121

Winnipeg
THE CITY OF WINNIPEG
WATER AND WASTE DEPARTMENT
ENGINEERING DIVISION

WATER TREATMENT PLANT
SODIUM HYPOCHLORITE BUILDING
SODIUM HYPOCHLORITE AND CHEMICAL STORAGE BUILDINGS

ELECTRICAL
SODIUM HYPOCHLORITE BUILDING
MEZZANINE FACILITY PLAN

CITY FILE NUMBER
SHEET OF
CITY DRAWING NUMBER
1-0601J-A-E0121-001-01D

Last Save: 2007-04-12 10:17 AM

C:\DOCUMENTS AND SETTINGS\TLLEWELL\MY DOCUMENTS\NDMPROJ\321352 - WINNIPEGWTP\DN_WJ-E0121_CH2M.DWG