

5


6

6503

PILASTER DIMENSIONS & DEPTH AS PER 1/2-6. PROVIDE 5 HORIZ. 15M DOWELS EQ. SPACED TOP & BOTT. W/ MATCHING VERT. & ADDIT. 3-15M HORIZ. O.F.

EXISTING FOUNDATION

NEW GRADE BEAM FOUNDATION

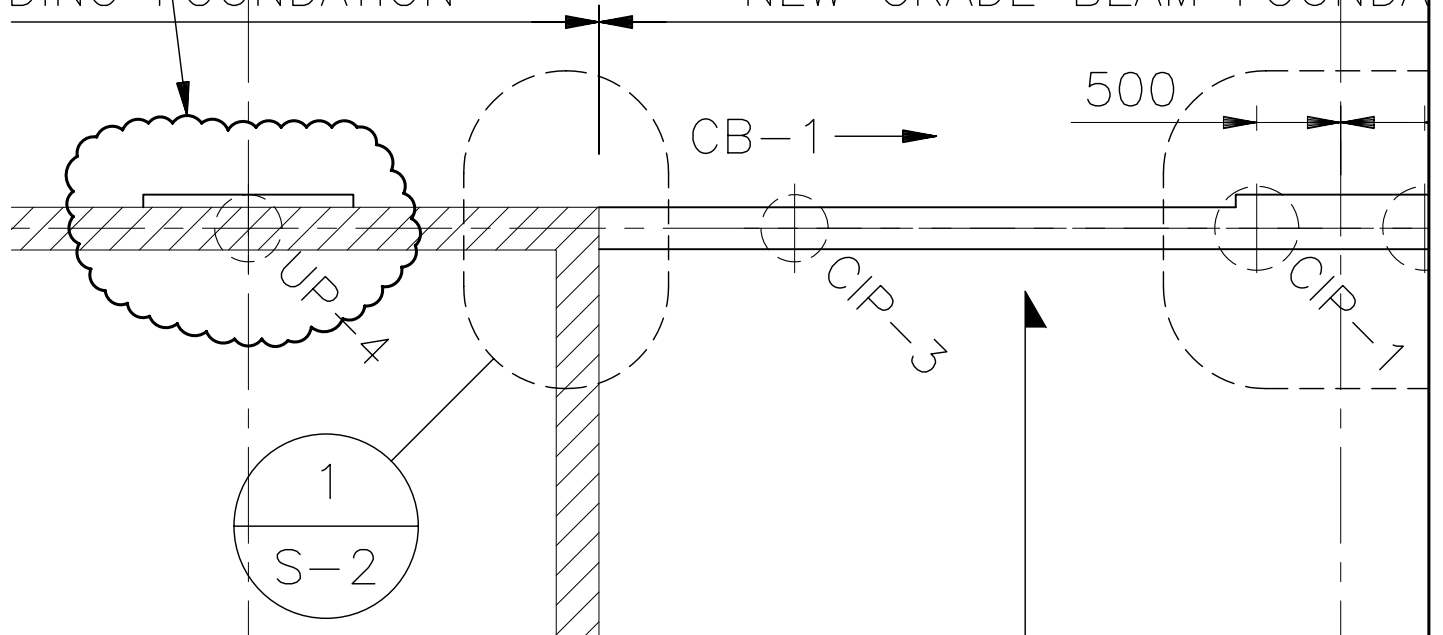

WOLFROM ENGINEERING LTD
 CONSULTING ENGINEERS
 345 WARDLAW AVENUE
 WINNIPEG, CANADA R3L 0L5
 (204)452-0041 FAX: 284-8680
 E-Mail: info@wolfromeng.com

DATE
JAN 29/08

SEAL

SCALE
N.A.

JOB TITLE
VALOUR COMMUNITY CENTRE
CONCRETE PILASTER INTO EXISTING

FILE NO.
W06440

DRAWING NO.
SK-5