


LEGEND	
	NEW THERMOSTAT
	THERMAL INSULATION
	ACOUSTIC INSULATION
	NEW DUCTWORK
	NEW LINEAR DIFFUSER
	NEW SUPPLY DIFFUSER
	NEW RETURN GRILLE
	BALANCING DAMPER
	BACKDRAFT DAMPER
	FIRE DAMPER
	MOTORIZED DAMPER
	VAV BOX
	FIRE EXTINGUISHER

**MAIN FLOOR GENERAL NOTES:**


1. THIS DRAWING IS DIAGRAMMATIC. ALL FINAL DUCTWORK ROUTING TO BE COORDINATED ON SITE BY MECHANICAL CONTRACTOR

**MAIN FLOOR DRAWING NOTES:**


- 4 KW ELECTRIC FORCE FLOW SUPPLIED BY AND INSTALLED BY DIVISION 16.
- 750 WATT ELECTRIC BASEBOARD C/W INTEGRAL THERMOSTAT SUPPLIED BY AND INSTALLED BY DIVISION 16.
- 500 WATT ELECTRIC BASEBOARD C/W INTEGRAL THERMOSTAT SUPPLIED BY AND INSTALLED BY DIVISION 16.
- NEW THERMOSTAT TO BE CONNECTED TO NEW FURNACE (F-2) IN BASEMENT AND WIRED AS PER MANUFACTURER'S RECOMMENDATIONS FOR CURRENT SET-UP.
- NEW FIRE EXTINGUISHER. REFER TO ARCHITECTURAL DRAWINGS FOR FINAL LOCATION AND QUANTITY.
- NEW 600X350 R/A DUCT UP IN ATTIC SPACE TO DROP DOWN TO MECHANICAL ROOM BELOW.
- 600X350 R/A DUCT UP IN ATTIC SPACE.
- NEW 350X300 S/A DUCT FROM BASEMENT TO RUN UP INTO ATTIC SPACE.
- EXISTING GAS METER TO REMAIN.
- NEW CEILING FAN (CF-1) IN EXPANDED METAL MESH SCREEN. REFER TO DETAIL #4/M-4.
- NEW 25# GAS LINE DOWN TO BASEMENT MECHANICAL ROOM. REFER TO DETAIL #4/M-3.
- NEW 150X150 CRAWLSPACE AIR INTAKE DUCTWORK TO RISE UP 1200MM ABOVE GRADE LEVEL TO GOOSENECK. REFER TO DETAIL #7/M-4.
- NEW 150X150 CRAWLSPACE EXHAUST DUCT UP THROUGH FLOOR. DUCT TO RISE UP 1200MM ABOVE GRADE LEVEL TO GOOSENECK.
- NEW ROUND DIFFUSER IN EXPANDED METAL MESH CEILING CAGE. REFER TO DETAIL #6/M-4.
- REFER TO DUCT SUPPORT DETAIL DRAWING #1/M-5.
- NEW 150X150 COMBUSTION AIR DUCTWORK. REFER TO COMBUSTION AIR DETAIL DRAWING #2/M-5.
- 1400MMX1000MM RELIEF AIR OPENING DUCTED FROM NEW GYM CEILING SPACE TO ROOF RELIEF HOOD COMPLETE WITH FIRE DAMPER, BACKDRAFT SENSOR AND TAMCO 9000 THERMALLY INSULATED LOW LEAK MOTORIZED DAMPER. SEE DETAIL #3/M-5. COORDINATE EXACT LOCATION ON SITE.
- PROTECTIVE ALUMINUM COVERING AND INSULATION OUTLINED IN DETAIL #1/M-5 TO BE PROVIDED ON DUCTWORK RUNNING UP ALONG EXTERIOR OF WALL.
- NEW 250X250 R/A DUCT UP IN ATTIC SPACE TO DROP DOWN TO MECHANICAL ROOM BELOW.
- NEW 250X250 S/A DUCT FROM BASEMENT TO RUN UP INTO ATTIC SPACE.
- NEW MITSUBISHI UNIT MODEL #PUY-A24NHA C/W LOW AMBIENT COOLING OPTION INSTALLED 1200MM. REFER TO ARCHITECTURAL FOR ENCLOSURE.
- CHIMNEYS TO RISE UP FROM BASEMENT MECHANICAL ROOM AND THROUGH ROOF. TERMINATE CHIMNEYS AS PER CODE REQUIREMENTS.

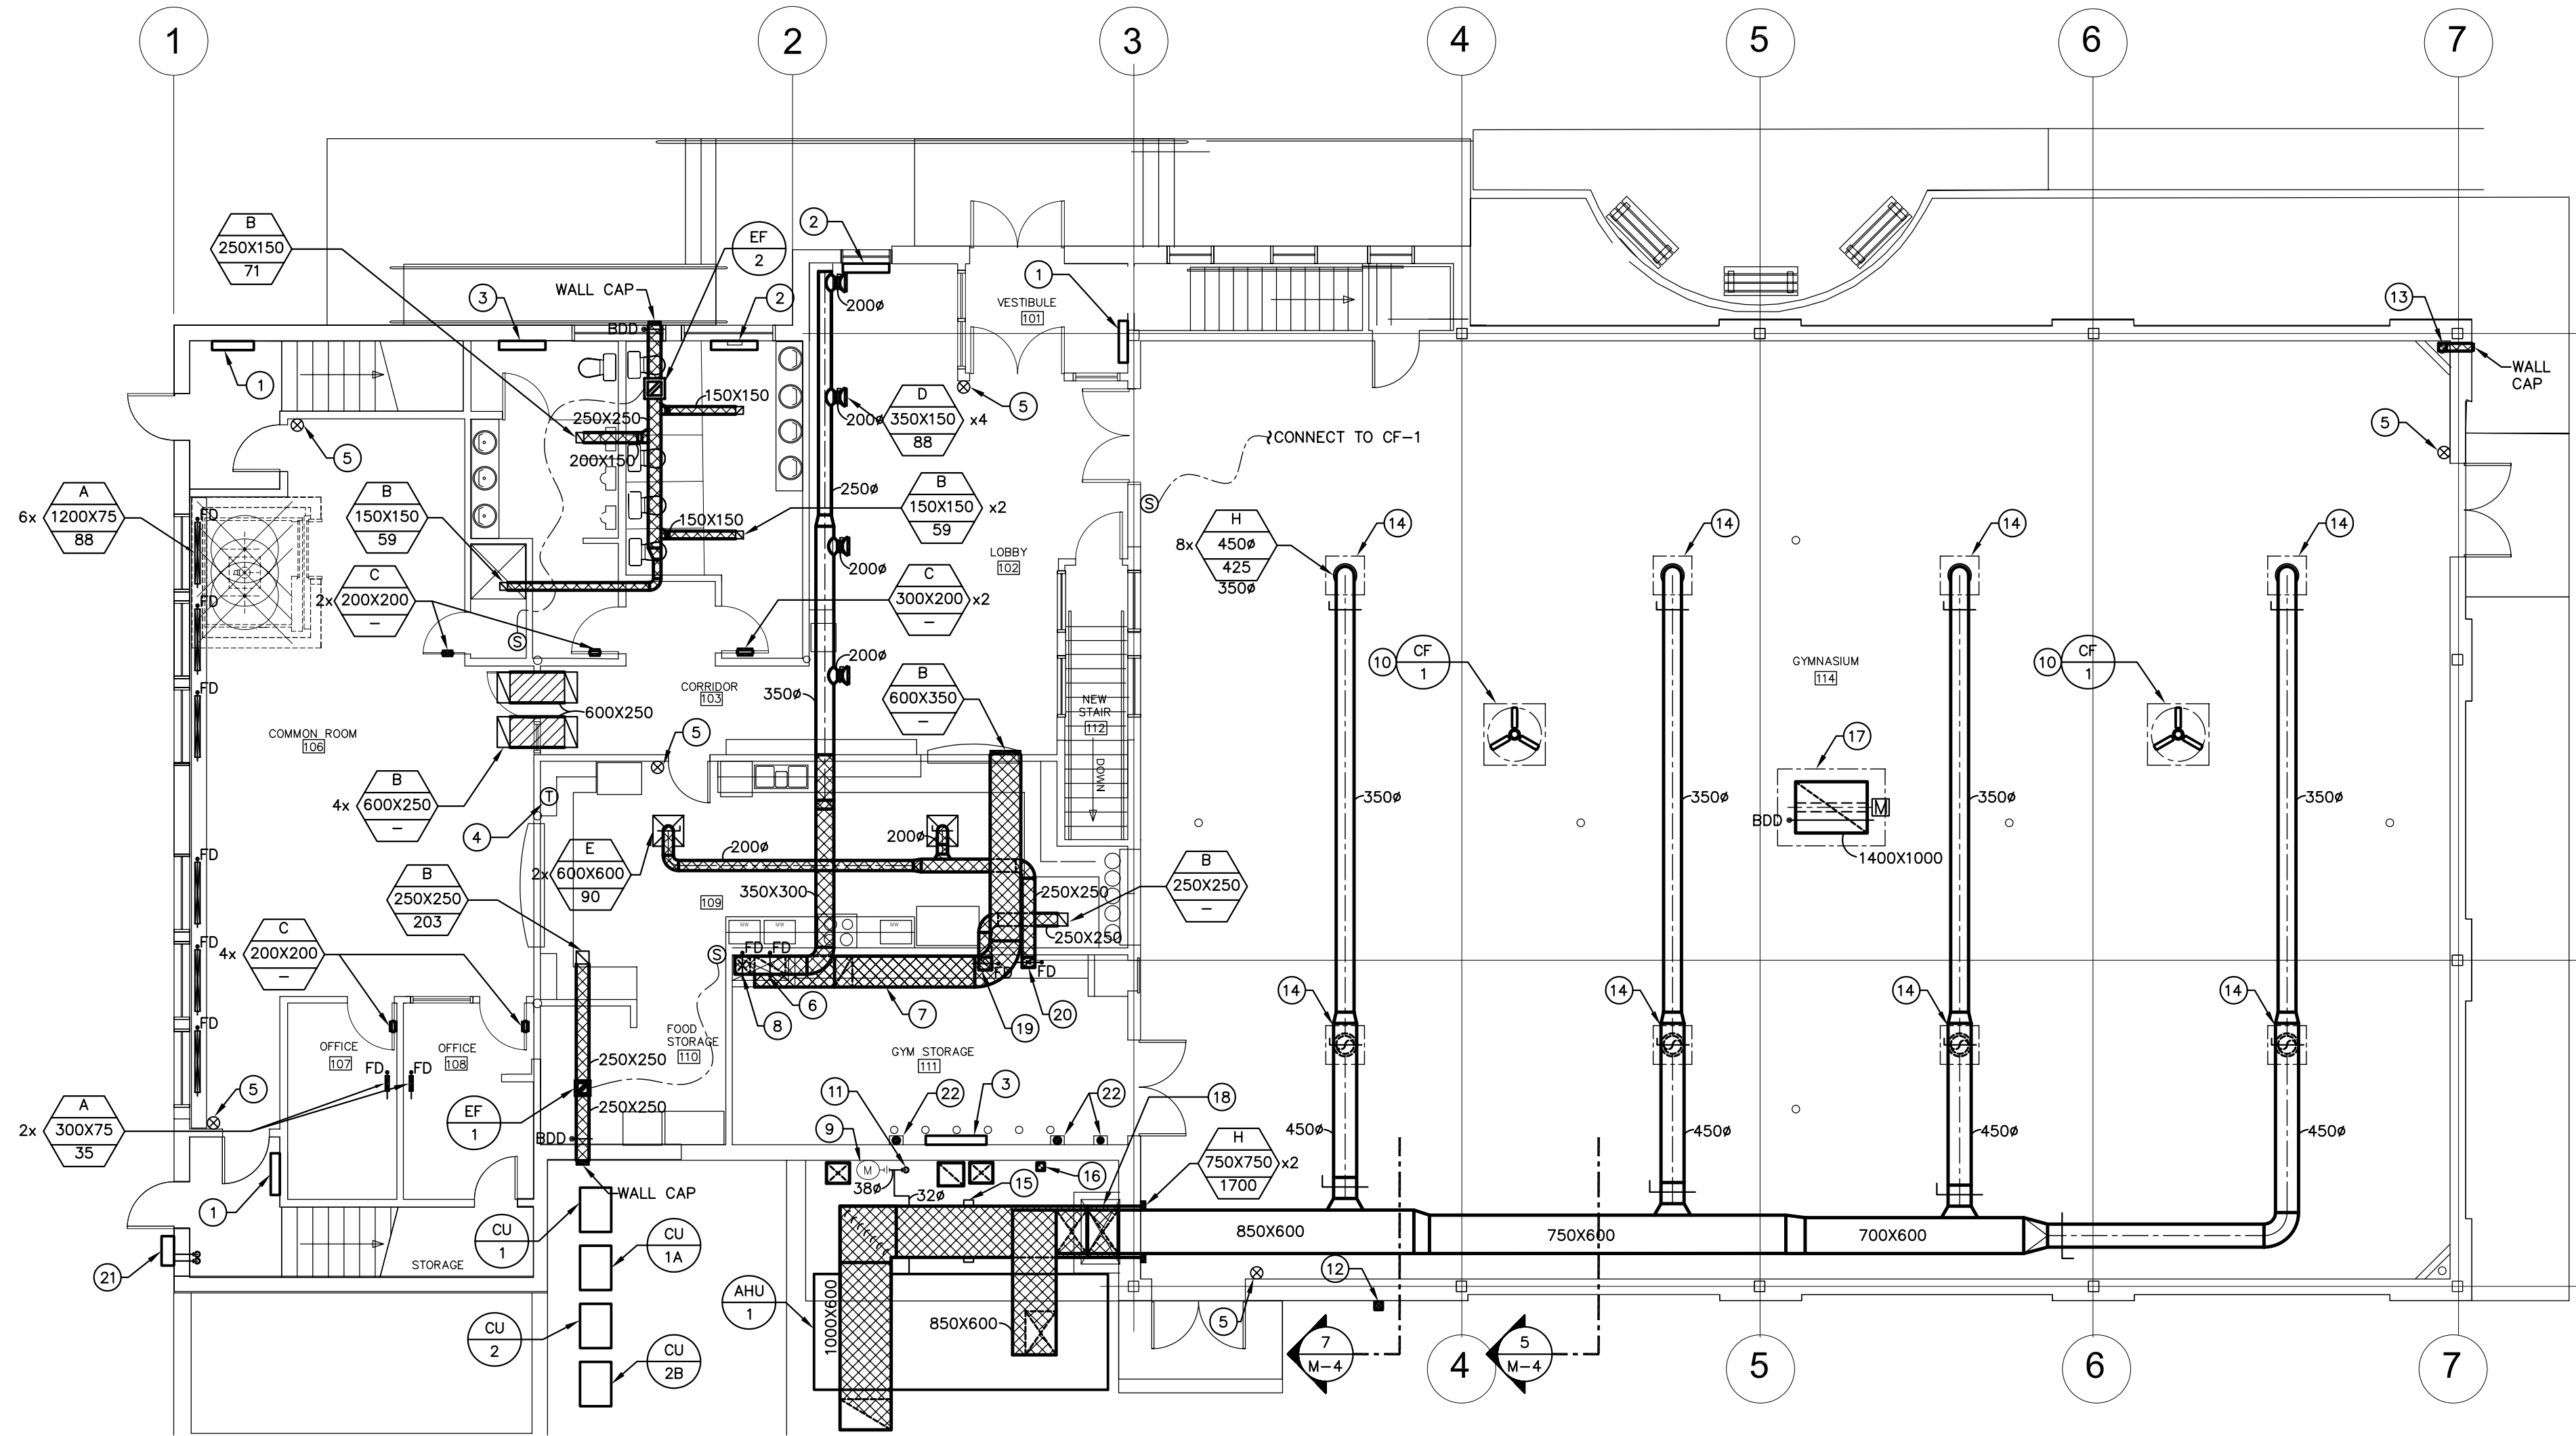

1 MAIN FLOOR HVAC RENOVATION PLAN  
SCALE: 1:100

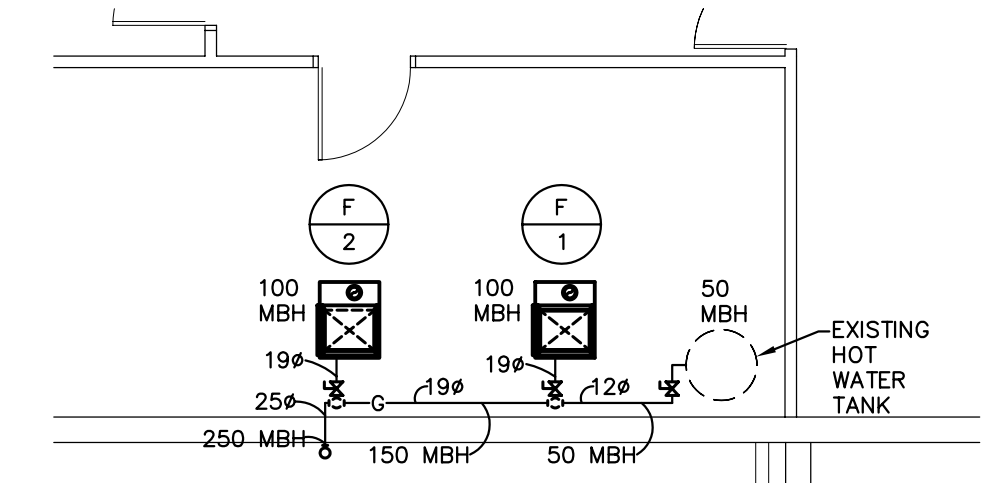

4 GAS PIPING LAYOUT  
SCALE: 1:75

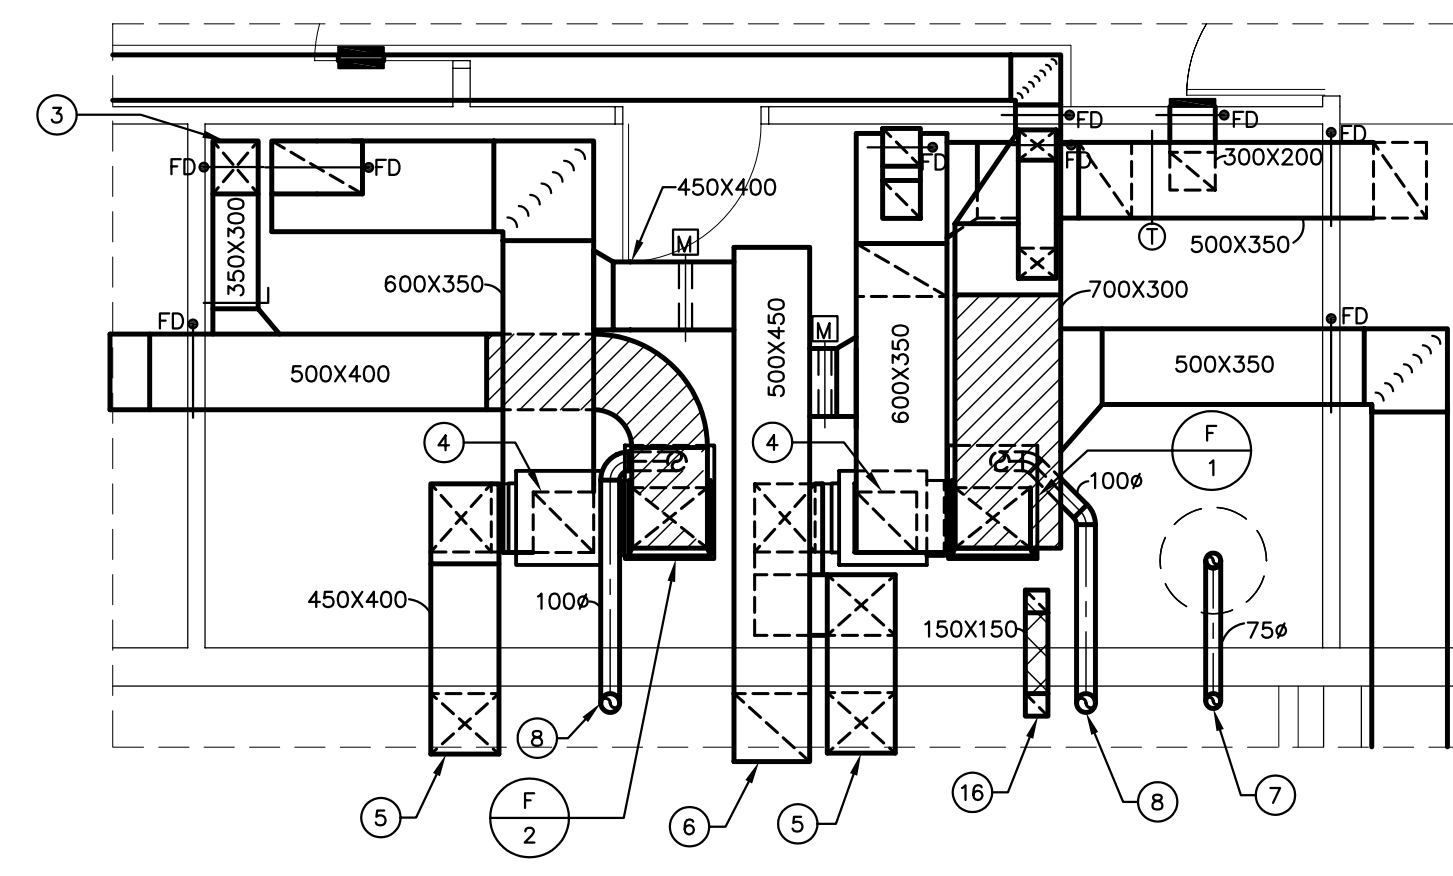


3 ENLARGED BASEMENT FURNACE ROOM PLAN  
SCALE: 1:50

**BASEMENT GENERAL NOTES:**

1. THIS DRAWING IS DIAGRAMMATIC. ALL FINAL DUCTWORK ROUTING TO BE COORDINATED ON SITE BY MECHANICAL CONTRACTOR

**BASEMENT DRAWING NOTES:**

- NEW 150# DUCTWORK TO RUN WITHIN JOIST SPACE AND SUPPLY FLOOR GRILLES ON MAIN FLOOR.
- NEW THERMOSTAT TO BE CONNECTED TO NEW FURNACE (F-1) IN BASEMENT AND WIRED AS PER MANUFACTURER'S RECOMMENDATIONS FOR CURRENT SET-UP.
- NEW 350X300 S/A TO RISE UP TO MAIN FLOOR.
- NEW 400X400 R/A DUCT DOWN TO ECONOMIZER.
- NEW 450X400 O/A INTAKE DUCTWORK. REFER TO DETAIL #1/M-4.
- NEW 500X450 RELIEF AIR DUCT. REFER TO DETAIL #1/M-4.
- NEW 75# CHIMNEY VENT FROM EXISTING GAS FIRED HOT WATER TANK. REFER TO DETAIL #1/M-4.
- NEW 100# CHIMNEY VENT FROM NEW GAS FIRED FURNACE (F-1 & F-2). REFER TO DETAIL #1/M-4.
- NEW 3KW ELECTRIC UNIT HEATER. SUPPLIED AND INSTALLED BY DIVISION 16.
- NEW 150X150 CRAWLSPACE VENTILATION INTAKE DUCT C/W WITH GOOSENECK UP THROUGH AREA WELL. TERMINATE GOOSENECK MINIMUM 1200MM ABOVE FINISHED GRADE.
- NEW MOTORIZED DAMPER TO BE INTERLOCKED WITH CRAWLSPACE EXHAUST FAN AND CONTROLLED WITH HUMIDISTAT.
- NEW CRAWLSPACE EXHAUST FAN TO DISCHARGE UP THROUGH AREA WELL C/W GOOSENECK. TERMINATE GOOSENECK MINIMUM 1200MM ABOVE FINISHED GRADE.
- REFER TO DRAWING #3/M-3 FOR ENLARGED FURNACE LAYOUT.
- 150X150 COMBUSTION AIR DUCTWORK. REFER TO DETAIL ON M-4.
- NEW FIRE EXTINGUISHER. REFER TO ARCHITECTURAL DRAWINGS FOR FINAL LOCATION AND QUANTITY.
- NEW MITSUBISHI UNIT MODEL #PCA-A24GA C/W SLIM SMART REMOTE INSTALLED TIGHT TO UNDERSIDE OF BULKHEAD. SLIM SMART REMOTE LOCATION TO BE COORDINATED ON SITE BY MECHANICAL CONTRACTOR.
- REFRIGERANT PIPING TO RISE UP TO MAIN FLOOR

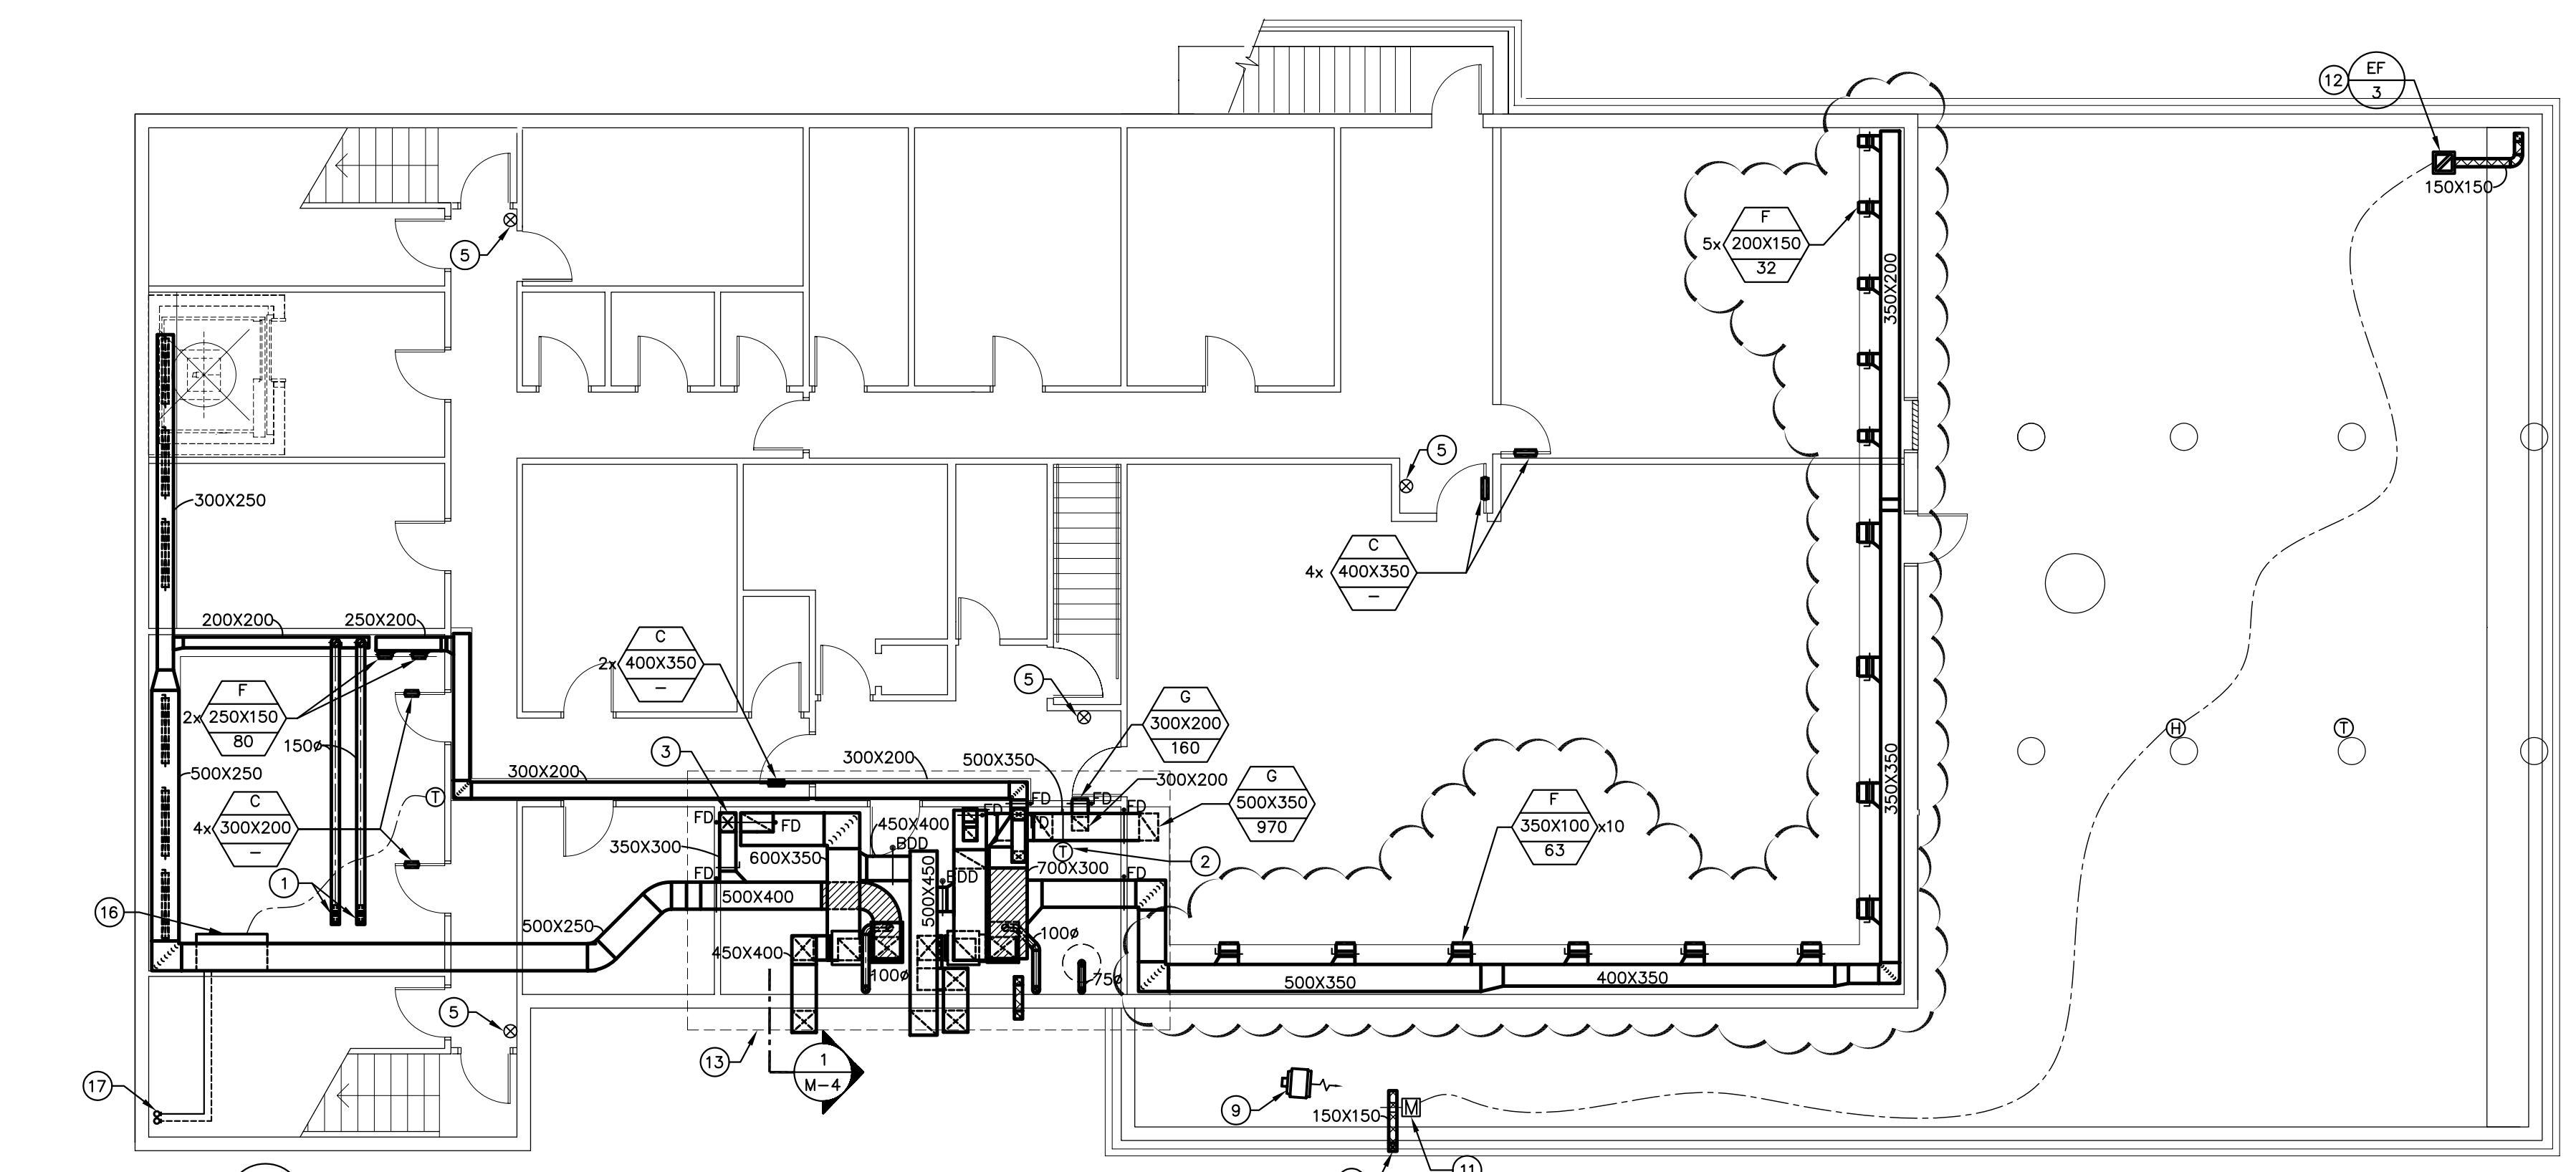

2 BASEMENT HVAC RENOVATION FLOOR PLAN  
SCALE: 1:100

3 ISSUED FOR TENDER SR 2007.11.14  
2 ISSUED FOR 100% REVIEW DG 2007.07.06  
1 ISSUED FOR 99% REVIEW DG 2007.06.29  
revisions

This drawing must not be scaled.  
The general Contractor must verify all dimensions, patterns and revers prior to commencement of work. All errors and omissions must be reported immediately to the Architect.  
Variations and modifications to work shown on this drawing shall not be carried out without written permission from the Architect.  
This drawing is the exclusive property of the Architect and cannot be reproduced without written permission of the Architect. Reproduction must bear the name of the Architect. Copyright © 2006.

engineers  
**MCW / AGE**  
Consulting Professional Engineers  
210-1621 Wellington Avenue  
Winnipeg, Manitoba R3H 0G4  
Phone: (204) 779-7900 Fax: (204) 779-1119  
E-Mail: mcw\_age@mcw-ars.com  
5603

architect  
**HAROLD FUNK ARCHITECT INC.**  
#200-55 Donald Street  
Winnipeg, Manitoba  
Canada R3C 1L6  
Tel: 204 943 5087  
Fax: 204 949 9231  
E-mail: hfunkarch@mts.net

project  
**VALOUR COMMUNITY CENTRE GYMNASIUM ADDITION AND RENOVATIONS**  
715 Teller St. North, Winnipeg, Manitoba  
sheet title

**MAIN & BASEMENT FLOORS H.V.A.C. LAYOUT**  
project no. 5603  
scale: AS SHOWN  
drawn by: RK  
approved by: SR  
date July 6, 2007  
sheet no.  
**M-3 R1**