





NOTES:
 NORTH REPAIR GARAGE
 CONCRETE SLAB TO BE
 DEMOLISHED (8305 SQ.FT.)
 & REMOVED FOR NEW 8"
 CONCRETE SLAB

HOIST TO BE
 TEMPORARILY STORED ON
 SITE DURING
 CONSTRUCTION

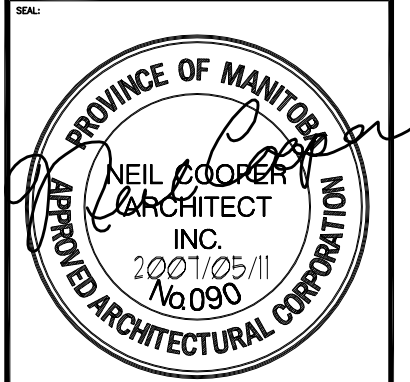

REV	DESCRIPTION	DATE	BY
1	ADDENDUM 2	JUN 11, 2007	DG
0	ISSUED FOR TENDER	MAY 11, 2007	DG

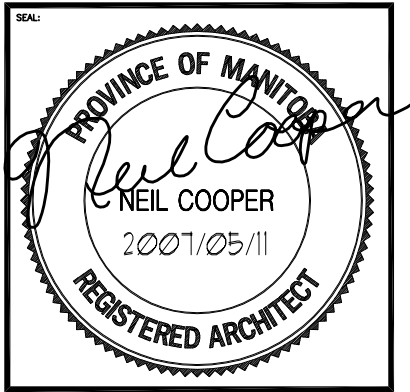


THIS DRAWING MUST NOT BE SCALED.
 THE CONTRACTOR SHALL VERIFY ALL DIMENSIONS, DATUMS AND LEVELS PRIOR TO COMMENCEMENT OF WORK AND IS HELD RESPONSIBLE FOR REPORTING ANY DISCREPANCY OR OMISSION TO THE CONTRACT ADMINISTRATOR IMMEDIATELY.
 THIS DRAWING IS THE EXCLUSIVE PROPERTY OF NEIL COOPER ARCHITECT INC AND CAN BE REPRODUCED ONLY WITH THE PERMISSION OF NEIL COOPER ARCHITECT INC, IN WHICH CASE THE REPRODUCTION MUST BEAR THEIR NAME AS THE ARCHITECTURAL FIRM.

DRAWING: **DEMOLITION - PARTIAL MAIN FLOOR PLAN**

PROJECT: **195 TECUMSEH O/H DOOR & CONCRETE SLAB REPLACEMENT WINNIPEG, MANITOBA**

Neil Cooper Architect Inc.
 10-395 Berry Street, Winnipeg, Manitoba R3J 1N6

DRAWN BY: DG	CHECKED BY: NC	SHEET NO: A1.1R1	REV NO:
DATE: FEB 28, 2007			
SCALE: As Noted			
FILE: 06069/Contract Doc/Contract Dwgs/Arch Dwgs/A1.1R1.dwg			

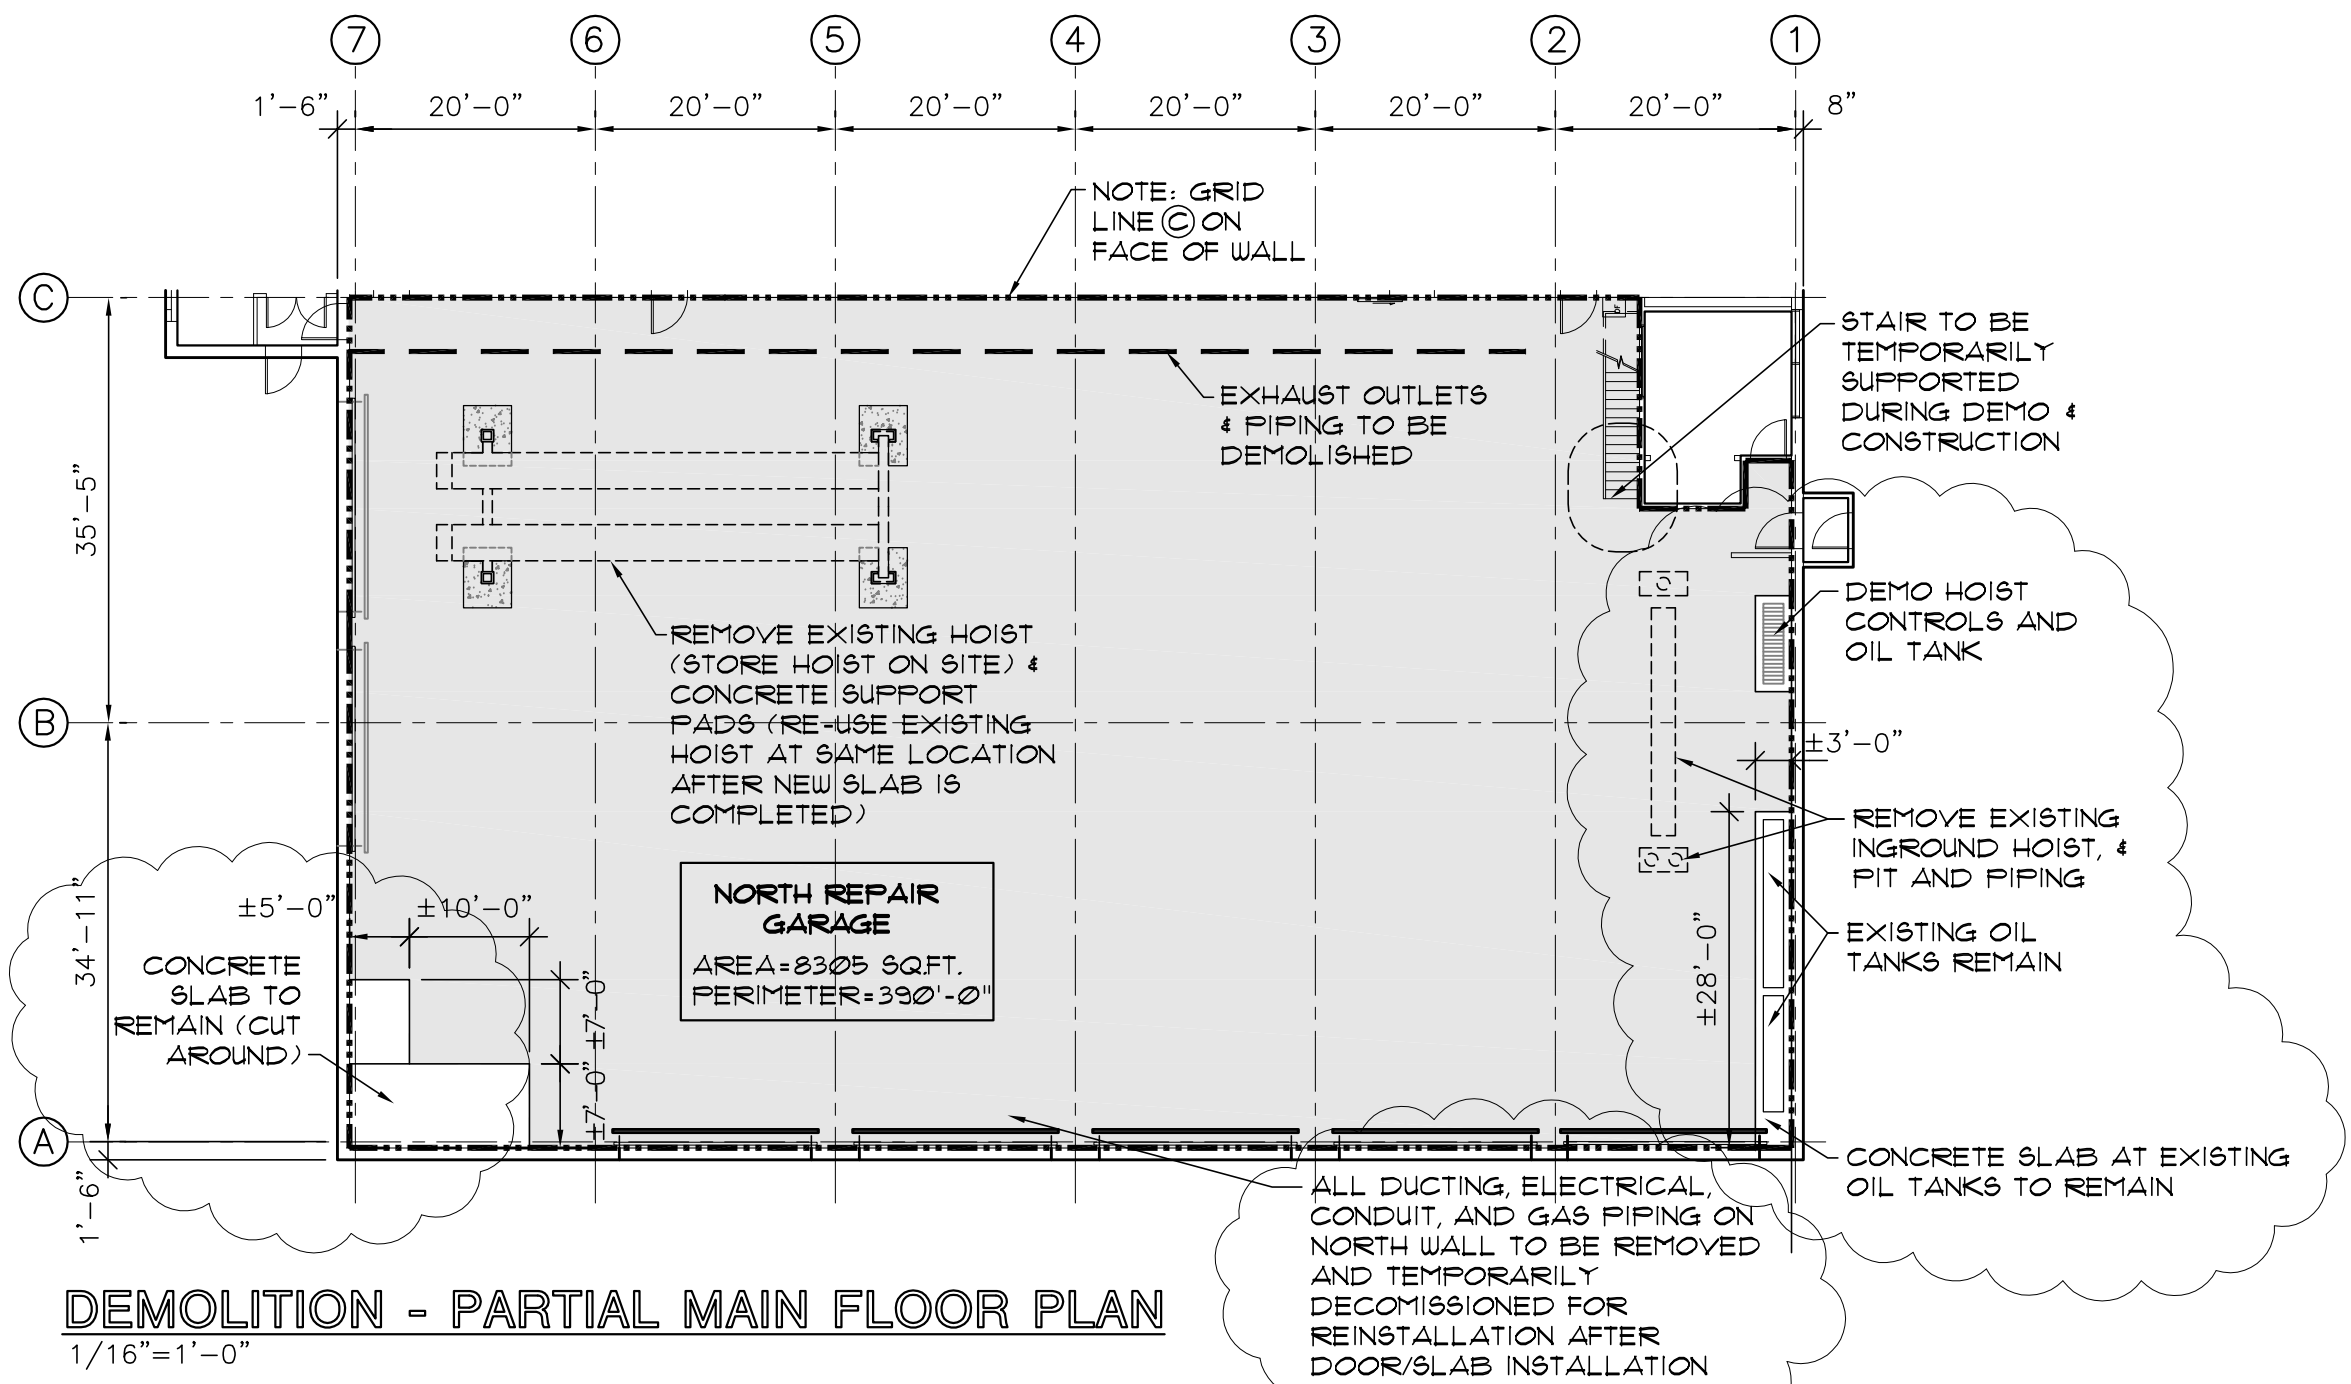

DEMOLITION - PARTIAL MAIN FLOOR PLAN
 1/16" = 1'-0"