



D SIZE 22" x 34" (559mm x 864mm)

PLOT: /131/2008 9:40:14 AM

NCA FILE NAME: A0007-AR BLDG SEC2.dwg Saved By: amefco_j

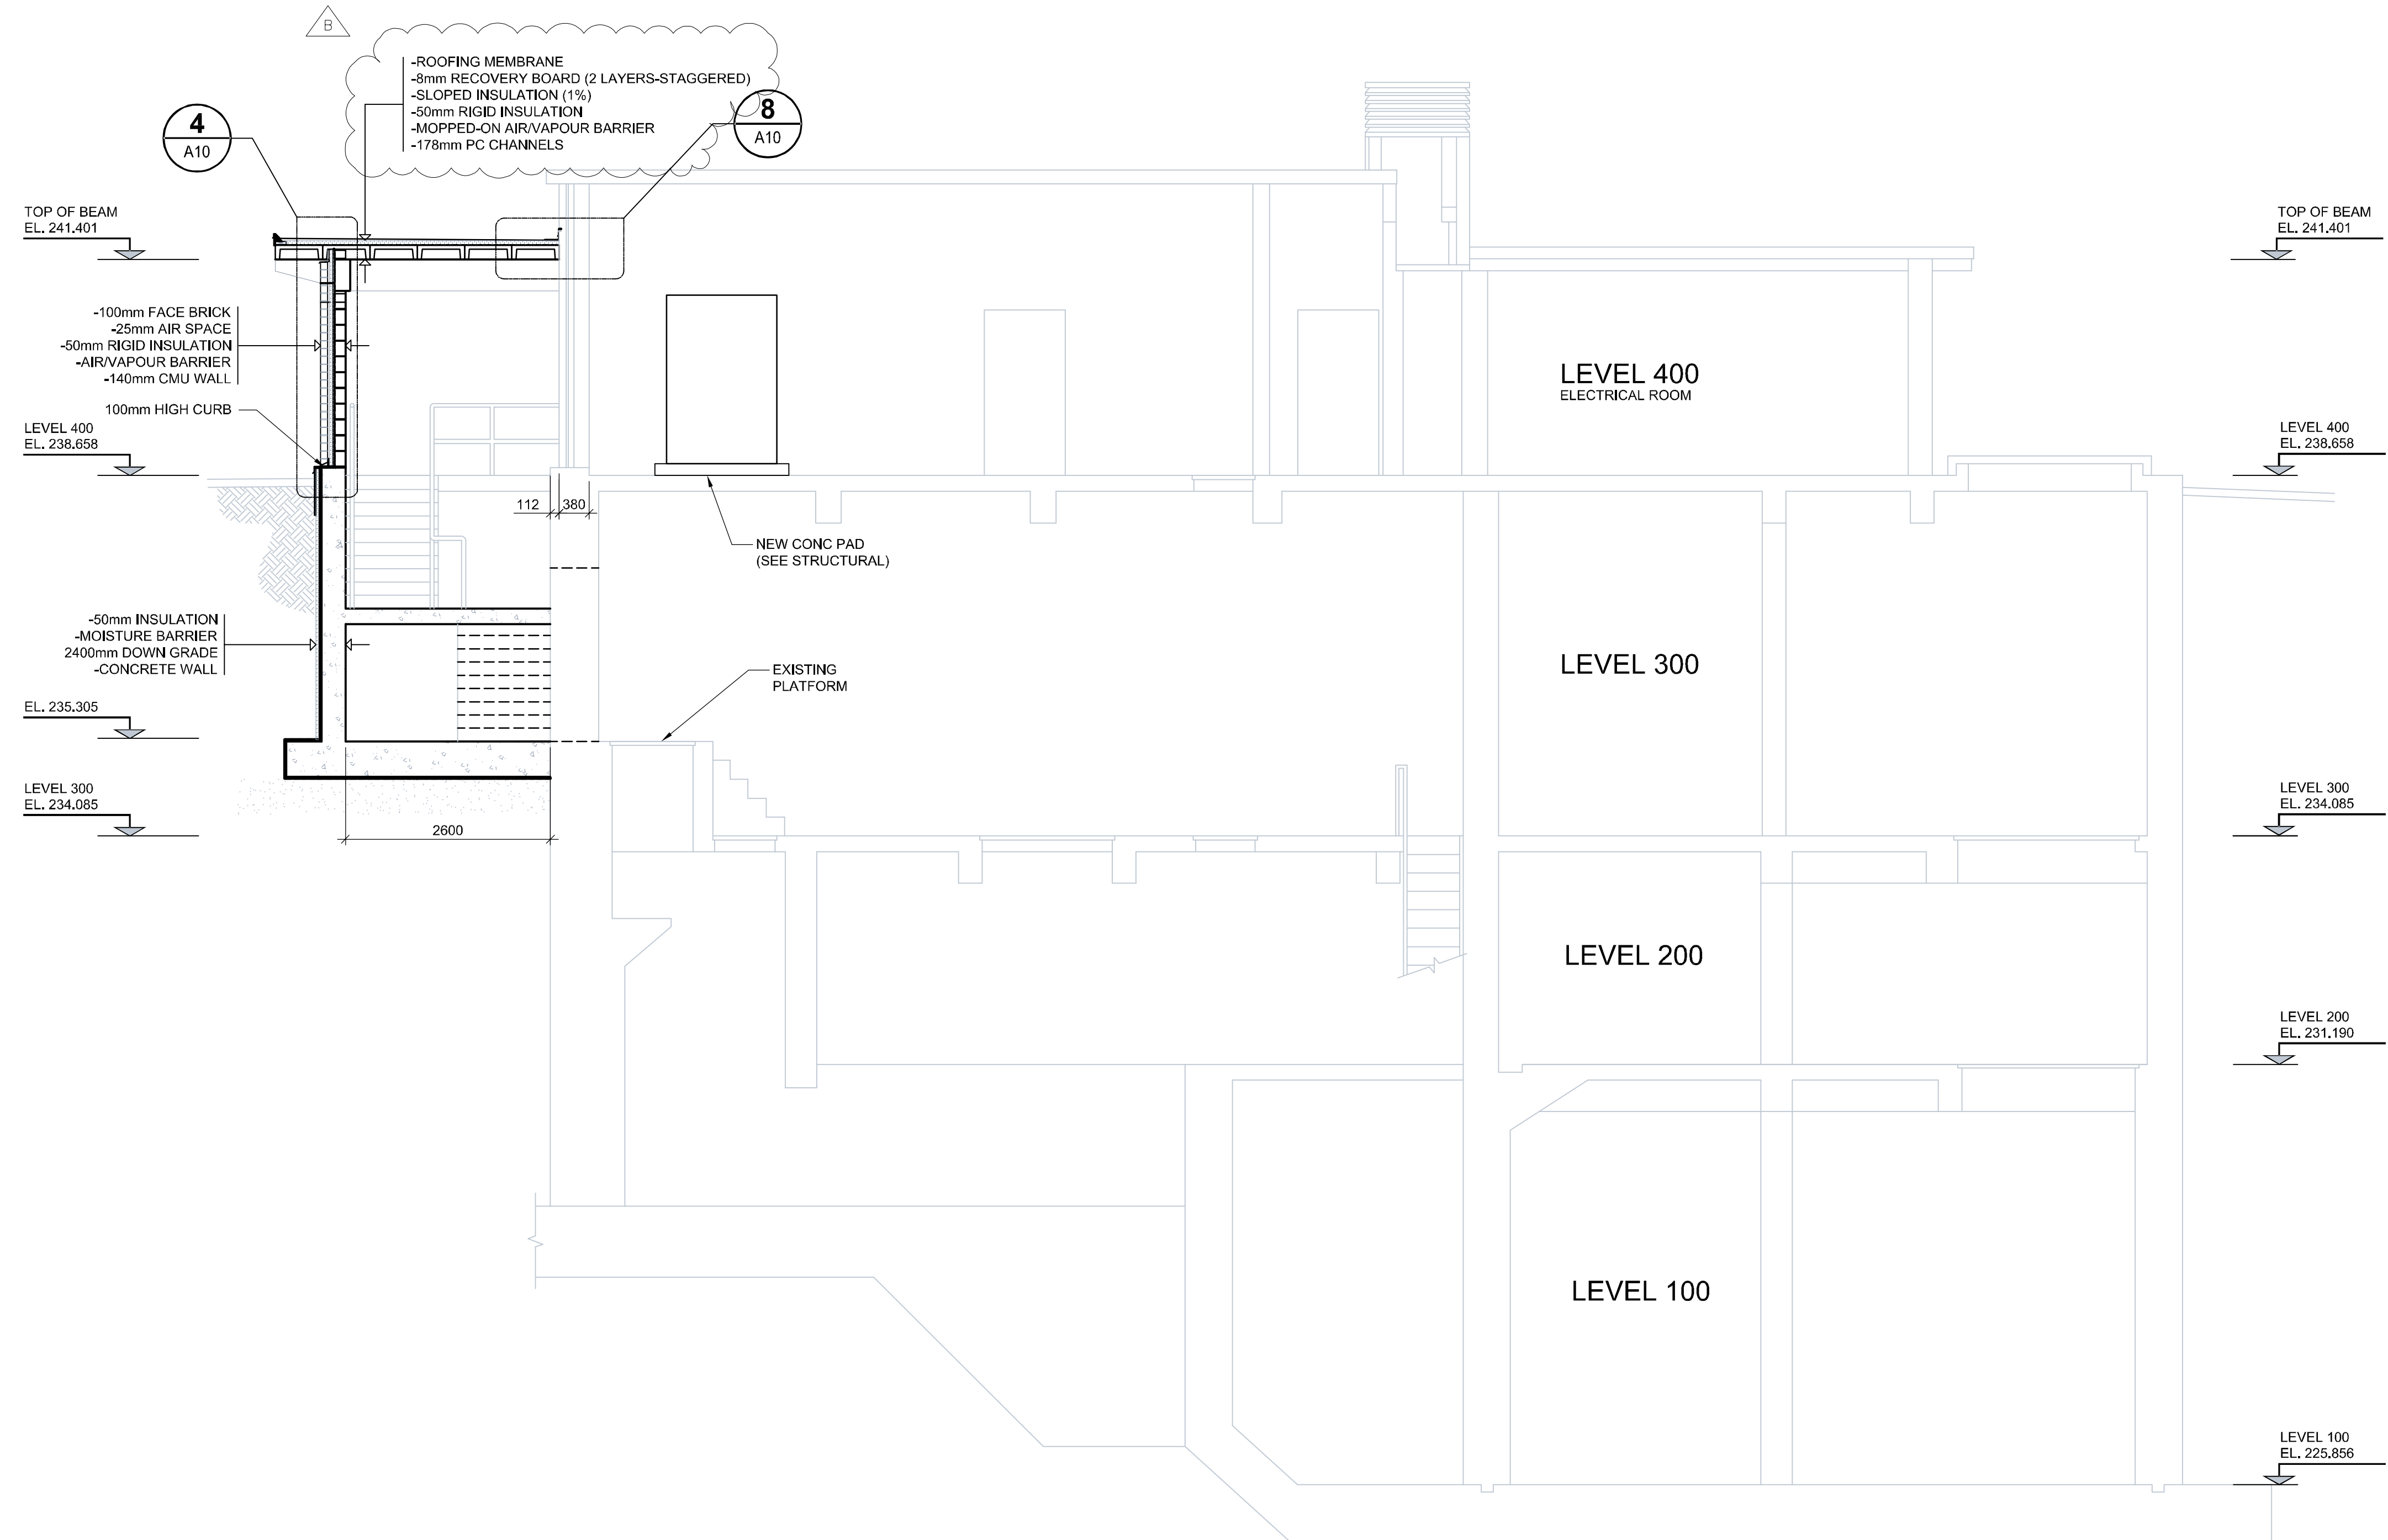

1 BUILDING SECTION
 A05 SCALE: 1:50

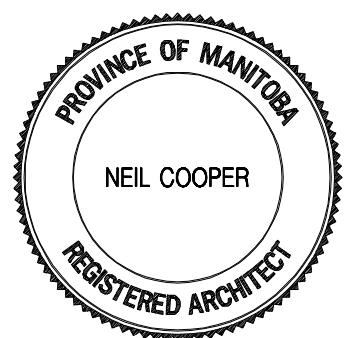

APEGN
 Certificate of Authorization
 UMA Engineering Ltd. (MB)
 No. 256 Date: 07/12/14

B.M. ELEV.	FIELD BOOK #:	Neil Cooper Architect Inc. 10-395 Berry Street, Winnipeg, Manitoba R3M 1N6 Phone (204) 885-3855 Fax (204) 831-7148	
POSTED TO LBIS		DESIGNED BY NC	CHECKED BY -
		DRAWN BY CGC/AL	APPROVED BY -
		HOR. SCALE AS NOTED	RELEASED FOR CONSTRUCTION
		VERTICAL AS NOTED	
B ISSUED FOR ADDENDUM 4	08/02/01	AL	
A ISSUED FOR BID	07/12/14	AL	DATE 07/06/14 DATE
NO. REVISIONS	DATE	BY	FILENAME: A0007-AR BLDG SEC2.dwg

ENGINEER'S SEAL
 REVISION - A
 ISSUED FOR BID
 WAS SEALED BY
 NEIL COOPER
 AND DATED
 DEC 14, 2007

THE CITY OF WINNIPEG
 WATER AND WASTE DEPARTMENT
Winnipeg
 PERIMETER ROAD PUMPING STATION UPGRADE
 Contract B - Building Upgrades
 Architectural - New Construction
 BUILDING SECTION
 CITY DRAWING NUMBER **1-0111L-A0007** SHEET **001** REV. **B** SIZE **D**