



UMA FILE NAME: F953-001-01\_01-E-2002\_RX.dwg  
 DATE: 2007.02.21  
 DESCRIPTION: Second Floor Demolition  
 PROJECT No: F953-001-01  
 ADDRESS: 989 Sargent St. Winnipeg, Manitoba  
 PLOT: 07/08/22 2:39:33 PM  
 FILE NAME: F953-001-01\_01-E-2002\_RX.dwg

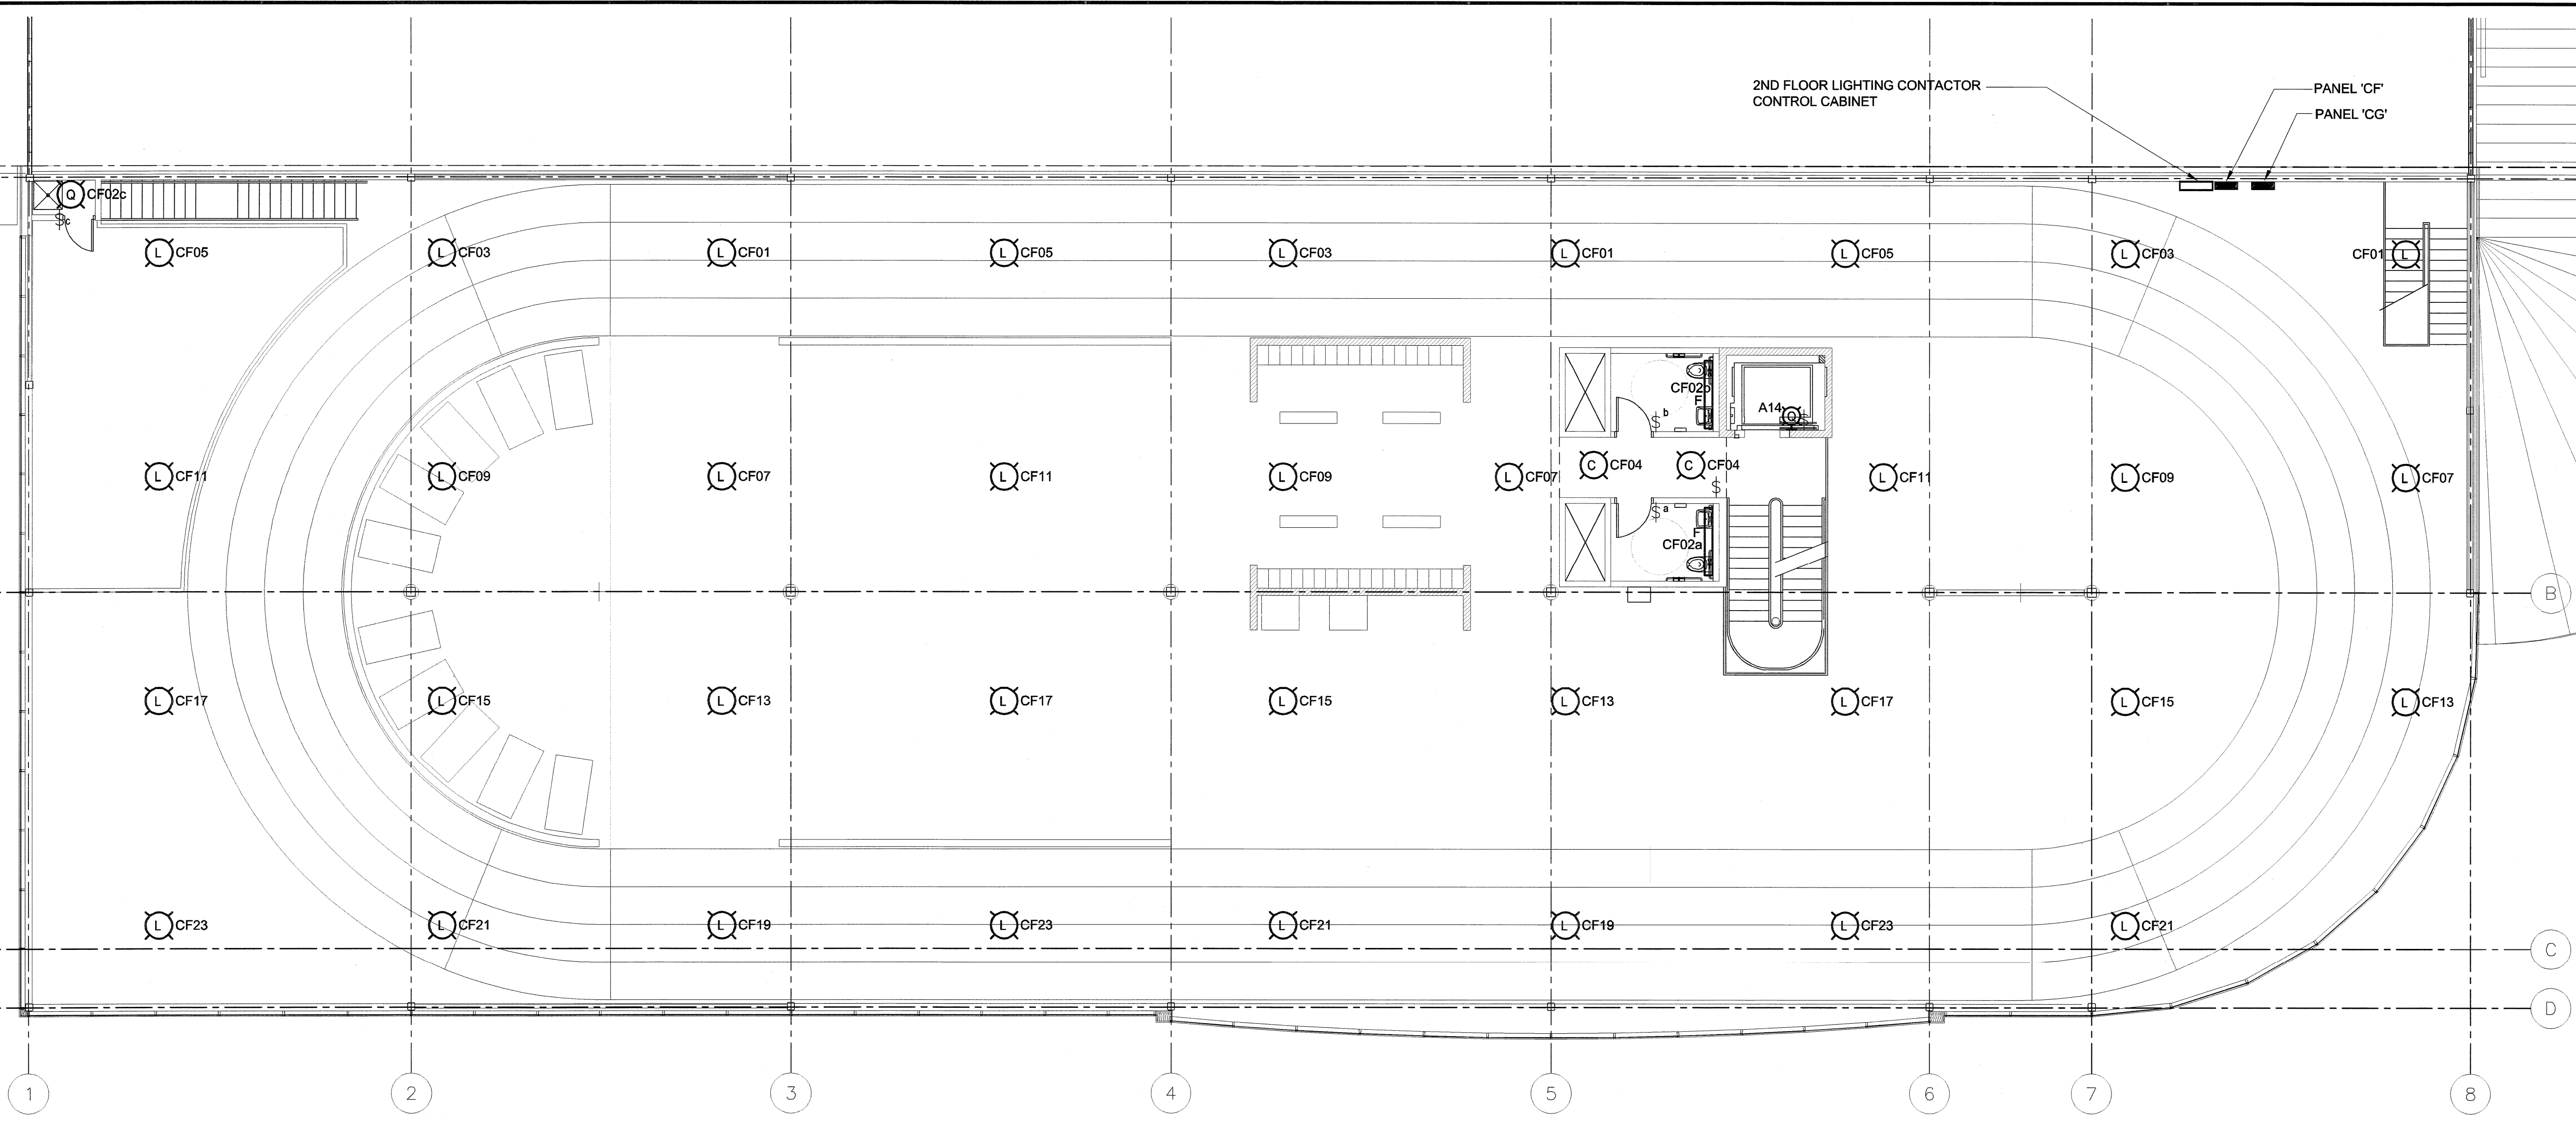

**PLAN**  
 TRACK PLAN  
 LIGHTING AND SYSTEMS  
 SCALE 1:100  
 1

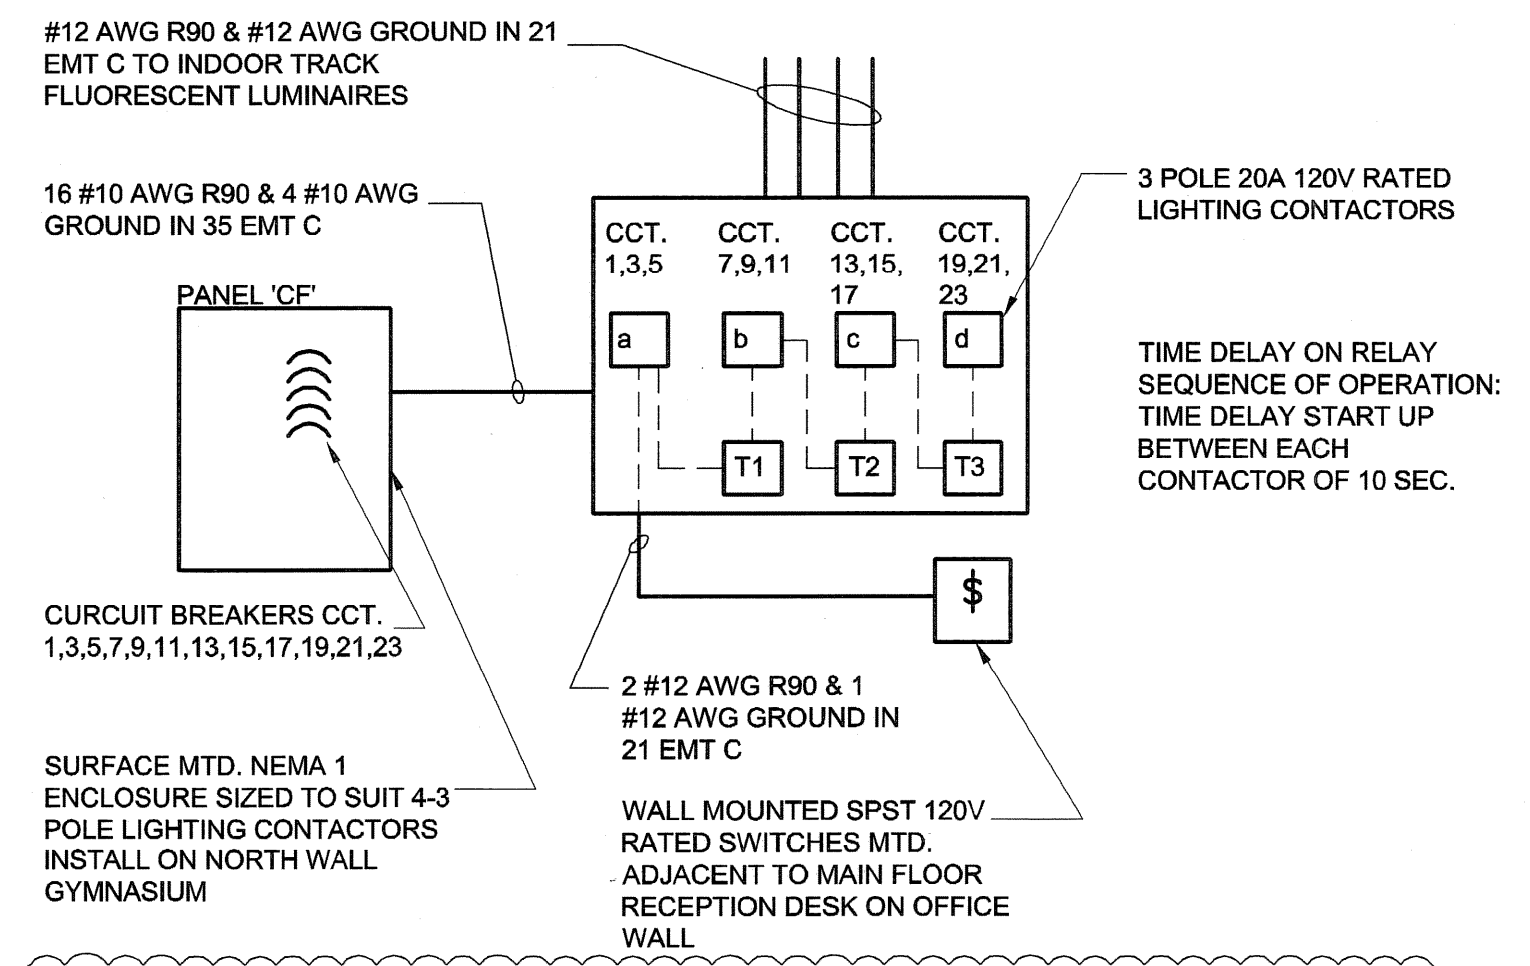

**TRACK AREA LIGHTING CONTROL BLOCK DIAGRAM**  
 SCALE: N.T.S.  
 1

UMA | AECOM  
 © 2007 UMA ENGINEERING LTD. ALL RIGHTS RESERVED.

**APEGM**  
 Certificate of Authorization  
 UMA Engineering Ltd. (MB)  
 No. 256 Date: Aug 21, 2007

DRN	CHK	DES	ENG	IDR

UMA | AECOM REVIEW

NO.	REVISION/DESCRIPTION	BY	DATE
1	ISSUED FOR ADDENDUM #2	QL	07/08/21
0	ISSUED FOR TENDER	QL	07/07/23

SEALS

PROVINCE OF MANITOBA  
 S. R. SMART  
 SMART  
 Member  
 20996  
 Aug 21, 2007  
 REGISTERED PROFESSIONAL ENGINEER

DRAWN BY	QL	CHECKED BY	APPROVED
DATE	2007.02.21	USER APPROVAL	

CITY OF WINNIPEG  
 PLANNING, PROPERTY & DEVELOPMENT DEPARTMENT  
 CIVIC ACCOMMODATIONS DIVISION  
 300 - 65 GARRY ST. R3C 4K4

PROJECT  
 Construction of Cindy Klassen Recreation Complex Facility Enhancement Project  
 999 Sargent St. Winnipeg, Manitoba

SHEET TITLE  
 Electrical  
 Second Floor - Track Plan  
 Lighting and Systems

SCALE	PROJECT NO.	SHEET NO.
1:100	2005-059	E2.2

DRAWING SHEET SIZE: A1 (841mm x 594mm) PLOT 1:1