




10 INCHES

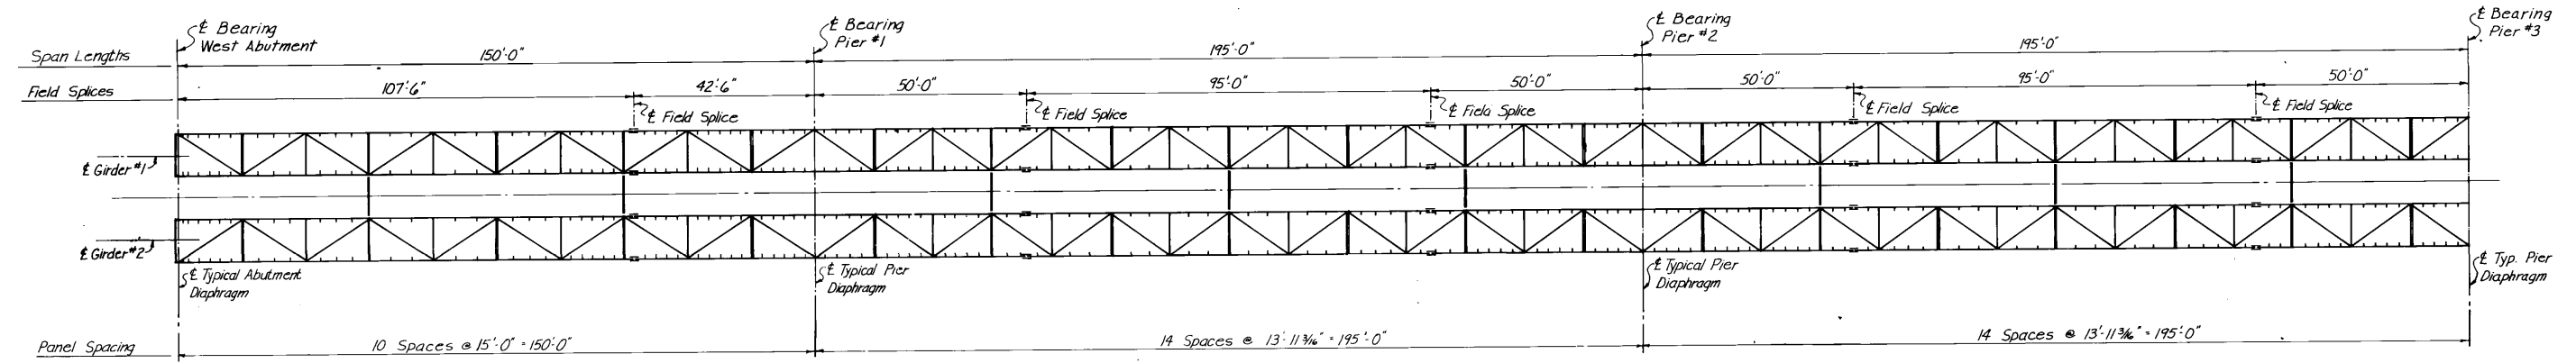


NORTH BRIDGE

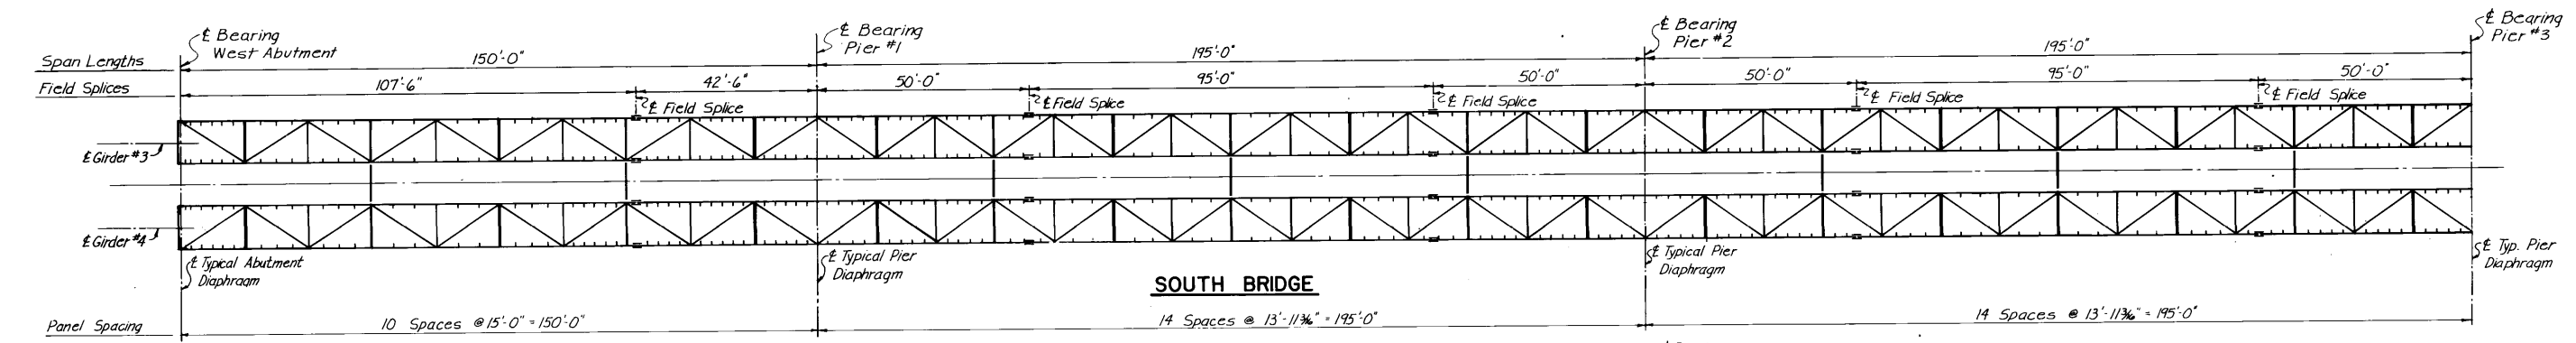

SOUTH BRIDGE

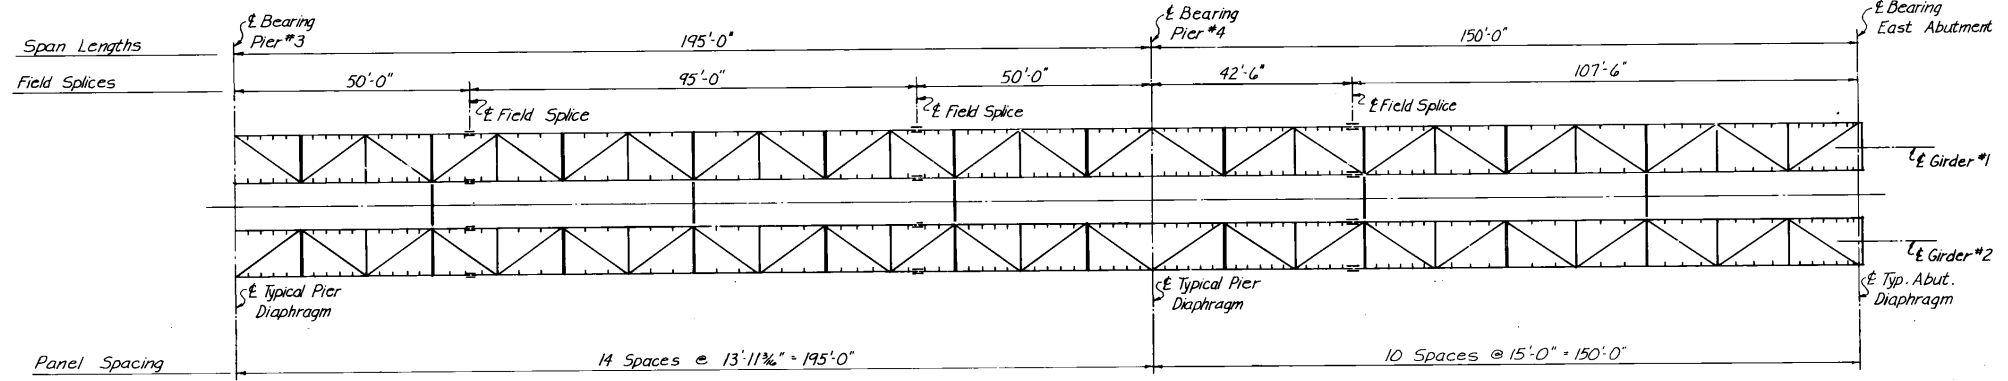

NORTH BRIDGE

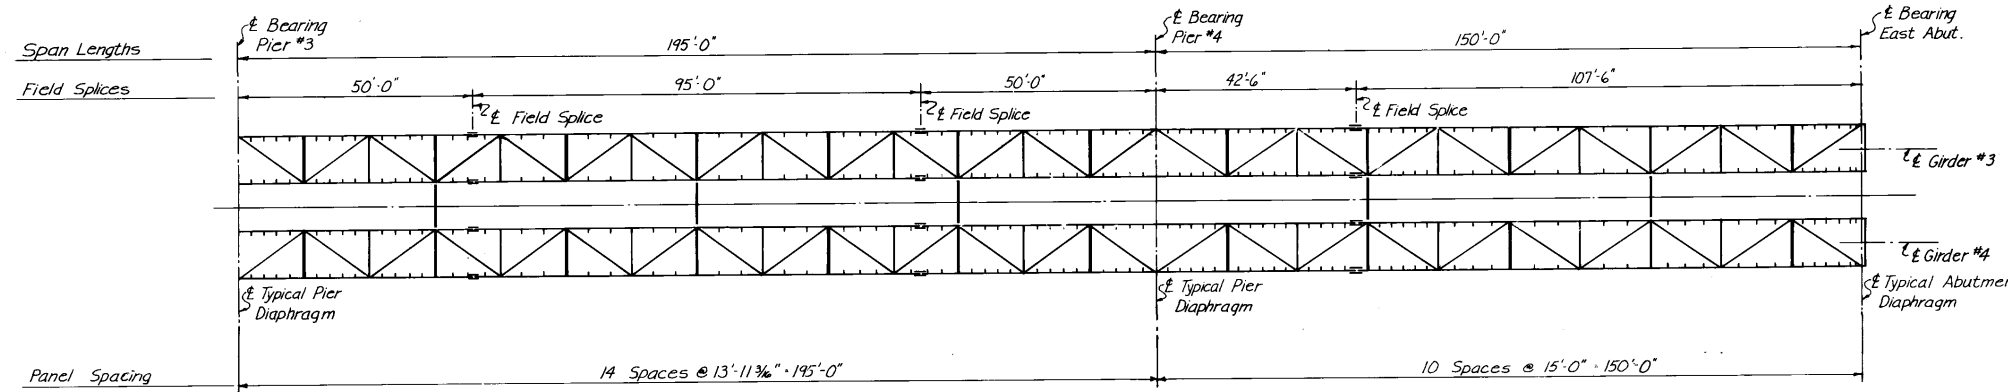


SOUTH BRIDGE

Notes:
1) The location of welds connecting stiffener and gusset plates to flanges shall be as shown on the "Girder Elevation".

AS - BUILT		
DATE	FB NO	PAGE
Nov. 14/77		

NO	REVISIONS	DATE
1	DESIGN REVISION	4-4-77

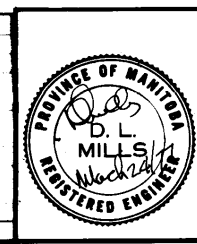

THE CITY OF WINNIPEG
WORKS & OPERATIONS DEPARTMENT
STREETS & TRANSPORTATION DIVISION

W.L. WARDROP & ASSOCIATES LTD.
ENGINEERING CONSULTANTS
WINNIPEG - THUNDER BAY - REGINA - BARRIE - EDMONTON

APPROVED BY: *D.L. Mills* DATE: 25 Nov 77
DRAWN BY: J.T.K. NOV. 76 DESIGN: S.T.K. NOV. 76
PRELIM. CHK: S.T.K. JAN. 77 CHECK: D.L.M. JAN. 77

ROUTE 165

FRAMING PLAN

APPROVED BY: *Samuel R. Campbell* DATE: 25/3/77
MANAGER OF STREETS AND TRAFFIC

SCALE:	1" = 20'-0"
DRAWING NO.	B-5092-221