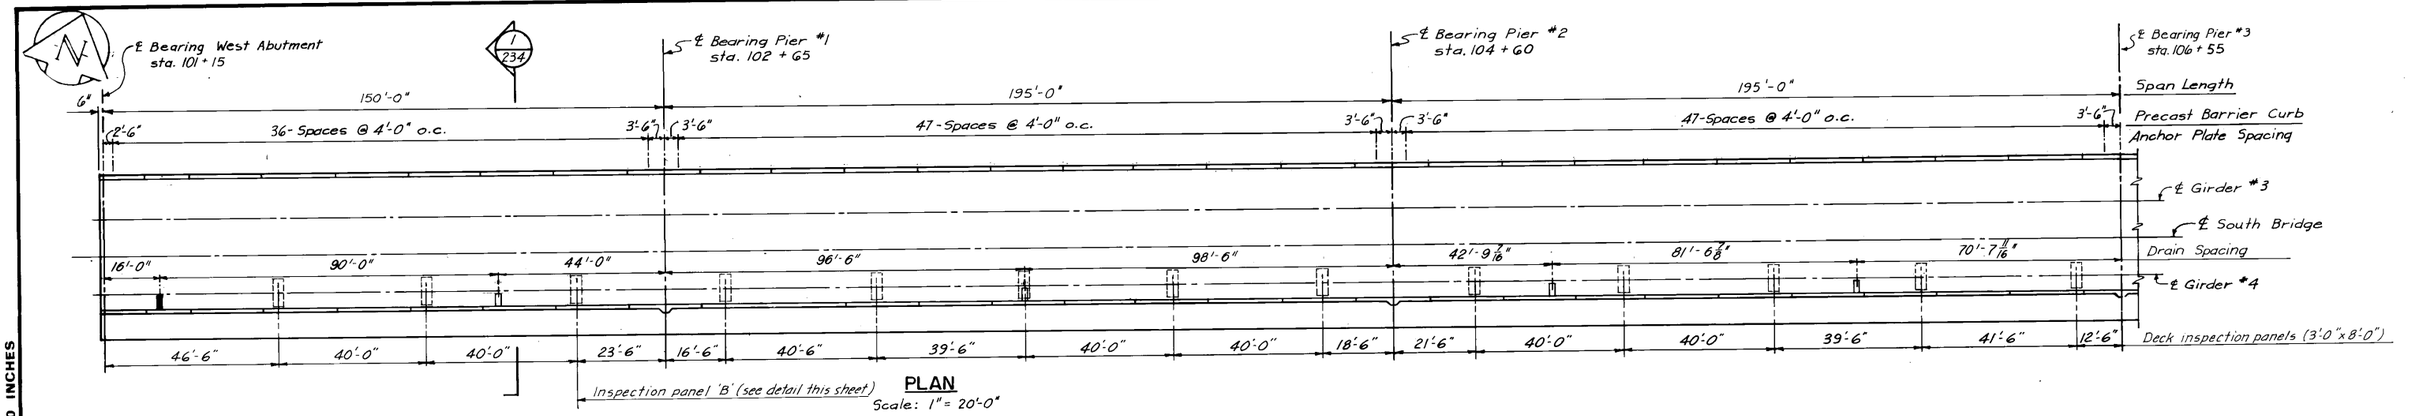

PLAN
Scale: 1" = 20'-0"

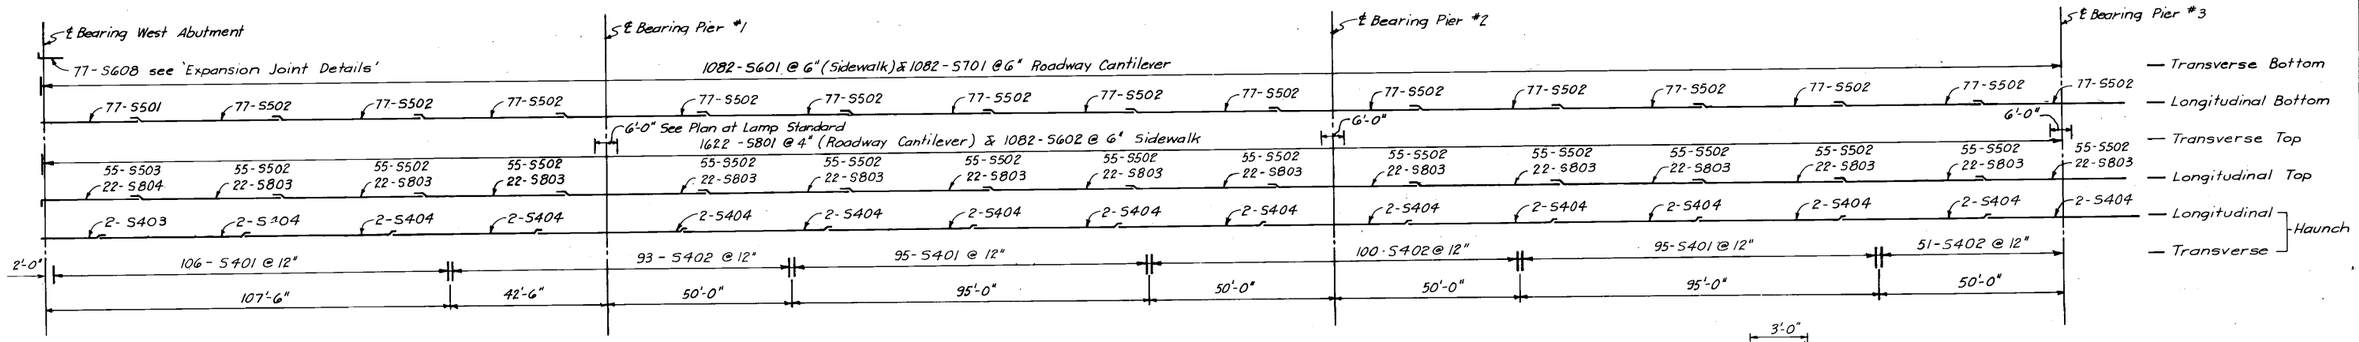

SLAB REINFORCEMENT SCHEMATIC

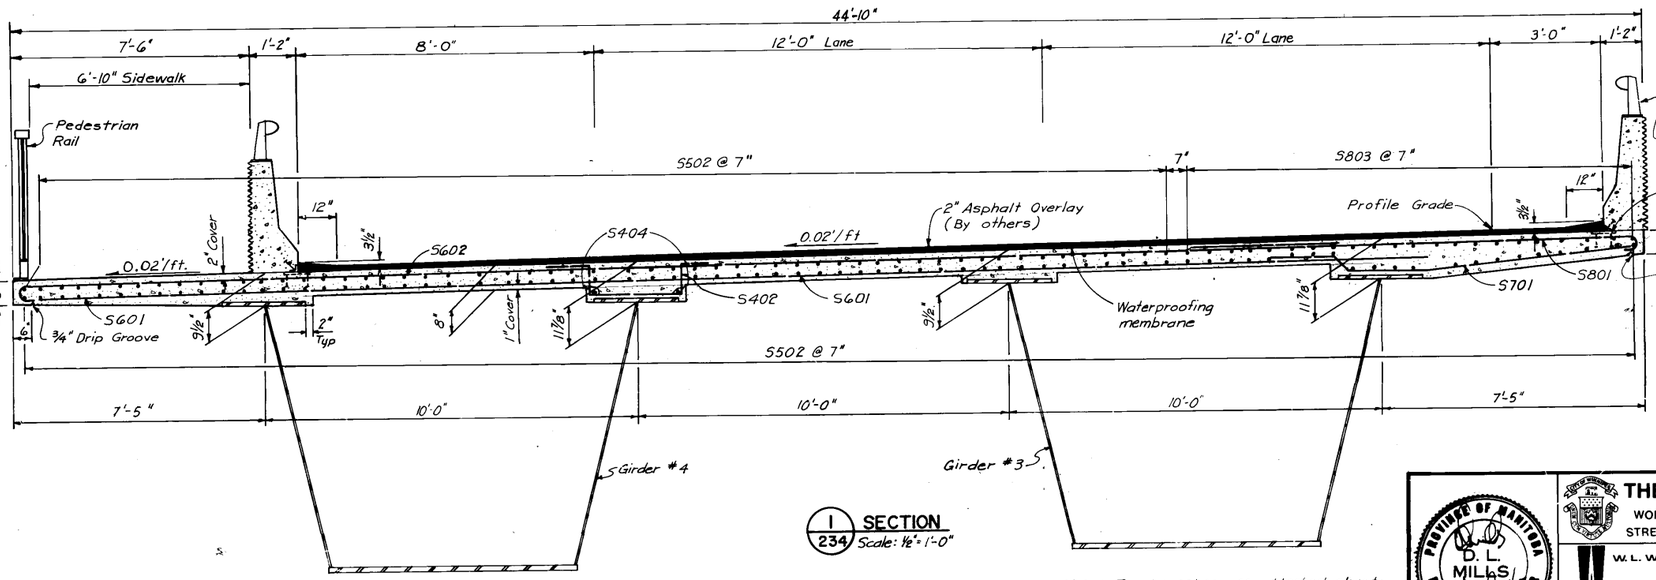

1/234 SECTION
Scale: ½" = 1'-0"

Note: For haunches see attached sheets.

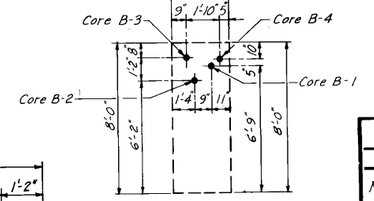

DECK INSPECTION PANEL 'B'

for spacing of longitudinal bars, see Section 1/234

AS - BUILT		
DATE	F.B. NO.	PAGE
Nov. 14/79		

Notes:
1. Concrete shall have compressive strength of 4500 psi at 28 days.
2. Reinforcing shall be grade 40 for No. 4 bars and grade 60 for No. 5 bars and larger.
3. Splicing of bars shall conform to ACI 318-71 with a minimum developement length of 30 bar diameters.
4. For pouring sequence see 'Slab Plan North Bridge'.

NO	REVISIONS	DATE	BY
0	ISSUED FOR TENDER	4.4.77	

PROVINCE OF MANITOBA — D. L. MILLS — REGISTERED ENGINEER

THE CITY OF WINNIPEG
WORKS & OPERATIONS DEPARTMENT
STREETS & TRANSPORTATION DIVISION

W. L. WARDROP & ASSOCIATES LTD.
ENGINEERING CONSULTANTS
WINNIPEG - THUNDER BAY - REGINA - BARRIE - EDMONTON

APPROVED BY: A.D.W. — DATE 25 Mar 77

		DATE			DATE
DRAWN BY	ST	JAN 77	DESIGN	STK	DEC 76
PRELIM. CHK.	STK	JAN 77	CHECK	D.L.M.	JAN 77

ROUTE 165

SLAB PLAN
SOUTH BRIDGE

SCALE: AS SHOWN

DRAWING NO. B-5092-234

APPROVED BY: Darrell R. Campbell — MANAGER OF STREETS AND TRAFFIC — 25/3/22 DATE

W.L.W. NO. 74012-21