



24 x 36 / 609-914
 X:\projects\2503-03-1100-01\Drawings\Construction\Contract\Drawings\Specification For TENDERS Drgs\CS_Channel_Contract\05_Kildare_Dr-CCS-48aS-004c-01-02.dwg - Tab: 4c - Apr 05 - 4:13pm - User:Name: ECorrea

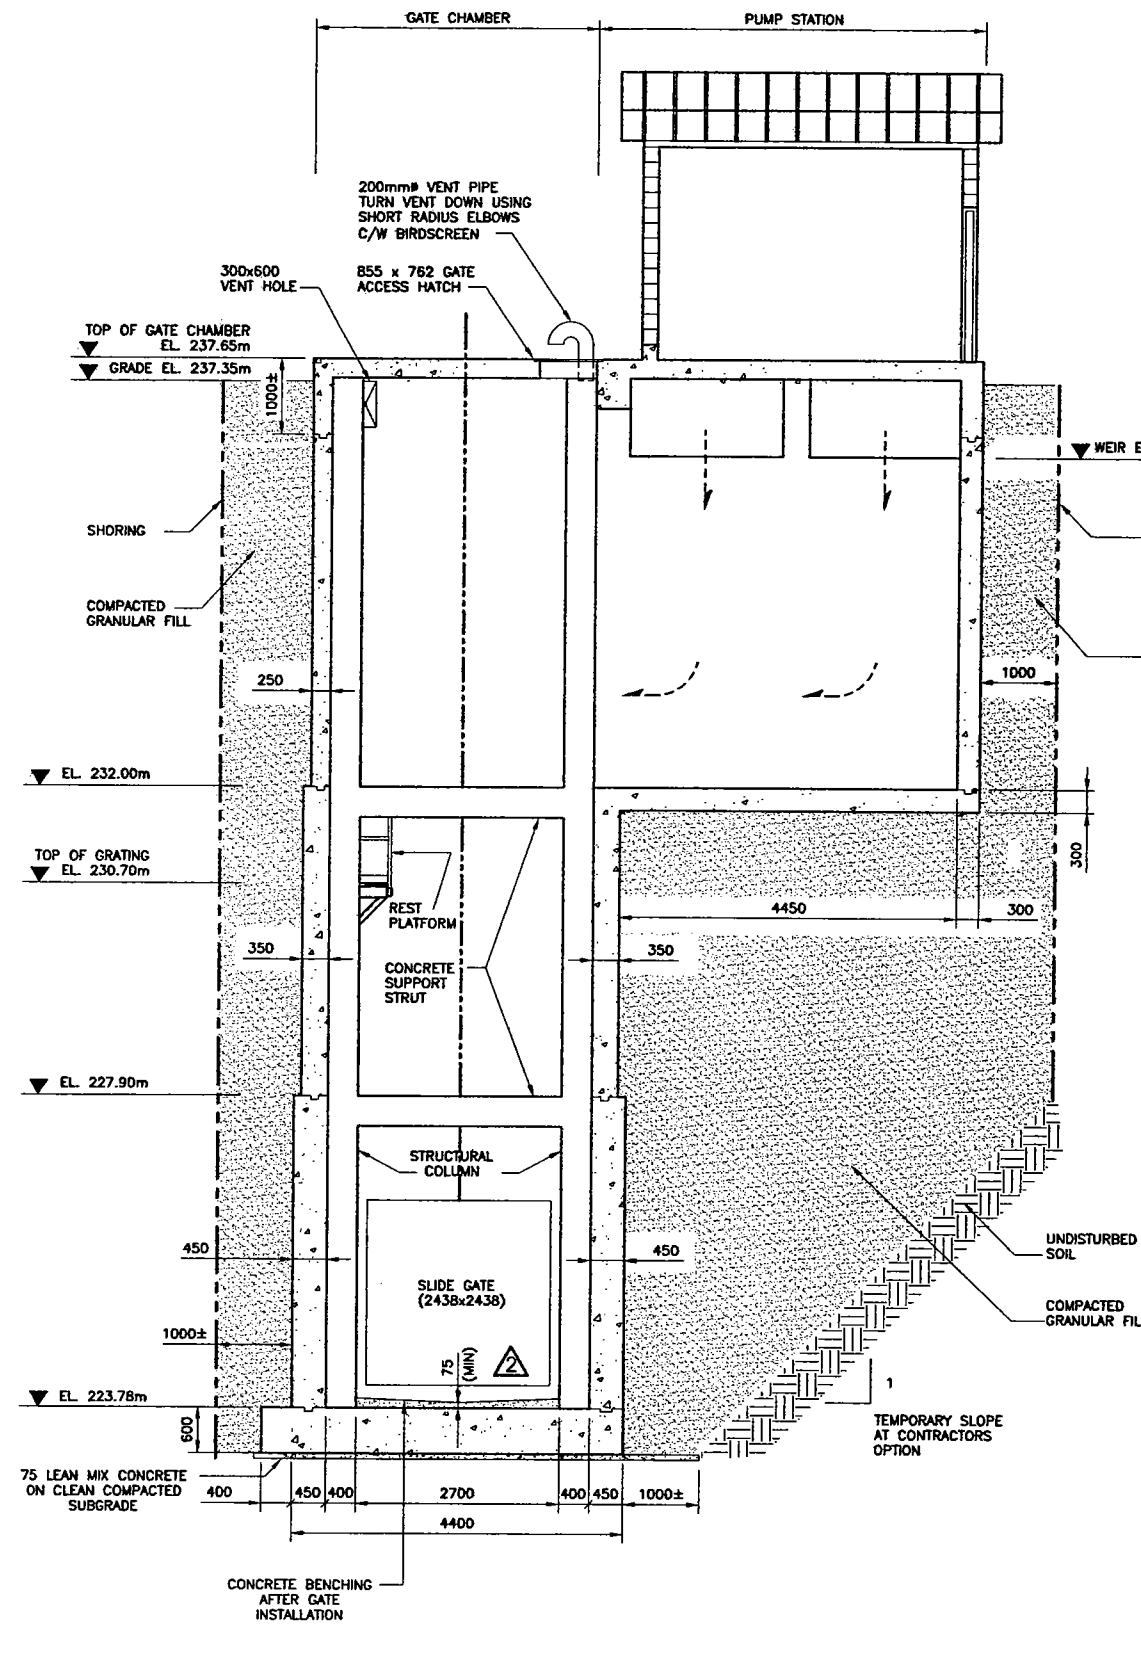

C SECTION
1c&2c
SCALE: 1:50

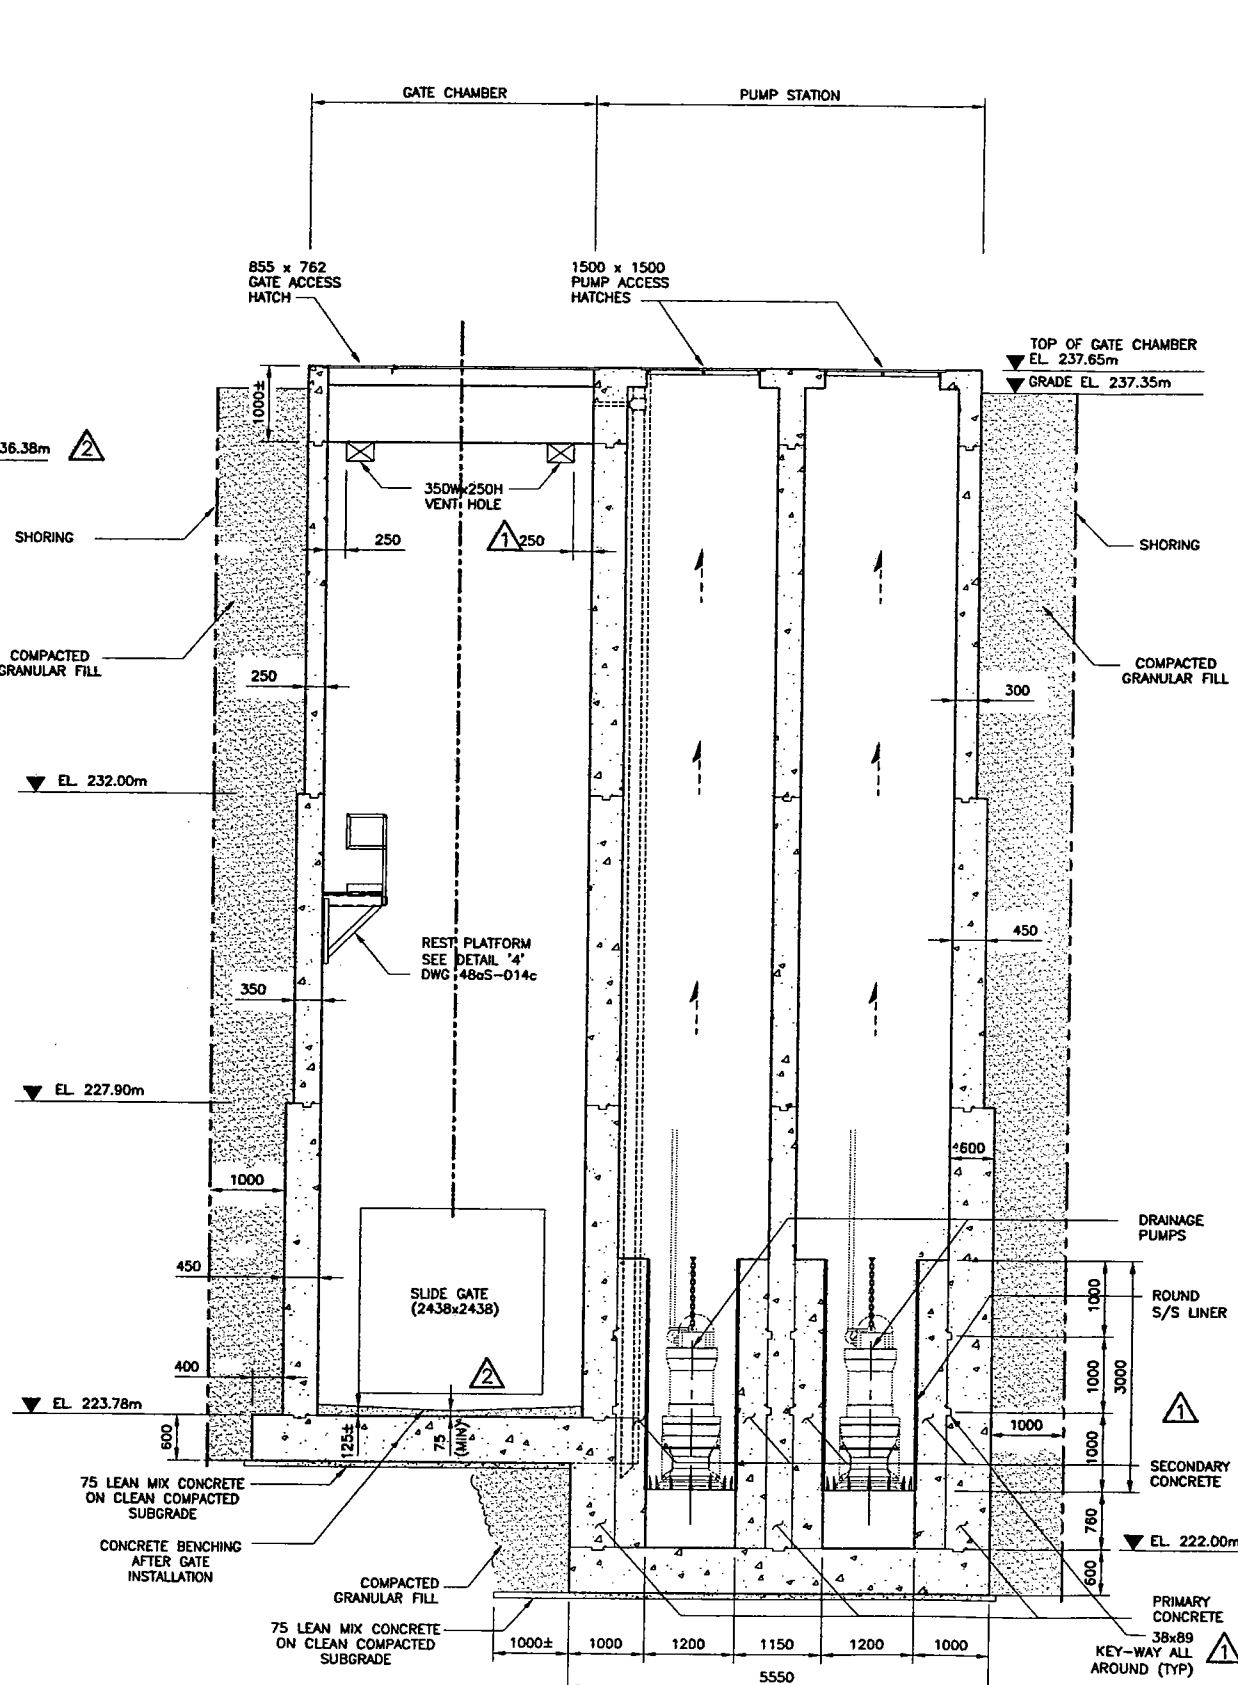

D SECTION
1c&2c
SCALE: 1:50

1. REFER TO DRAWING 48aS-001c FOR GENERAL NOTES.

0 1000 2000 3000 4000 5000

SCALE: 1:50mm (24"x36")
1:100mm (11"x17")

02	REVISED BENCHING	TF	CMS	JBS
01	REVISED BEAM AND CONST. JOINTS	TF	CMS	JBS
00	ISSUED FOR TENDER AND CONSTRUCTION	TF	CMS	JBS
NO.	DATE	REVISIONS	BY	CHKD. APP.

KGS GROUP

Subconsultant DWG NO.:

APEGM
Certificate of Authorization
KGS Group
No. 245 Expires April 30, 2007

THE ORIGINAL ISSUE REV 0 WAS STAMPED, DATED AND SIGNED BY C.M. SIEPMAN ON 04/07/06 D/M/Y

DESIGNED BY: TF	DRAWN BY: EC	SCALE: AS NOTED
CHECKED BY: CMS	APPROVED BY: J B SMITH	DATE: MAY 2006

KGS GROUP SUBMITTED BY: RICK CARSON

OWNER: **MANITOBA FLOODWAY AUTHORITY**

PROJECT: **RED RIVER FLOODWAY EXPANSION**

PHASE: **MAIN CHANNEL CONTRACT No. C5**

TITLE: **KILDARE LAND DRAINAGE FLOOD PUMPING STATION STRUCTURAL WORKS**

CONCRETE SECTIONS C AND D

RELEASED FOR CONSTRUCTION:

DOUG McNEIL
VICE PRESIDENT OF ENGINEERING AND CONSTRUCTION

OWNER DWG NO.: CC5-48aS-004c	SHT. 01	REV. 02
------------------------------	---------	---------

