

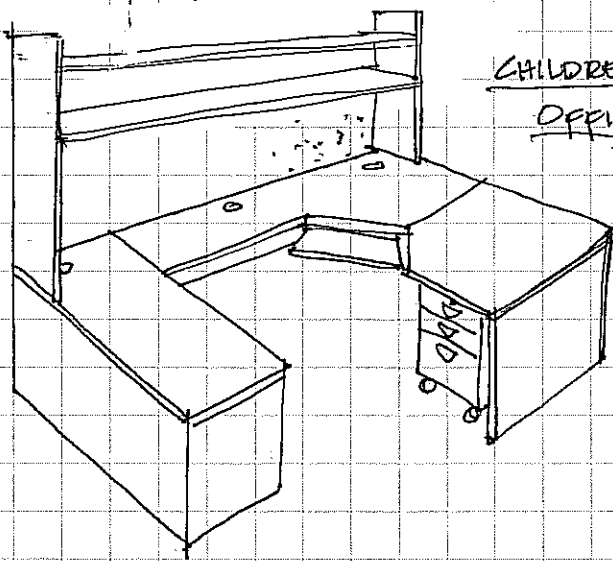


N.I.C

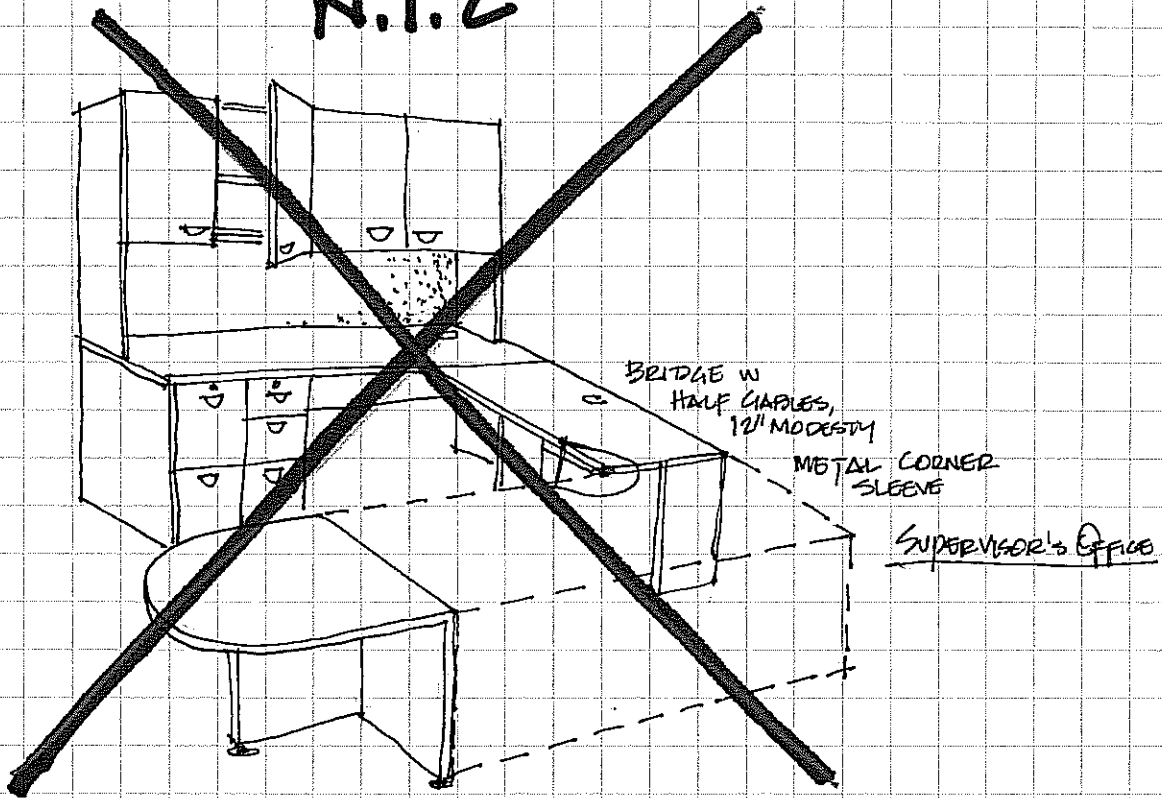

CHILDREN'S
OFFICE

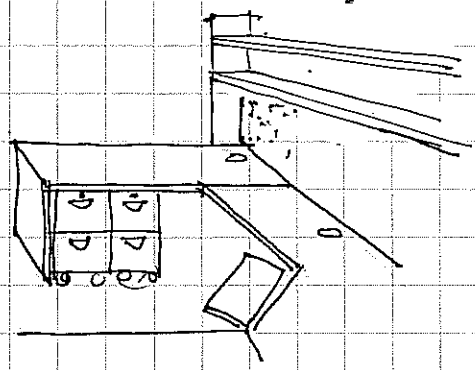

HENDERSON LIBRARY
1-1050 HENDERSON HWY

CHILDREN'S OFFICE
(ONLY)

DRAWING * 12 R1
SEDH AUG '07