
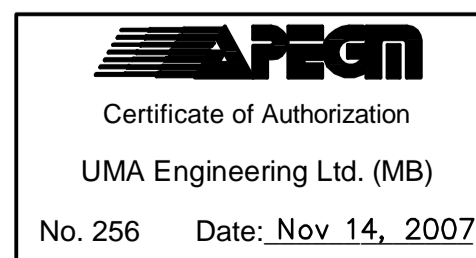
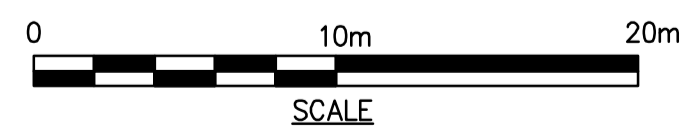


CHAINAGE ALONG
C OF 2134# OVERFLOW PIPE

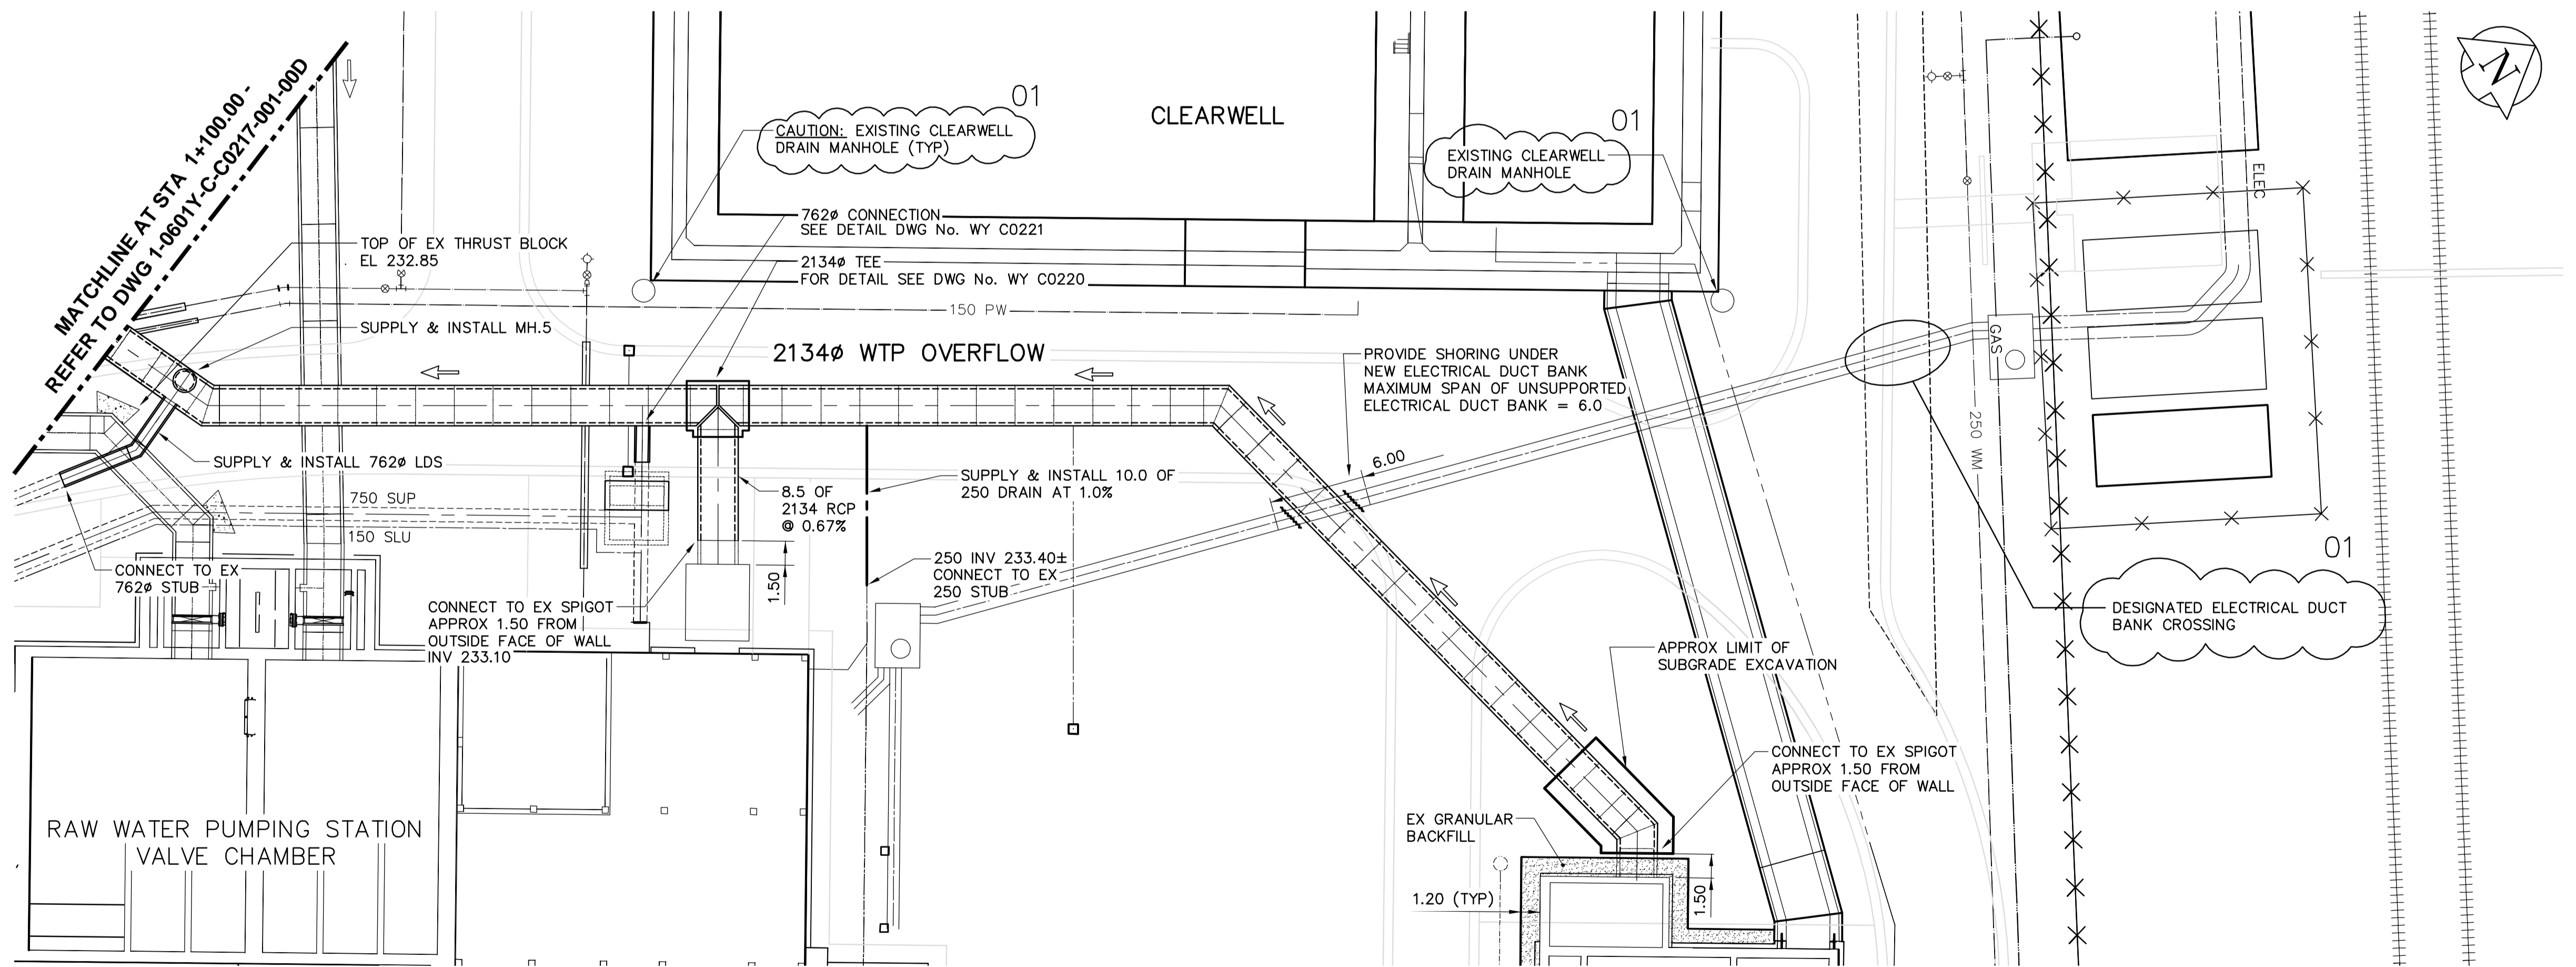

B.M. ELEV.		UMA AECOM	
		DESIGNED BY: EDT	CHECKED BY: MGM
		DRAWN BY: Wjd	APPROVED BY: CCM
01	681-2007 ADDENDUM 2	DATE: 07/11/12	BY: Wjd
00	681-2007 ISSUED FOR TENDER	DATE: 07/09/27	BY: Wjd
NO. REVISIONS		DATE	BY
		DATE: 2007/09/27	DATE: October 1, 2007

ENGINEER'S SEAL	
ORIGINAL SIGNED BY:	E. D. J. TOUPIN MEMBER 23484
DATE:	2007/10/01
CONSULTANT DRAWING NO.:	WY C0218

THE CITY OF WINNIPEG
WATER AND WASTE DEPARTMENT
ENGINEERING DIVISION

WINNIPEG WATER TREATMENT PROGRAM
CONSTRUCTION OF WATER TREATMENT PLANT OVERFLOW

CIVIL
W.T.P. OVERFLOW PIPING - PLAN & PROFILE
MATCH LINE STA 1+100.00 TO WATER TREATMENT PLANT

CITY FILE NUMBER: 1-0601Y-C-C0218-001-01D
SHEET 1 OF 1
CITY DRAWING NUMBER: 1-0601Y-C-C0218-001-01D