


TO REPLACE 3/L3

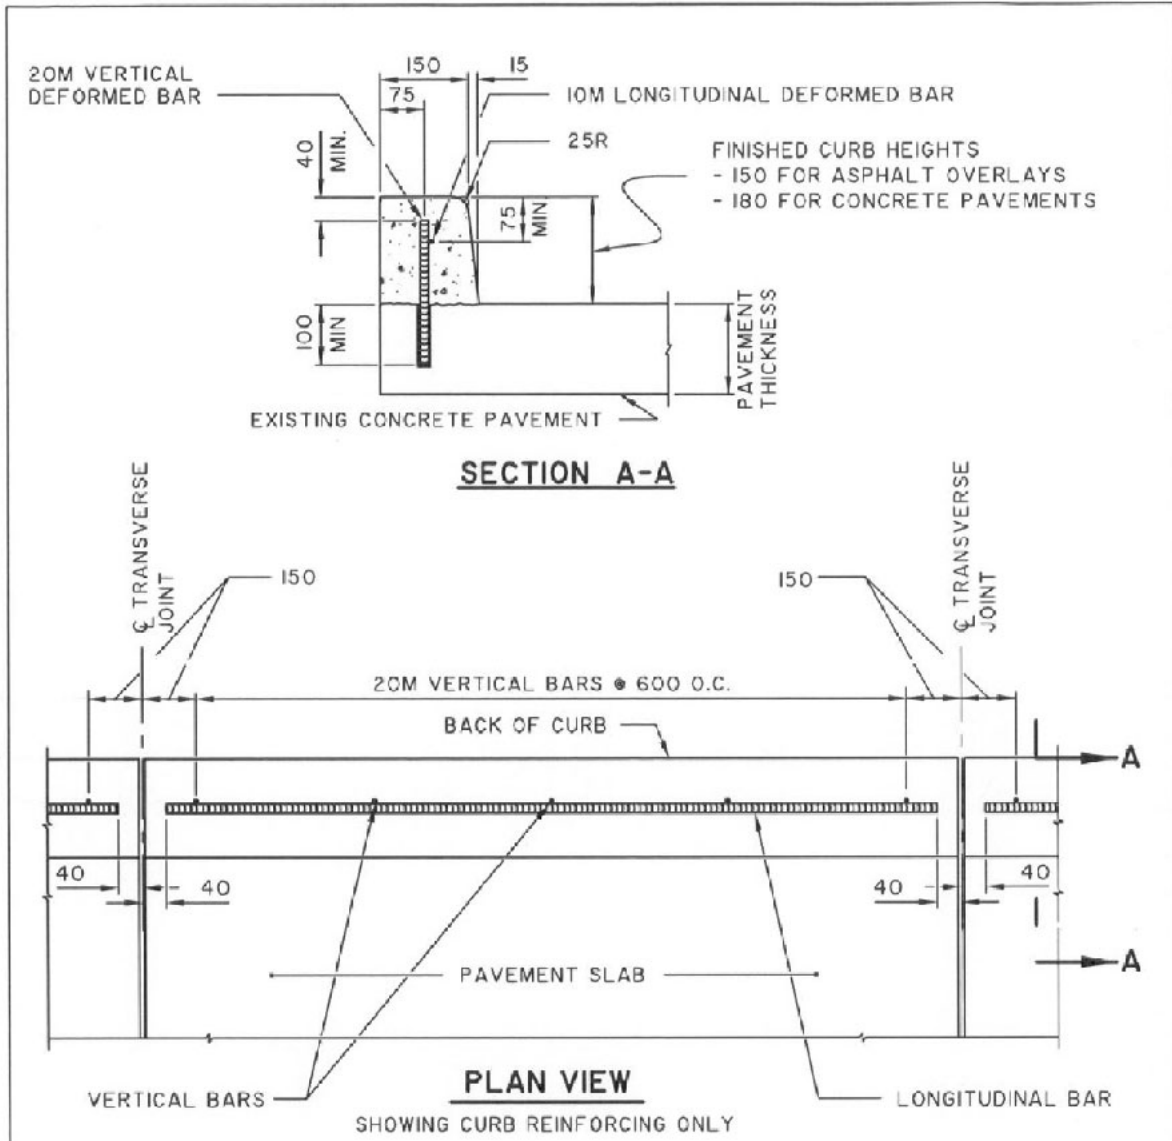

NOTE: 1. TRANSVERSE SAW CUT EVERY 6.0 METRES OR AT PAVEMENT JOINTS.

DIMENSIONS ARE IN MILLIMETRES

| | | | |
|--|---|-----------------------------|------------------------------|
| THE CITY OF WINNIPEG PUBLIC WORKS DEPARTMENT | Revisions | | |
| | Reference Spec. No. CW 3230, CW 3240, CW3310 | 1. JAN 03: GENERAL REVISION | lwb |
| BARRIER CURB (DOWELLED) | Designed By: Z. V. K. | Drawn By: A. R. | Scale : N.T.S. |
| | Checked By: D.R.K. | Date: 03-01-30 | Drawing No. SD-205 |
| | Approved: SURFACE WORKS COMMITTEE | | |
| | | | |

A. SECTION LETTER OR DETAIL NUMBER,
B. DRAWING WHERE SECTION OR DETAIL
IS DRAWN.
OR
DRAWING WHERE SECTION OR DETAIL
IS INDICATED,
--- SECTION OR DETAIL SHOWN ON SAME
DRAWING.



| | |
|---|---------------------|
| CLIENT City of Winnipeg PP&D | SCALE NTS |
| PROJECT TITLE Bronx Park Community Centre Home of Good Neighbours Senior Centre | DATE 19-Jan-2008 |
| DRAWING TITLE COW SD 205 to Replace 3/L3 | SHEET NO. LR-1.0 |
| FILE NO. 2006-065 | |



CAD file - S:\MI office\cslg - 11111-2b
 plot size - Letter
 plot scale - 1:1
 2006-065