


EL. 100.000  
 T.O. FIN. FLOOR (MAIN)  
 EL. 99.850  
 T.O. PIT WALLS

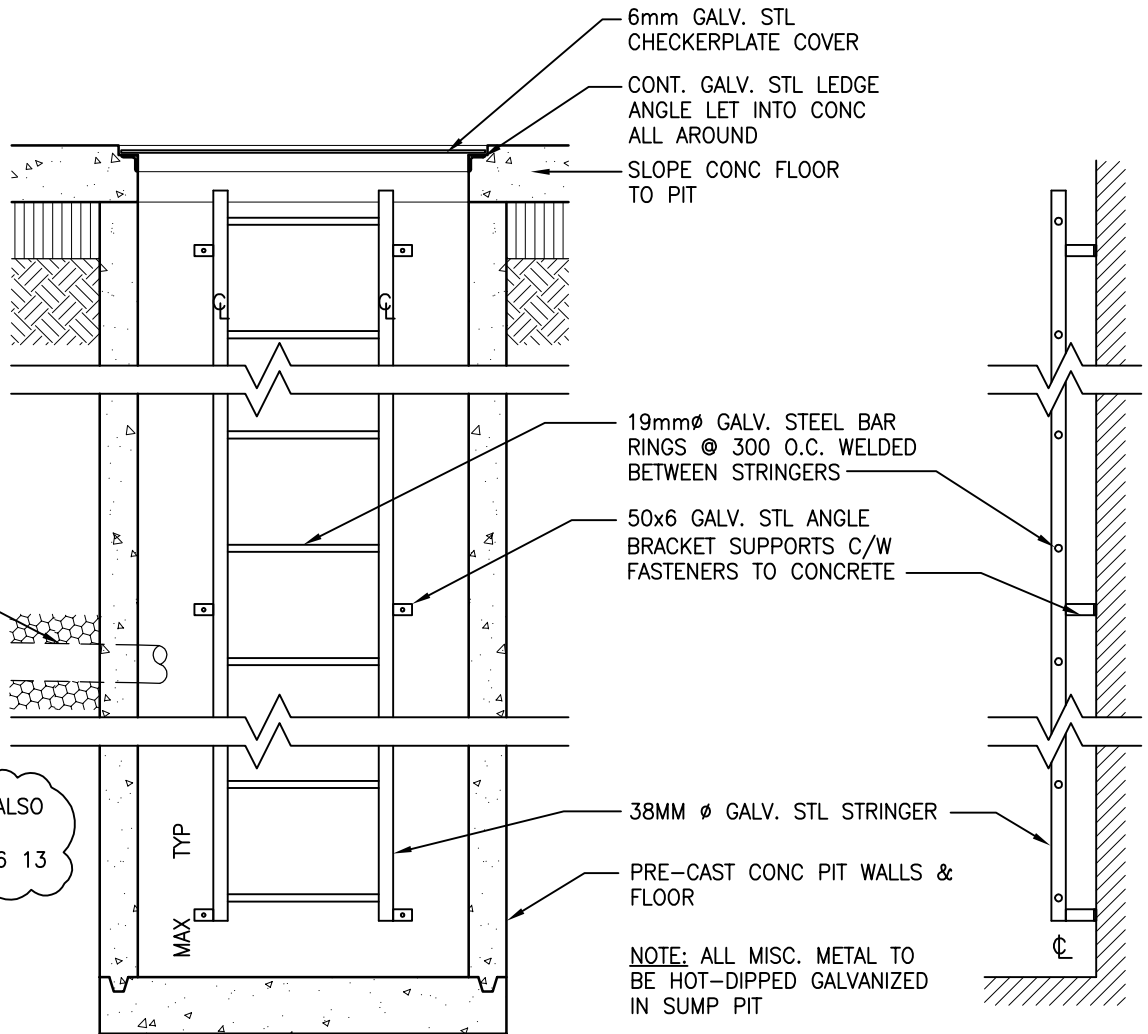

WEeping TILE

EL. ±98.900  
 U/S WEeping TILE  
 LOW POINT

REVISED ELEVATIONS - SEE ALSO  
 ADDENDUM #4 REVISION TO  
 SPECIFICATION SECTION 33 46 13

EL. 97.490  
 T.O. CONC PIT FLOOR

**14** SUMP PIT LADDER DETAIL  
 A-6.1 SCALE: 1:10 REVISED DRAWING

project: BRONX PARK CC, HOME OF GNSC  
 WINNIPEG, MB  
 sheet title: REVISED SUMP PIT ELEVATIONS  
 REFERENCE ADDENDUM #4, A-6.1

scale: AS SHOWN  
 drawn by: GD  
 checked by: DH  
 date: 15-FEB-2008

project no. #10 2006080  
 sheet no. RA-15

310 - 115 bannatyne ave.  
 winnipeg MB canada R3B 0R3  
 204 942.0981 f 204 947.9626  
 10@numberTEN.com  
**numberTEN**  
 architectural group  
 112 - 826 north park dr.  
 victoria BC canada V8W 3B4  
 250 360.2106 f 250 360.2166  
 numberTEN@telus.net

