



23 **WC 145**
 A7.1 SCALE: 1:50 (TYPICAL WC 146, REVERSED WITHOUT ACCESSORY FF)
 REVISED DRAWING

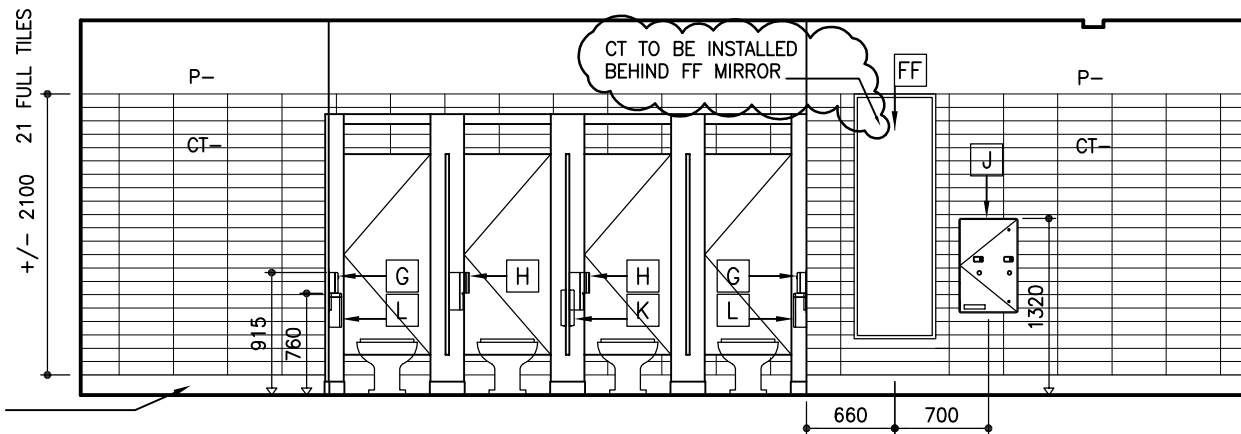

27 **WC 146**
 A7.1 SCALE: 1:50
 REVISED DRAWING

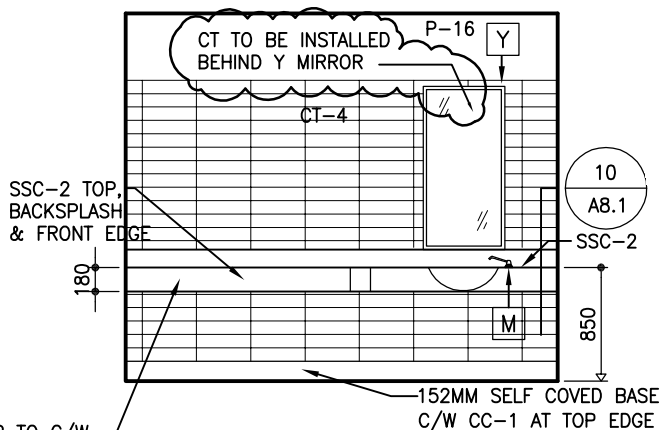

CHANGE TABLE TOP TO TO SUPPORT 500 LBS. TOP TO C/W REQUIRED STEEL STRUCTURE BRACED TO WALL. PROVIDE BLOCKING IN WALL CAVITY TO SUIT. STEEL STRUCTURE TO BE BELOW TOP ONLY, TO PROVIDE CLEAR BARRIER FREE ACCESS BELOW.

28 **WC 147**
 A7.1 SCALE: 1:50
 REVISED DRAWING

project BRONX PARK C.C. HOME OF GNSC WINNIPEG, MB.
 REFERENCE DWG. 23,27, 28/A-7.1
 ELEVATION - WC 145, WC 146, WC 147
 sheet title

scale: 1:50
 drawn by: MC
 checked by: DH
 date: 20-FEB.-2008

project no. #10 2006080
 ADDENDUM #
 RA-18
 sheet no.

numberTEN architectural group
 winnipeg MB victoria BC
 204 942.0981 250 360.2106
 architecture ■ interior design ■ graphic design