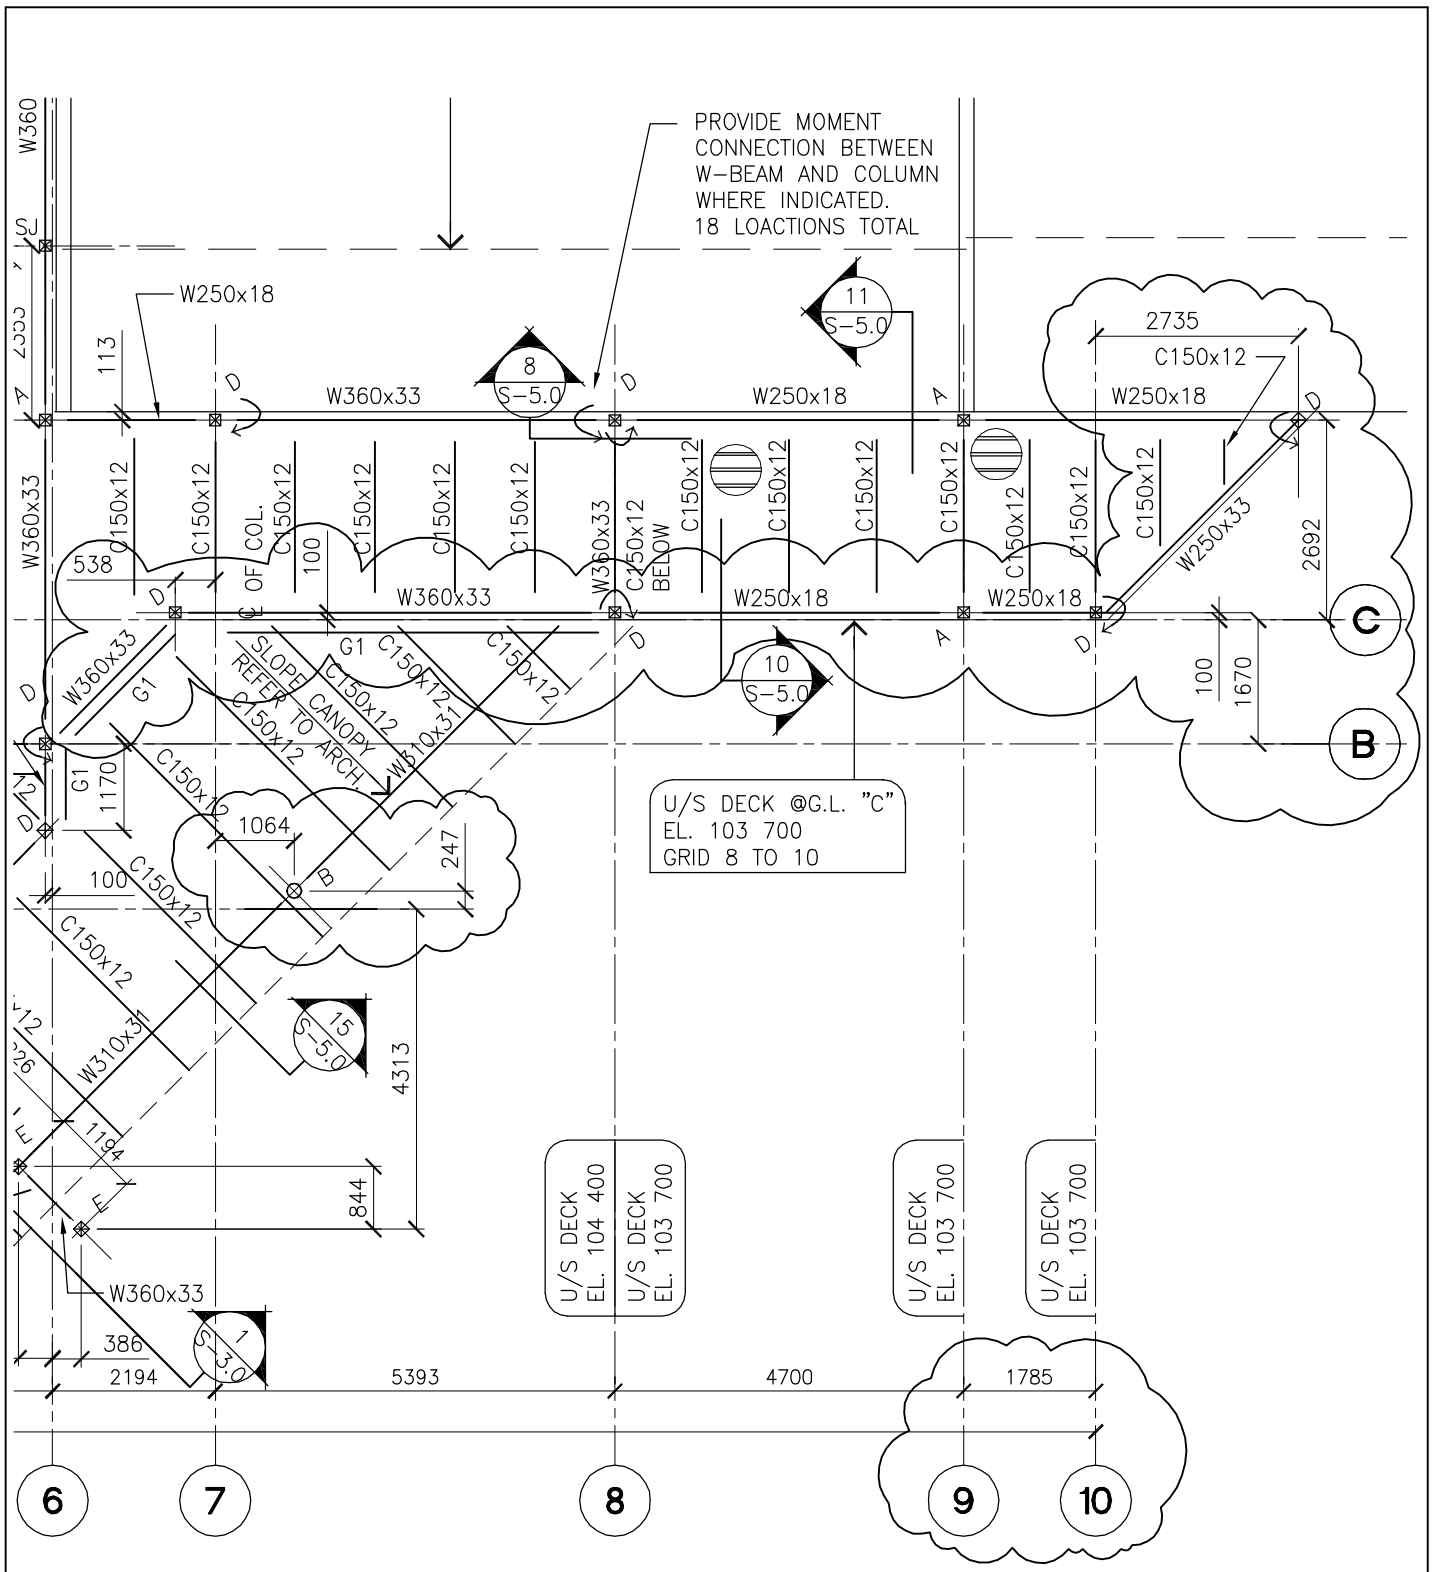

PARTIAL ROOF FRAMING PLAN

1 / S-4.0

SCALE: 1:100

REVISED

TOWER ENGINEERING GROUP
208-897 CORYDON AVE.
WINNIPEG, MB.
TEL: (204) 925-1150
FAX: (204) 925-1155

PROJECT TITLE: NORBERRY-GLENLEE COMMUNITY CENTRE EXPANSION

DRAWING TITLE: -ADDENDUM- ROOF FRAM. PLAN - GRID LINE "C" AND "10"

FILE: 6174

DATE: APR 21/08

DRAWING NO. / REVISION NO.

SR-1C