

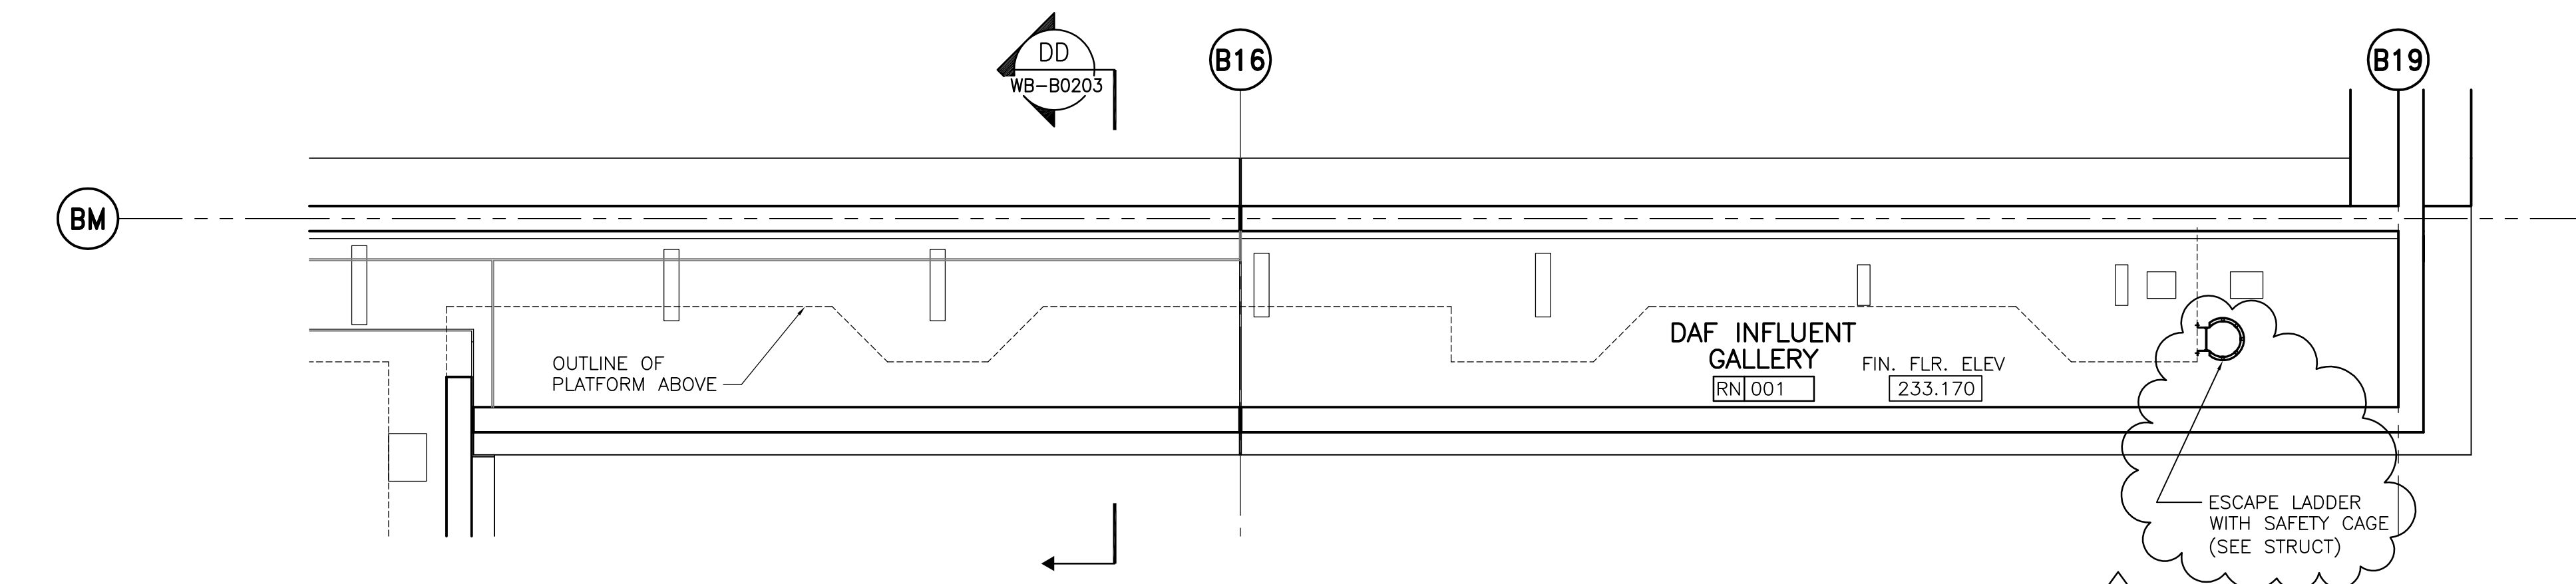


1 PARTIAL PLAN - DAF INFLUENT GALLERY (LOWER LEVEL)
WB-B0106 1:100

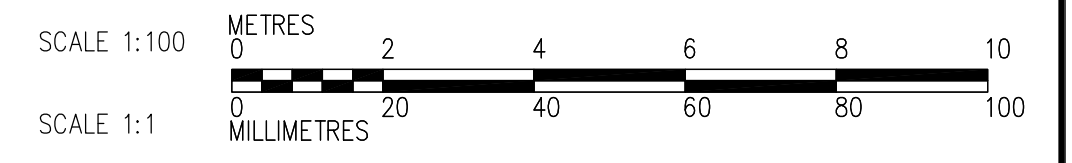

2 PARTIAL PLAN - DAF INFLUENT GALLERY (LOWER LEVEL)
WB-B0106 1:100

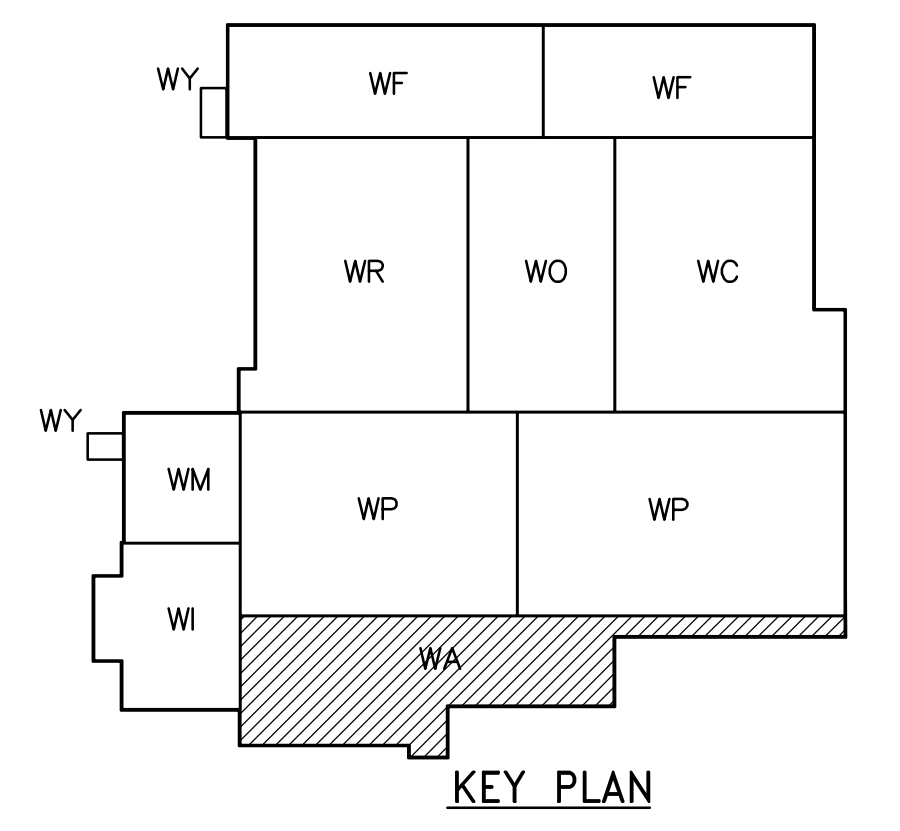

B.M. ELEV.				ENGINEER'S SEAL	
				ORIGINAL SIGNED BY	
		DESIGNED BY TWS		NEIL COOPER	
		DRAWN BY SH/LK/AL		2007/06/05	
		SCALE: 1:100		CONSULTANT DRAWING NO.	
01 95-2007 ADDENDUM 01 07/06/12 LK		CHECKED BY BJS		WB-B0106	
00 ISSUED FOR TENDER 07/06/05 LK		APPROVED BY AHL			
NO. REVISIONS		RELEASED FOR CONSTRUCTION BY: R. SOROKOWSKI			
DATE		DATE 2005/08/03			
BY		DATE 2007/06/05			

THE CITY OF WINNIPEG
 WATER AND WASTE DEPARTMENT
 ENGINEERING DIVISION
 WATER TREATMENT PLANT
 MAIN BUILDING
 OFFICE AND PLANT INTERIOR FINISHES
 ARCHITECTURAL
 PARTIAL PLAN OF DAF INFLUENT GALLERY
 (ELEV. 233.500)

CITY FILE NUMBER
 SHEET OF
 CITY DRAWING NUMBER
1-0601B-A-B0106-001-01