



3 STAIRWELL NO.3 SECTION DETAIL
WB-B0105 1:50

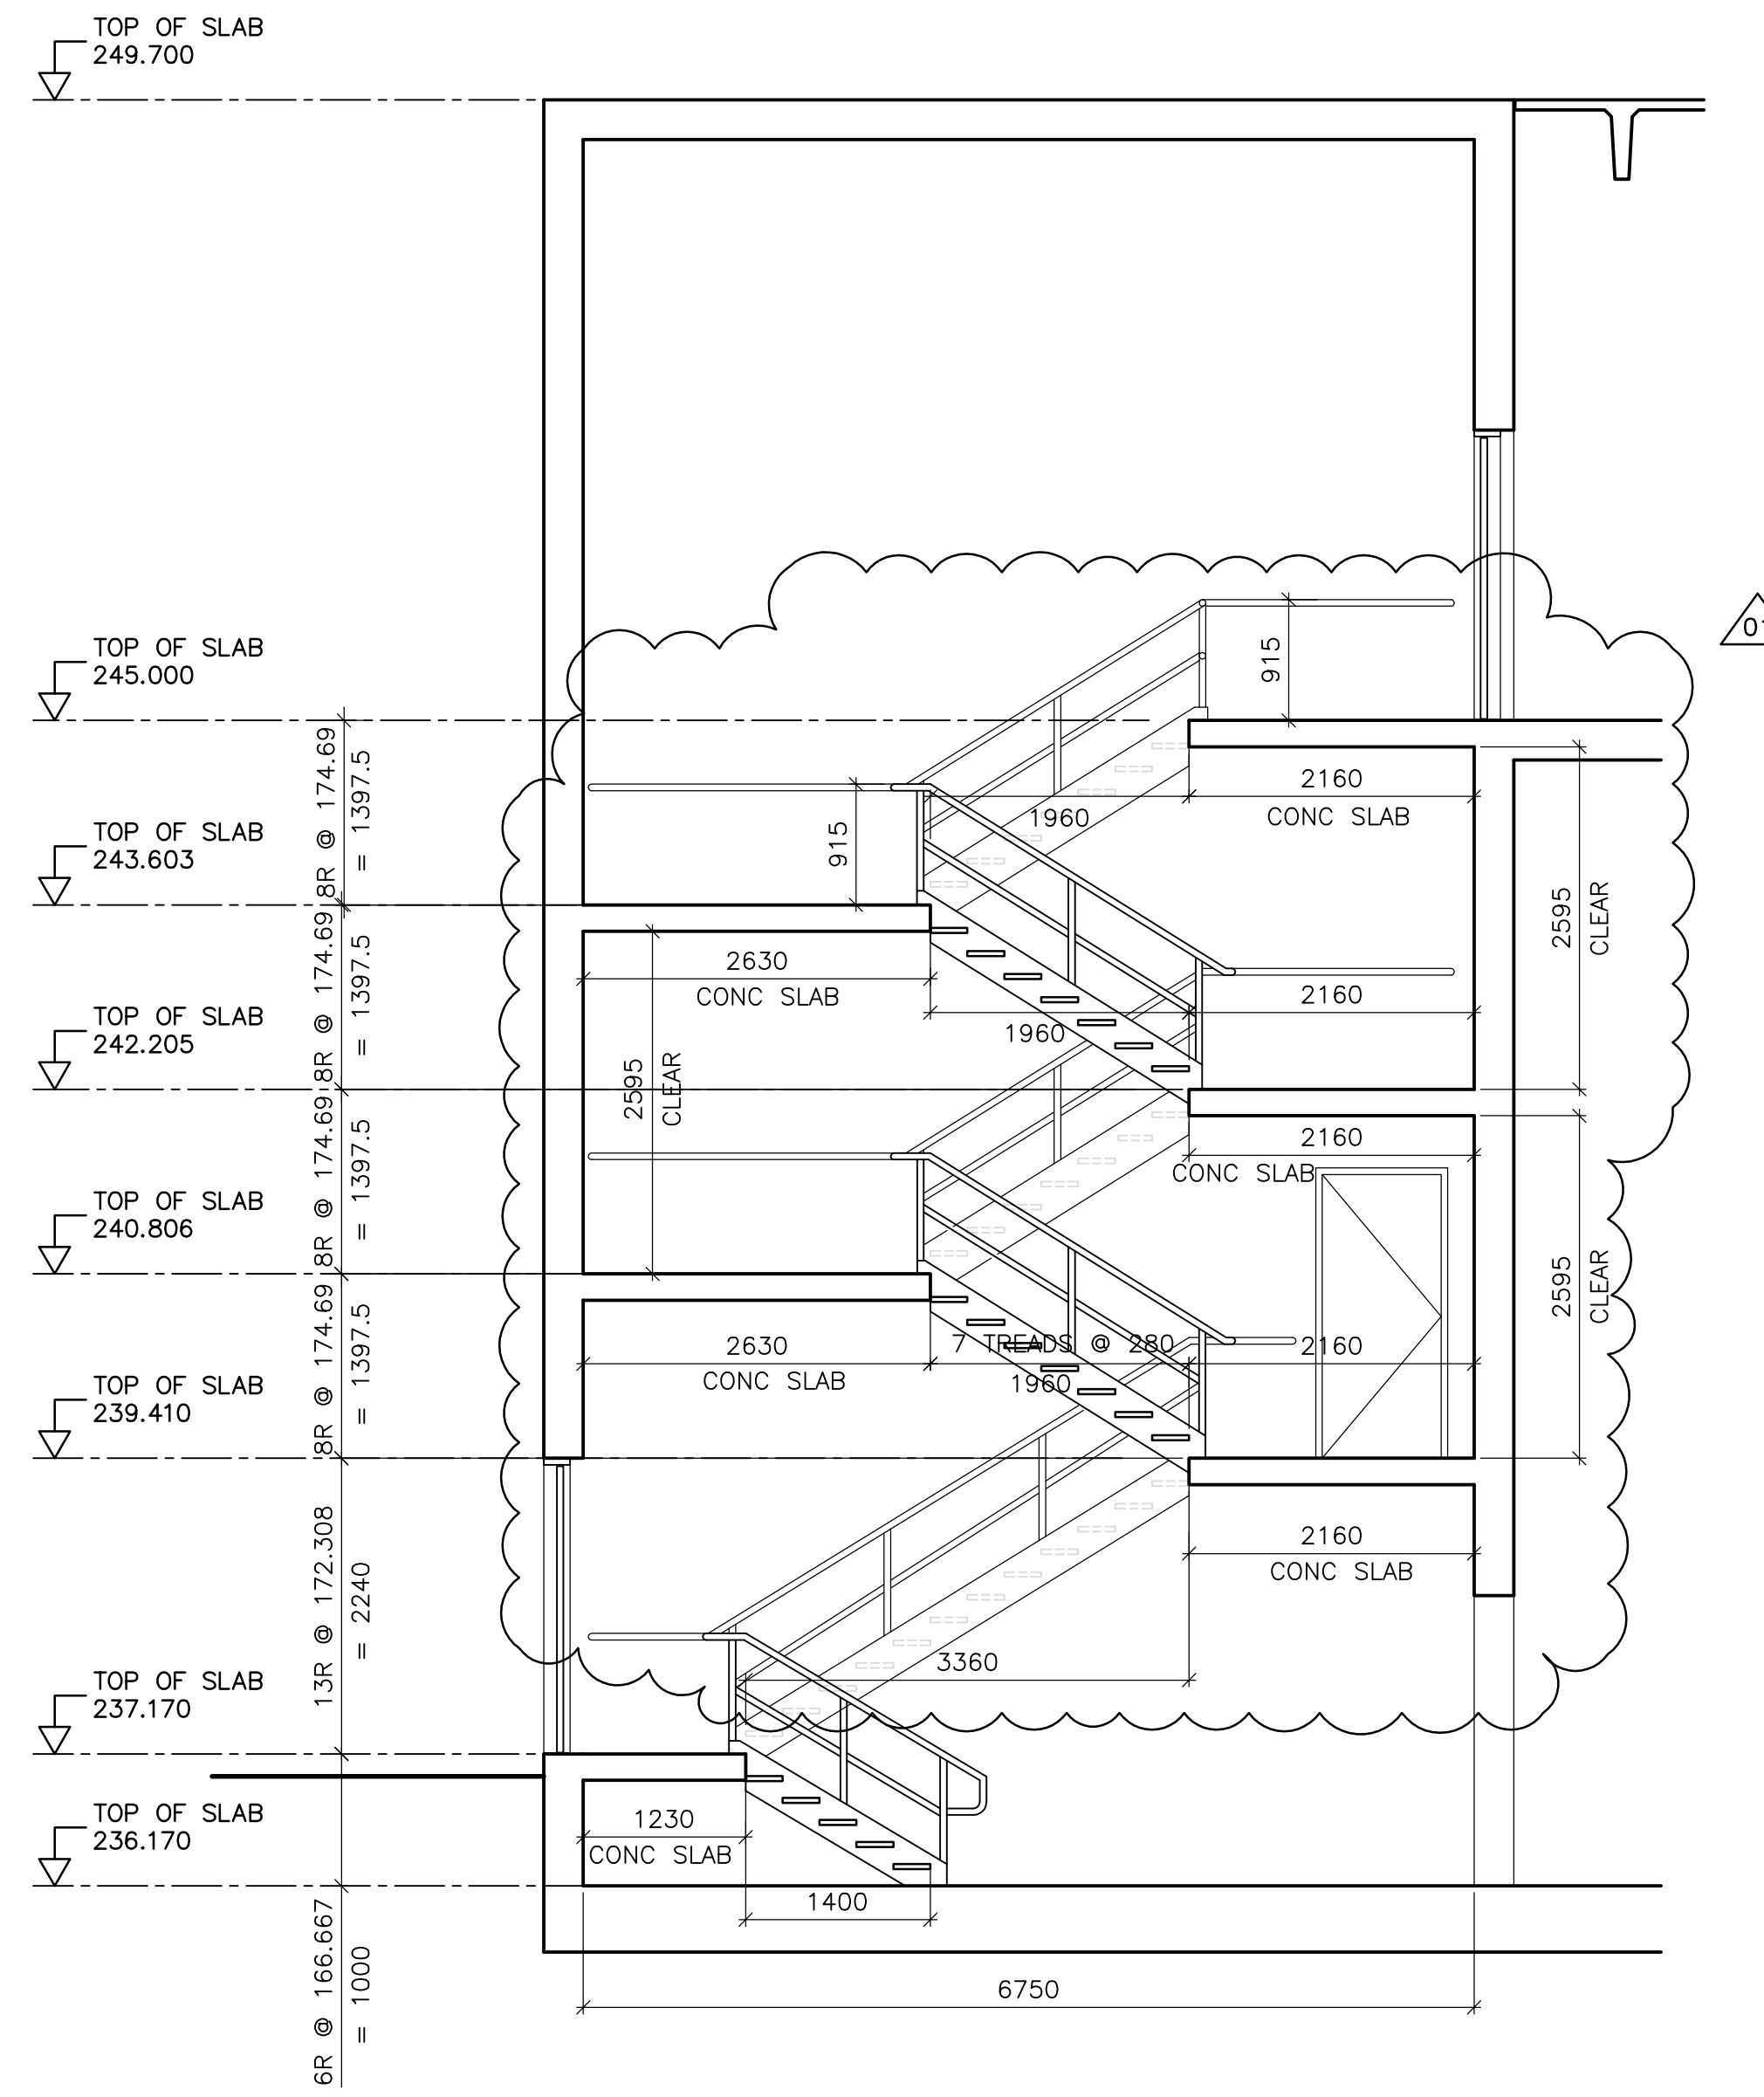

4 STAIRWELL NO.4 SECTION DETAIL
WB-B0113 1:50

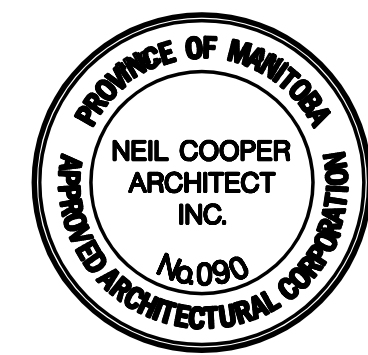

NO.	REVISIONS	DATE	BY
01	95-2007 ADDENDUM 01	07/06/12	LK
00	ISSUED FOR TENDER	07/06/05	LK

DESIGNED BY: NC	CHECKED BY: LK
DRAWN BY: SH/RS/AL	APPROVED BY: AHL
SCALE: 1:50	RELEASED FOR CONSTRUCTION BY: R. SOROKOWSKI
DATE: 2005/08/03	DATE: 2007/06/05

ENGINEER'S SEAL
ORIGINAL SIGNED BY: NEIL COOPER
DATE: 2007/06/05
CONSULTANT DRAWING NO. WB-B0802

THE CITY OF WINNIPEG
WATER AND WASTE DEPARTMENT
ENGINEERING DIVISION

WATER TREATMENT PLANT
MAIN BUILDING
OFFICE AND PLANT INTERIOR FINISHES

ARCHITECTURAL
STAIR SECTIONS

CITY FILE NUMBER
SHEET OF
CITY DRAWING NUMBER
1-0601B-A-B0802-001-01D