
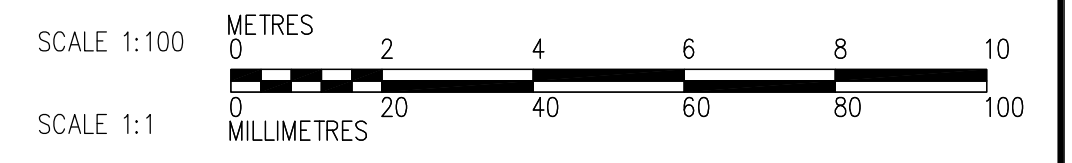
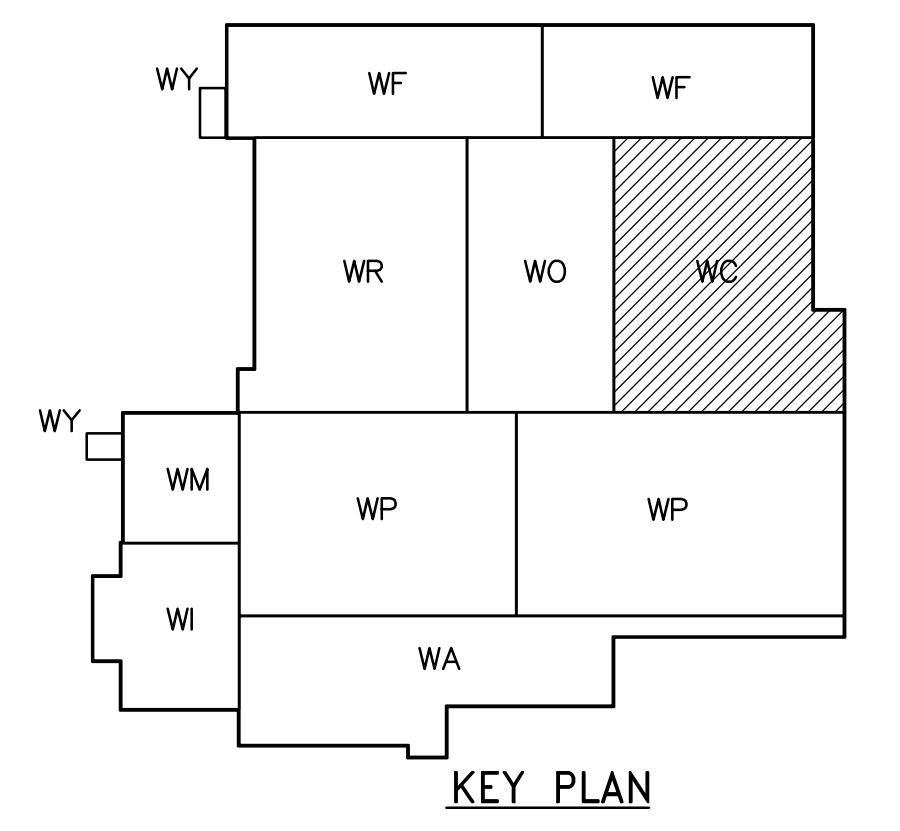


1 PARTIAL PLAN - WORKSHOP AREA (FIRST FLOOR)
WB-B0115 1:100

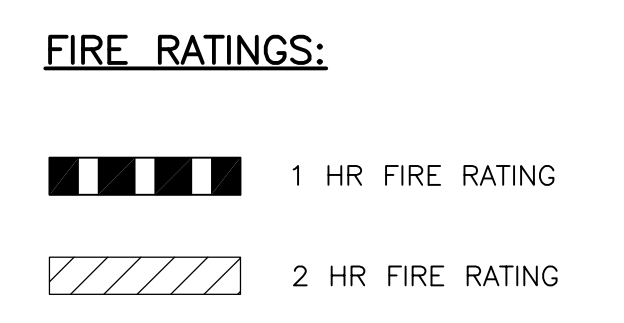

NO.	REVISIONS	DATE	BY
01	95-2007 ADDENDUM 02	07/06/20	LK
00	ISSUED FOR TENDER	07/06/05	LK

DESIGNED BY: TWS		CHECKED BY: BJS	
DRAWN BY: SH/LK		APPROVED BY: AHL	
SCALE: 1:100		RELEASED FOR CONSTRUCTION BY: R. SOROKOWSKI	
DATE: 2005/08/03		DATE: 2007/06/05	

ENGINEER'S SEAL
ORIGINAL SIGNED BY
NEIL COOPER
2007/06/05
CONSULTANT DRAWING NO.
WB-B0115

THE CITY OF WINNIPEG
WATER AND WASTE DEPARTMENT
ENGINEERING DIVISION

WATER TREATMENT PLANT
MAIN BUILDING
OFFICE AND PLANT INTERIOR FINISHES

ARCHITECTURAL
PARTIAL PLAN OF
WORKSHOP AREA

CITY FILE NUMBER
SHEET OF
CITY DRAWING NUMBER
1-0608-A-B0115-001-01D