


**WALL TYPES:**

- W1 EXISTING CAST-IN-PLACE CONCRETE TYPICAL UNLESS NOTED
- W2 CMU 290mm
- W3 CMU 240mm
- W4 CMU 190mm
- W5 CMU 140mm
- W6 CMU 90mm
- W6B1 CMU 90mm BURNISHED  
CMU 90mm BURNISHED  
(DUAL WHYTE - BACK TO BACK)
- W7 FROM FIN FLOOR TO 1200mm AFF:  
CMU 90mm BURNISHED  
13mm FURRING BAR @ 400mm O/C  
13mm GYP BD - PT  
FROM 1200mm AFF TO U/S OF CONCRETE SLAB - WALL TYPE W8
- W8 13mm GYP BD - PT  
92mm STEEL STUDS @ 400mm O/C  
13mm GYP BD - PT  
ACOUSTICAL BATT INSULATION  
ACOUSTICAL CAULK ON TOP & BOT PLATE.  
UP TO U/S OF SLAB EXCEPT IN ROOM 341 (KITCHEN)


- W2B CMU 290mm BURNISHED
- W3A CMU (VAR. THICKNESS)  
AIR SPACE (VARIES)  
92mm METAL STUDS  
13mm GYP BD - PT
- W4B CMU 190mm BURNISHED
- W4B1 FROM FIN FLOOR TO 3000mm AFF:  
CMU 190mm BURNISHED  
FROM 3000mm AFFL TO U/S OF SLAB:  
USE WALL TYPE 8
- W5B1 FROM FIN FLOOR TO 3000mm AFF:  
CMU 140mm BURNISHED  
FROM 3000mm AFFL TO U/S OF SLAB:  
USE WALL TYPE 8
- W5B2 CMU 140mm BURNISHED
- W6B2 CMU 90mm BURNISHED

**FIRE RATINGS:**

- 1 HR FIRE RATING
- 2 HR FIRE RATING

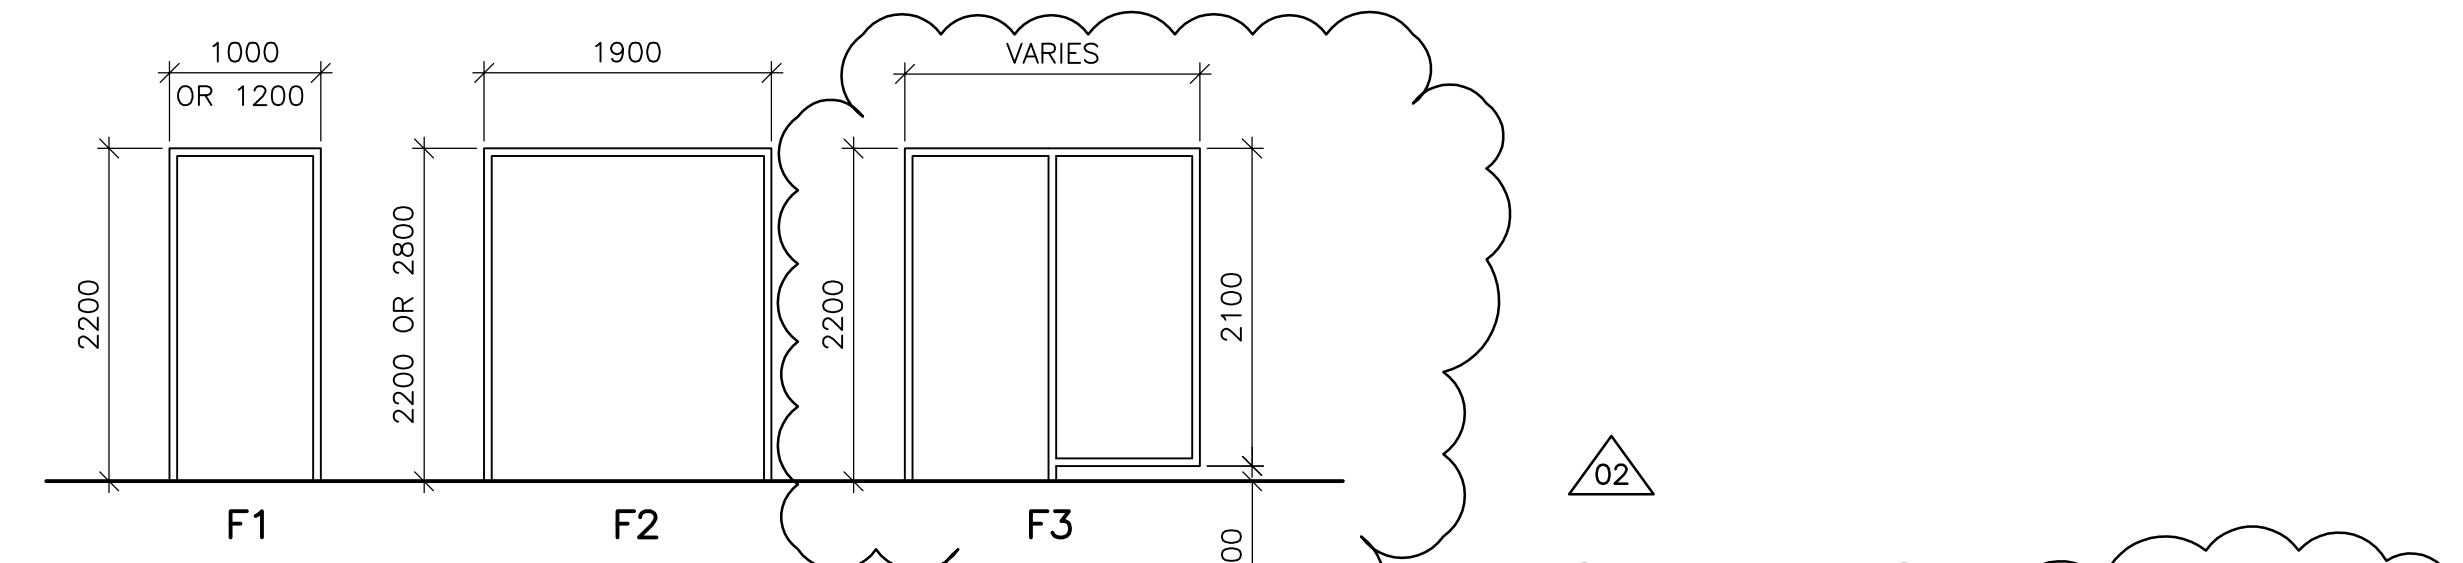

**FRAME TYPE:**

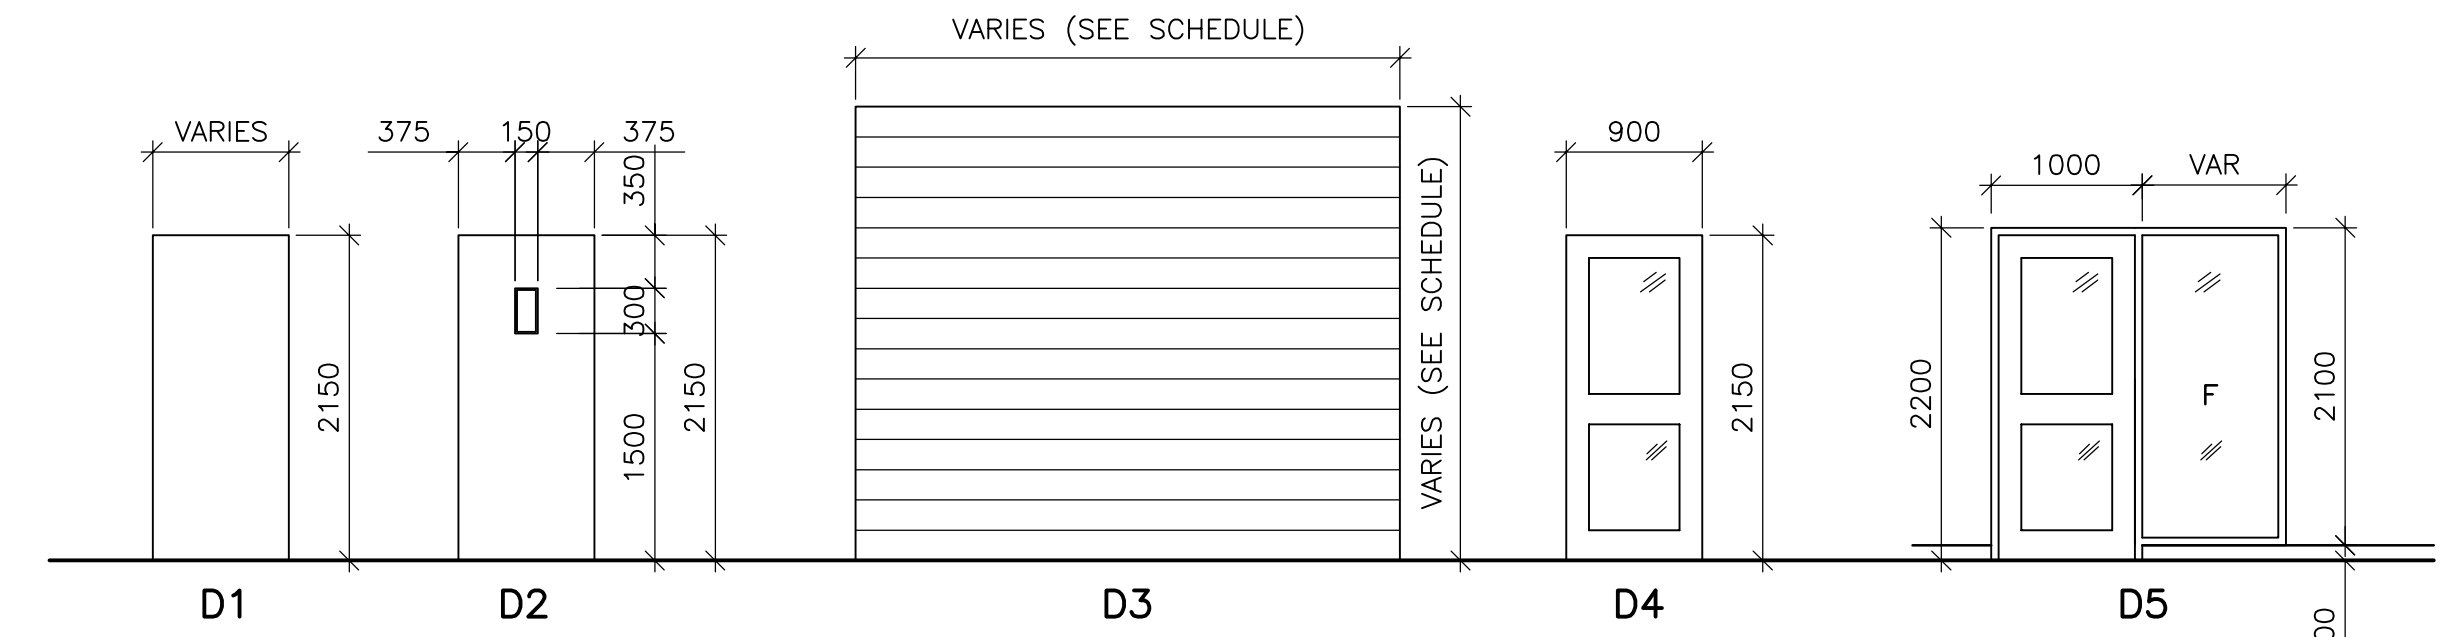

**DOOR TYPE:**

ALL COILING DOORS ARE ELECTRICALLY OPERATED

ALUMINUM/ GLAZED

ALUMINUM GLAZED DOOR WITH SIDELIGHT

**HARDWARE SCHEDULE:**

**Hardware Set MI 1**

3 Hinges	TA 314 4 1/2 x 4	32D	McKinney
1 Lockset-Storeroom	11G04 LL	26DCPC	Sargent
1 Closer	7500	SS	Norton
1 Kickplate	GSH 80A 10 x 1 1/2" LDW	32D	GSH
1 Floor Stop	GSH 218B	26D	GSH
1 Perimeter Gasket	319CN	C	Pemko
1 Auto Door Bottom	4301CRL 36"	C	Pemko

**Hardware Set MI 2**

3 Hinges	TA 314 4 1/2 x 4	32D	McKinney
1 Lockset-Storeroom	11G04 LL	26DCPC	Sargent
1 Closer	7500	SS	Norton
1 Kickplate	GSH 80A 10 x 1 1/2" LDW	32D	GSH
1 Floor Stop	GSH 218B	26D	GSH

**Hardware Set MI 3**

6 Hinges	TA 314 4 1/2 x 4	32D	McKinney
2 ea Flushbolts	GSH 401	26D	GSH
1 Passage Set	11U15 LL	26DCPC	Sargent
2 Kickplates	GSH 80A 10 x 1 1/2" LDW	32D	GSH
2 Closers	7500	SS	Norton
2 Floor Stops	GSH 280B	26D	GSH

**Hardware Set MI 4**

3 Hinges	TA 314 4 1/2 x 4	32D	McKinney
1 Passage Set	11U15 LL	26DCPC	Sargent
1 Kickplate	GSH 80A 10 x 1 1/2" LDW	32D	GSH
1 Closer	7500	SS	Norton
1 Floor Stop	GSH 280B	26D	GSH

**Hardware Set MI 5**

6 Hinges	TA 314 4 1/2 x 4	32D	McKinney
2 ea Flushbolts	GSH 401	26D	GSH
1 Passage Set	11U15 LL	26DCPC	Sargent
2 Kickplates	GSH 80A 10 x 1 1/2" LDW	32D	GSH
2 Closers	7500	SS	Norton
2 Floor Stops	GSH 280B	26D	GSH

**Hardware Set MI 6**

3 Hinges	TA 314 4 1/2 x 4	32D	McKinney
1 Privacy Set	11U65 LL	26DCPC	Sargent
1 Wall Stop	GSH 250B	26D	GSH

**Hardware Set MI 7**

3 Hinges	TA 314 4 1/2 x 4	32D	McKinney
1 Lockset-Storeroom	11G04 LL	26DCPC	Sargent
1 Closer	7500	SS	Norton
1 Kickplate	GSH 80A 10 x 1 1/2" LDW	32D	GSH
1 Floor Stop	GSH 218B	26D	GSH
1 Perimeter Gasket	319CN	C	Pemko
1 Auto Door Bottom	4301CRL 36"	C	Pemko

**Hardware Set MI 8**

6 Hinges	TA 314 4 1/2 x 4	32D	McKinney
2 ea Auto Flushbolts	GSH 401	26D	GSH
1 Passage Set	41-11U15 LL	26DCPC	Sargent
2 Kickplates	GSH 80A 10 x 1 1/2" LDW	32D	GSH
1 Co-ordinator	500 Series	26D	DCI
2 Closers	7500	SS	Norton
2 Floor Stops	GSH 280B	26D	GSH

**Hardware Set MI 9**

3 ea Hinges	TA 314 4 1/2 x 4	32D	McKinney
1 Lockset Office	11G05 LL	26DCPC	Sargent
1 Floor Stop	GSH280B	26D	GSH
1 Coat Hook	GSH307B	26D	GSH

**Hardware Set MI 10**

3 Hinges	TA 314 4 1/2 x 4	32D	McKinney
1 Passage	11U15 LL	26DCPC	Sargent
1 Closer	7500	SS	Norton
1 Kickplate	GSH 80A 10 x 1 1/2" LDW	32D	GSH
1 Floor Stop	GSH 218B	26D	GSH
1 Perimeter Gasket	319CN	C	Pemko
1 Auto Door Bottom	4301CRL 36"	C	Pemko

**Hardware Set MI 11**

3 ea Hinges	TA 314 4 1/2 x 4	32D	McKinney
1 Passage set	11U15 LL	26DCPC	Sargent
1 Floor Stop	GSH280B	26D	GSH

**Hardware Set MI 12**

3 Hinges	TA 314 4 1/2 x 4	32D	McKinney
1 Push Plate	GSH 81 4 x 16	32D	GSH
1 Pull	GSH 1907 4 x 16	32D	GSH
1 Closer	8501 SRI	689	Norton
1 Kickplate	GSH 80A 10 x 1 1/2" LDW	32D	GSH
1 Wall Stop	GSH 250B	26D	GSH

**Hardware Set MI 13**

3 Hinges	TA 314 4 1/2 x 4	32D	McKinney
1 Lockset -Storeroom	11G04 LL	26DCPC	Sargent
1 Closer	J8501 SRI	689	Norton
1 Kickplate	GSH 80A 10 x 1 1/2" LDW	32D	GSH
1 Floor Stop	GSH 218B	26D	GSH
1 Perimeter Gasket	319CN	C	Pemko
1 Auto Door Bottom	4301CRL 36"	C	Pemko

**Hardware Set MI 14**


6 Hinges	TA 314 4 1/2 x 4	32D	McKinney
2 Flushbolts	GSH 15	26D	GSH
1 Passage Set	11U15 LL	26DCPC	Sargent
2 Closers	J8501H SRI	689	Norton
2 Kickplates	GSH 80A 10 x 1 1/2" LDW	32D	GSH
2 Floor Stops	GSH 218B	26D	GSH
1 Perimeter Gasket	319CN 1/6 x 2/7	C	Pemko
2 Auto Door Bottoms	4301CRL 36"	C	Pemko

**Hardware Set MI 15**

3 Hinges	TA 314 4 1/2 x 4	32D	McKinney
1 Exit Device	7100F LUM x AU628F	32D	Yale
1 Closer	7500	SS	Norton
1 Kickplate	GSH 80A 10 x 1 1/2" LDW	32D	GSH
1 Wall Stop	GSH 250B	26D	GSH
1 Perimeter Gasket	319CN	C	Pemko
1 Auto Door Bottom	4301CRL 36"	C	Pemko

**Hardware Set MI 16**

3 Hinges	TA 314 4 1/2 x 4	32D	McKinney
1 Exit Device	7100F LUM x AU628F	32D	Yale
1 Closer	7500	SS	Norton
1 Kickplate	GSH 80A 10 x 1 1/2" LDW	32D	GSH
1 Wall Stop	GSH 250B	26D	GSH
1 Perimeter Gasket	319CN	C	Pemko
1 Auto Door Bottom	4301CRL 36"	C	Pemko

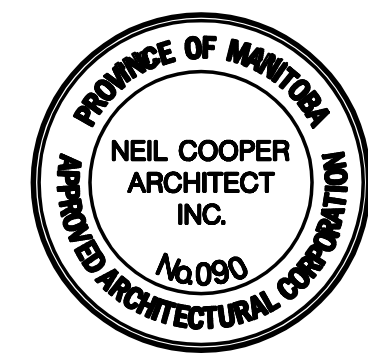

B.M. ELEV.					
02	95-2007 ADDENDUM 02	07/06/20	LK		
01	95-2007 ADDENDUM 01	07/06/12	LK		
00	ISSUED FOR TENDER (95-2007)	07/06/05	LK		
NO.	REVISIONS	DATE	BY	DATE	2005/08/03

DESIGNED BY	TWS	CHECKED BY	BJS
DRAWN BY	REH/LK	APPROVED BY	AHL
SCALE:	AS NOTED	RELEASED FOR CONSTRUCTION BY:	R. SOROKOWSKI
DATE	2005/08/03	DATE	2007/06/05

ENGINEER'S SEAL	ORIGINAL SIGNED BY	NEIL COOPER
		2007/06/05
CONSULTANT DRAWING NO.	WB-B0505	

**THE CITY OF WINNIPEG**  
WATER AND WASTE DEPARTMENT  
ENGINEERING DIVISION

WATER TREATMENT PLANT  
MAIN BUILDING  
OFFICE AND PLANT INTERIOR FINISHES

ARCHITECTURAL  
DOOR SCHEDULE  
DOOR TYPES AND SCHEDULES

CITY FILE NUMBER  
SHEET OF  
CITY DRAWING NUMBER  
1-0601B-A-B0505-001-02D