



3 MECH LOUVER DETAIL @ CONC STRUCTURE  
WB-B0133 1:20

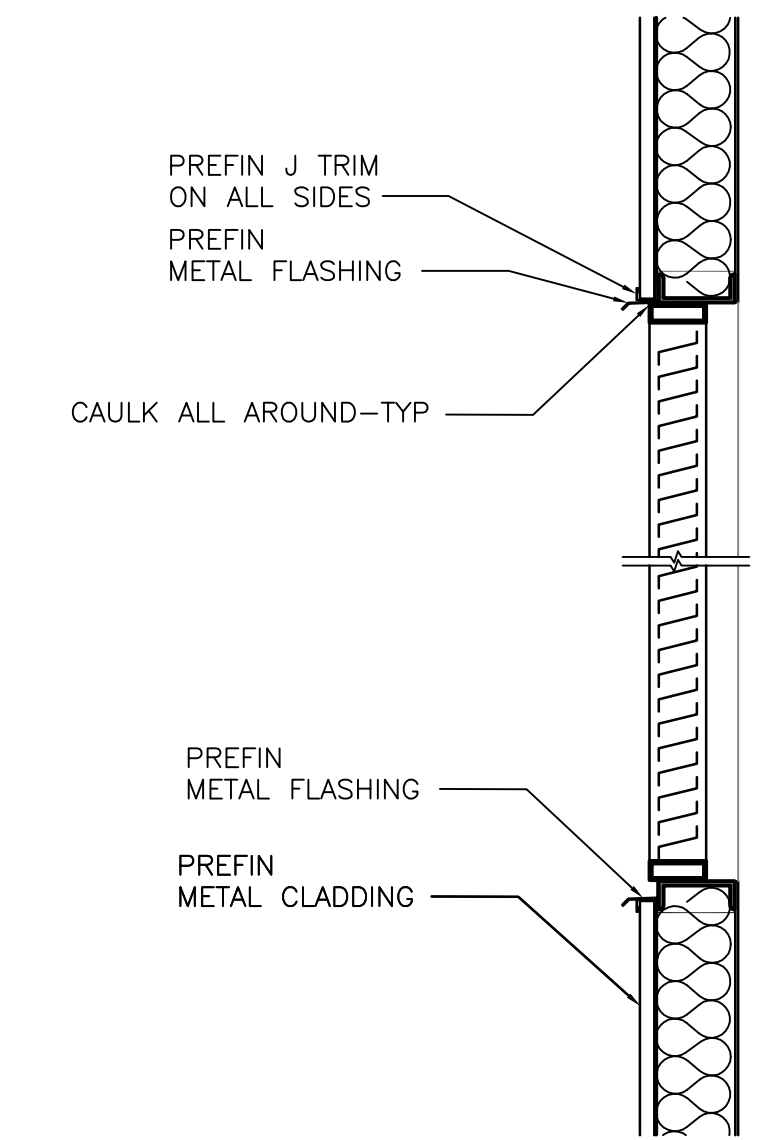



2 MECH LOUVER DETAIL @ METAL STRUCTURE  
WB-B0133 1:20

1 PARTIAL PLAN - MECHANICAL ROOM (THIRD FLOOR)  
WB-B0133 1:100

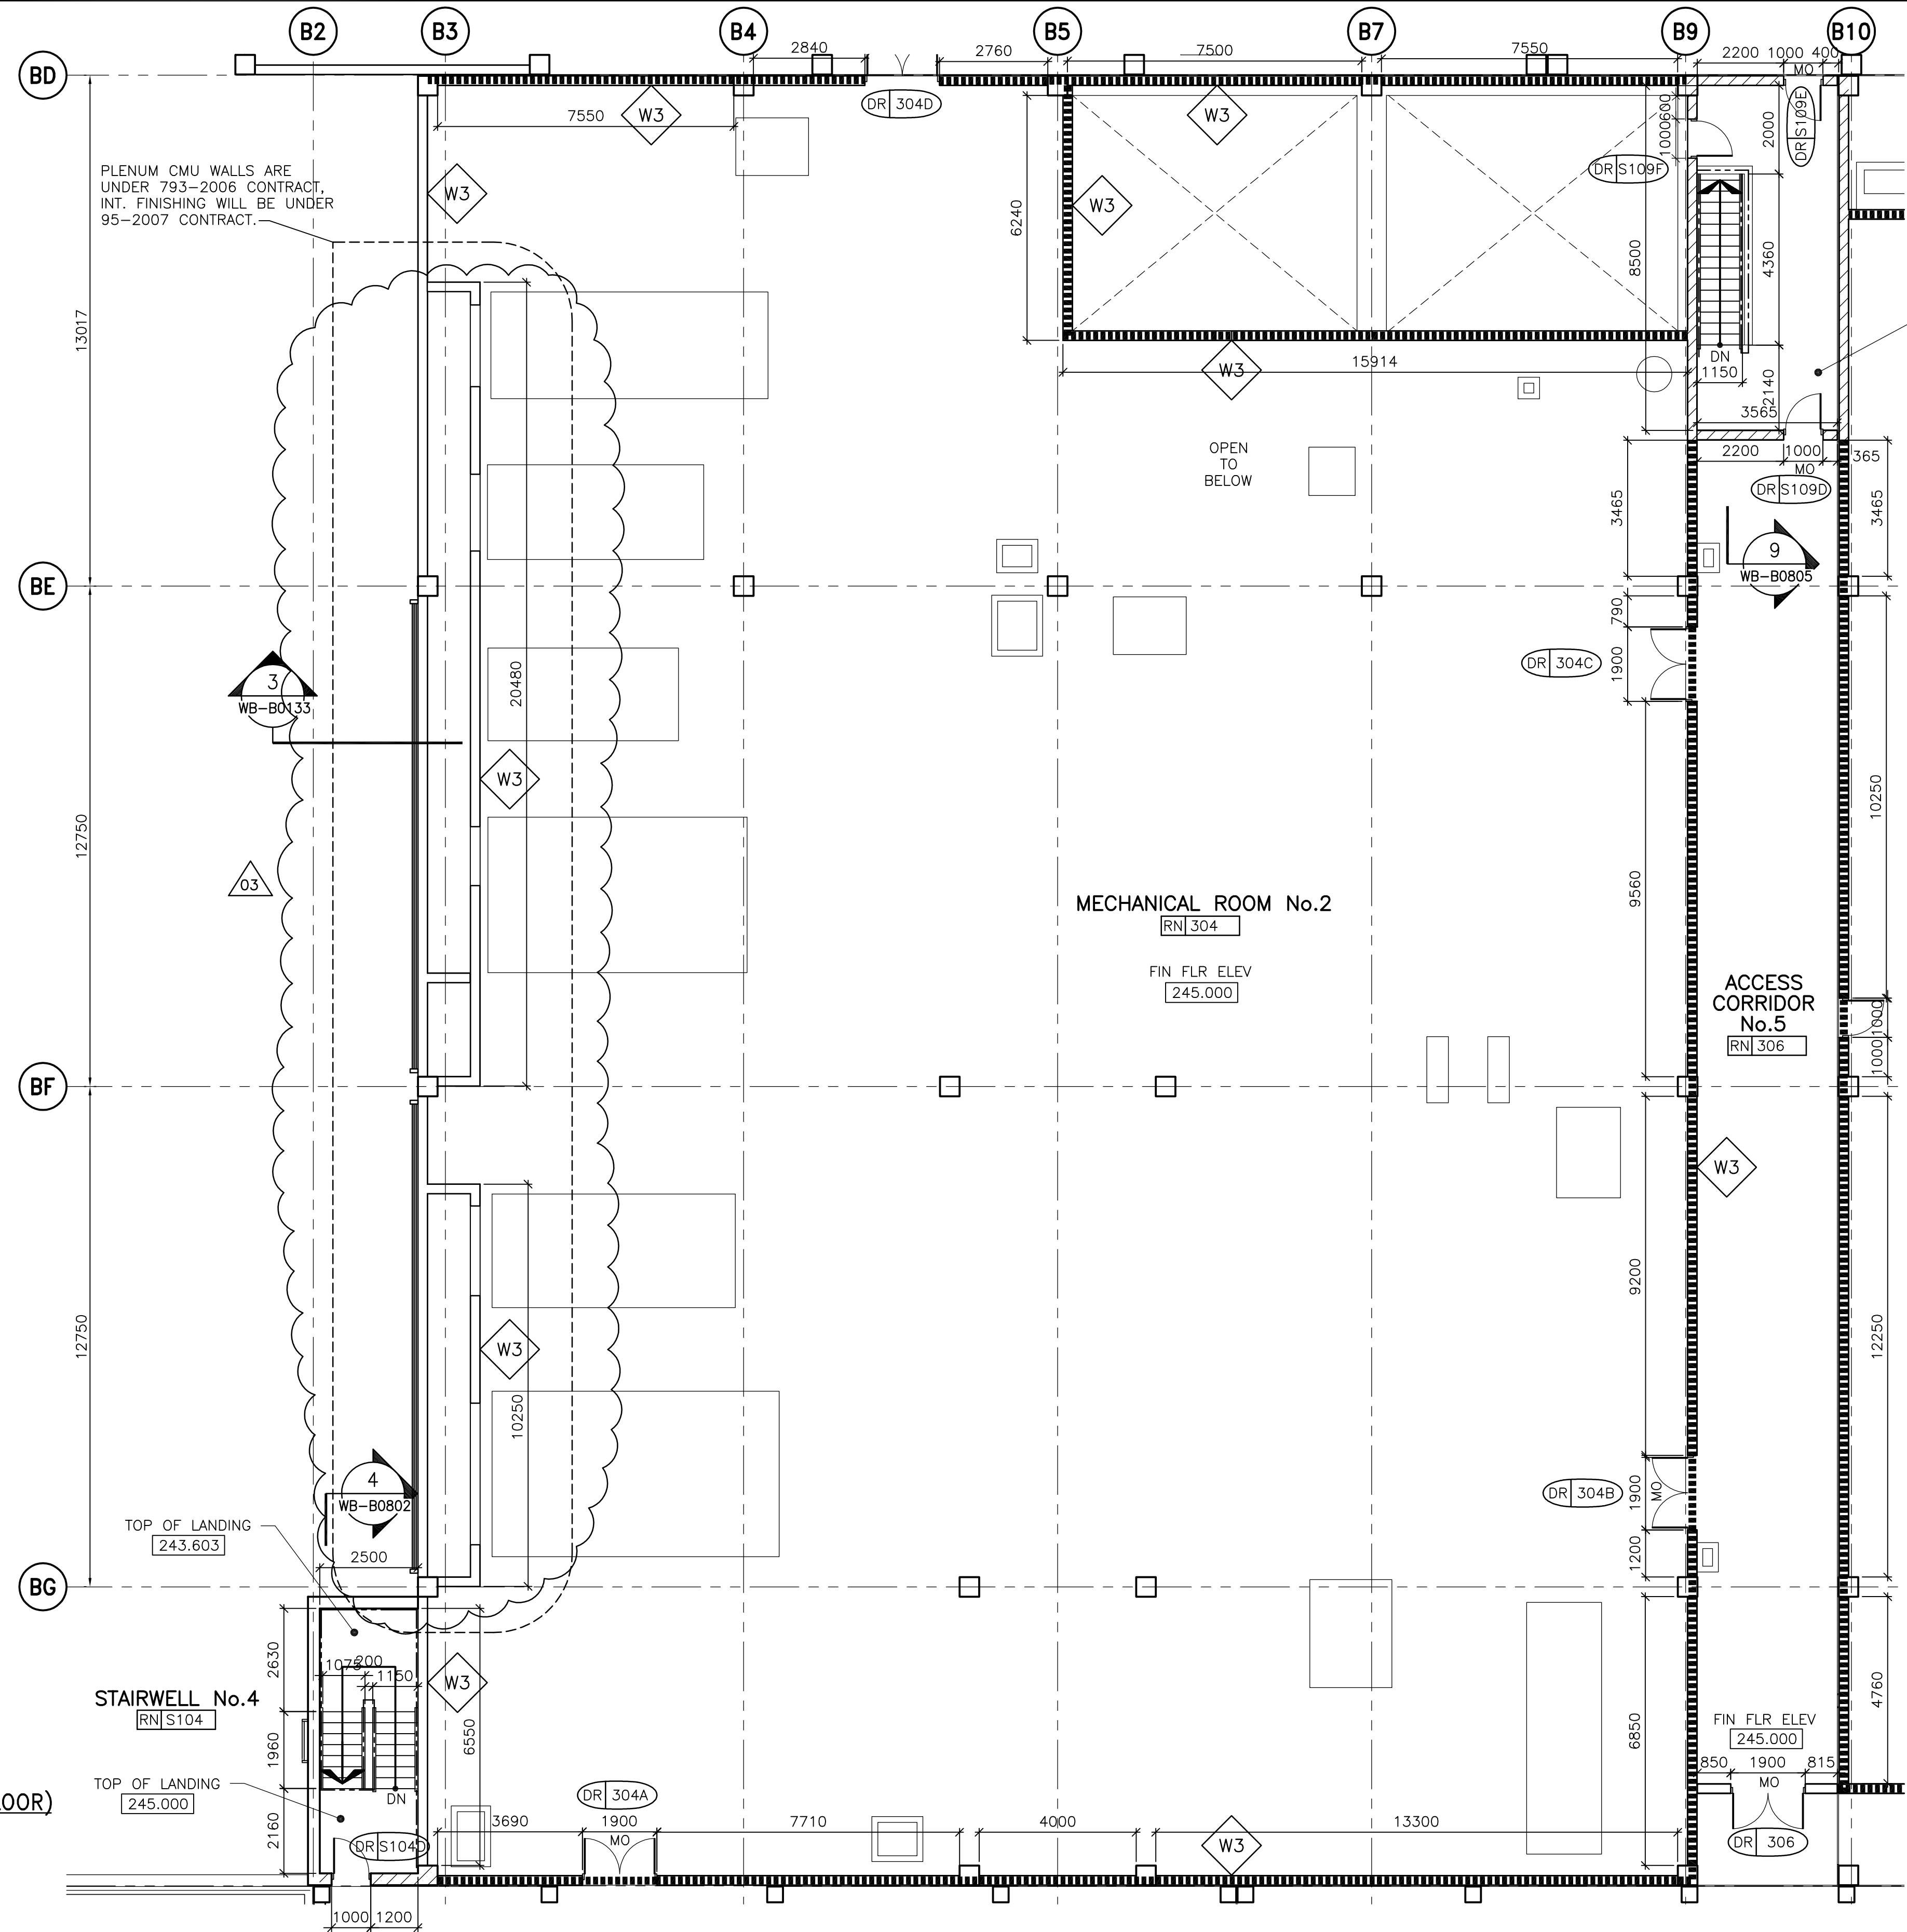

STAIRWELL No.9  
RN|S109  
TOP OF LANDING  
245.000

- WALL TYPES:**
- W3 CMU 240mm
- FIRE RATINGS:**
- 2 HR FIRE RATING
  - 1 HR FIRE RATING

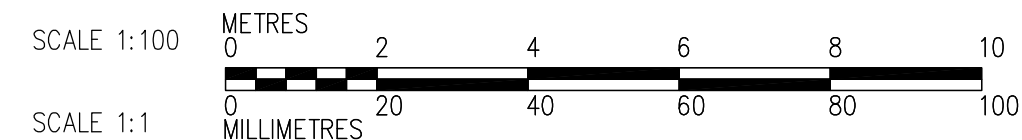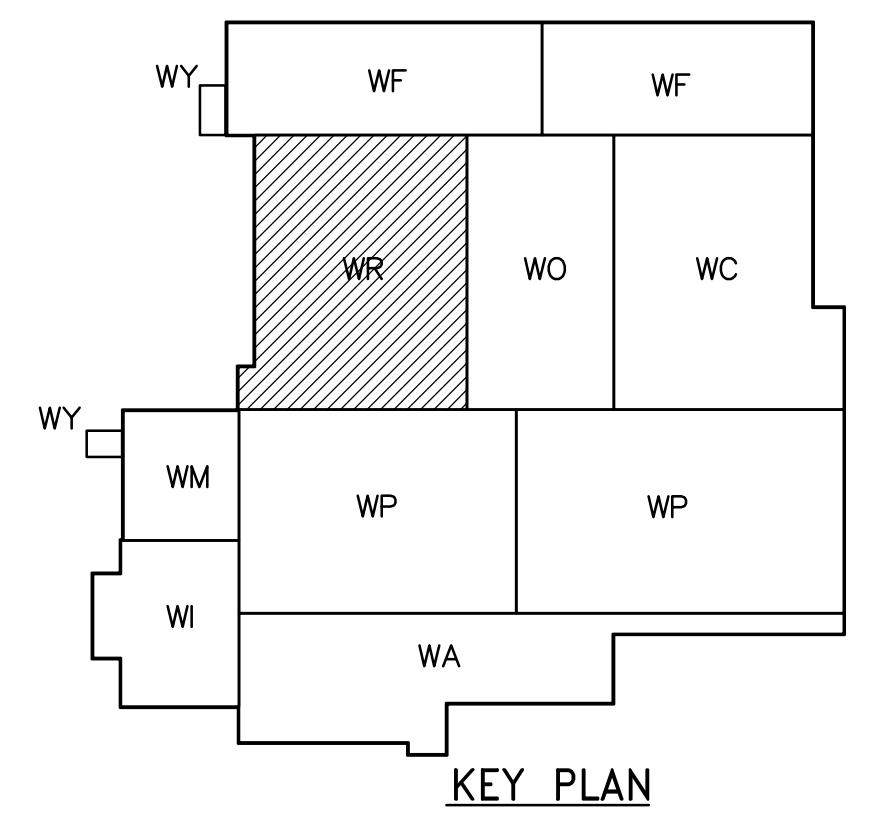

NO.	REVISIONS	DATE	BY
03	95-2007 ADDENDUM 08	07/08/01	LK
02	95-2007 ADDENDUM 05	07/07/13	LK
01	95-2007 ADDENDUM 01	07/06/12	LK
00	ISSUED FOR TENDER	07/06/05	LK

DESIGNED BY: TWS	CHECKED BY: BJS
DRAWN BY: AL/LK	APPROVED BY: AHL
SCALE: 1:100	RELEASED FOR CONSTRUCTION BY: R. SOROKOWSKI
DATE: 2005/08/03	DATE: 2007/06/05

ENGINEER'S SEAL  
ORIGINAL SIGNED BY  
NEIL COOPER  
2007/06/05  
CONSULTANT DRAWING NO.  
WB-B0133

**THE CITY OF WINNIPEG**  
WATER AND WASTE DEPARTMENT  
ENGINEERING DIVISION

WATER TREATMENT PLANT  
MAIN BUILDING  
OFFICE AND PLANT INTERIOR FINISHES

ARCHITECTURAL  
PARTIAL PLAN OF  
MECHANICAL ROOM

CITY FILE NUMBER  
SHEET OF  
CITY DRAWING NUMBER  
1-0601B-A-B0133-01-03D