


DD BUILDING SECTION
SCALE 1:200



EE BUILDING SECTION
SCALE 1:200

NOTE: BUILDING ENVELOPE AND ROOFING - NOT IN CONTRACT (REFER TO BID OPPORTUNITY 793-2006 & 171-2006 - TYP)

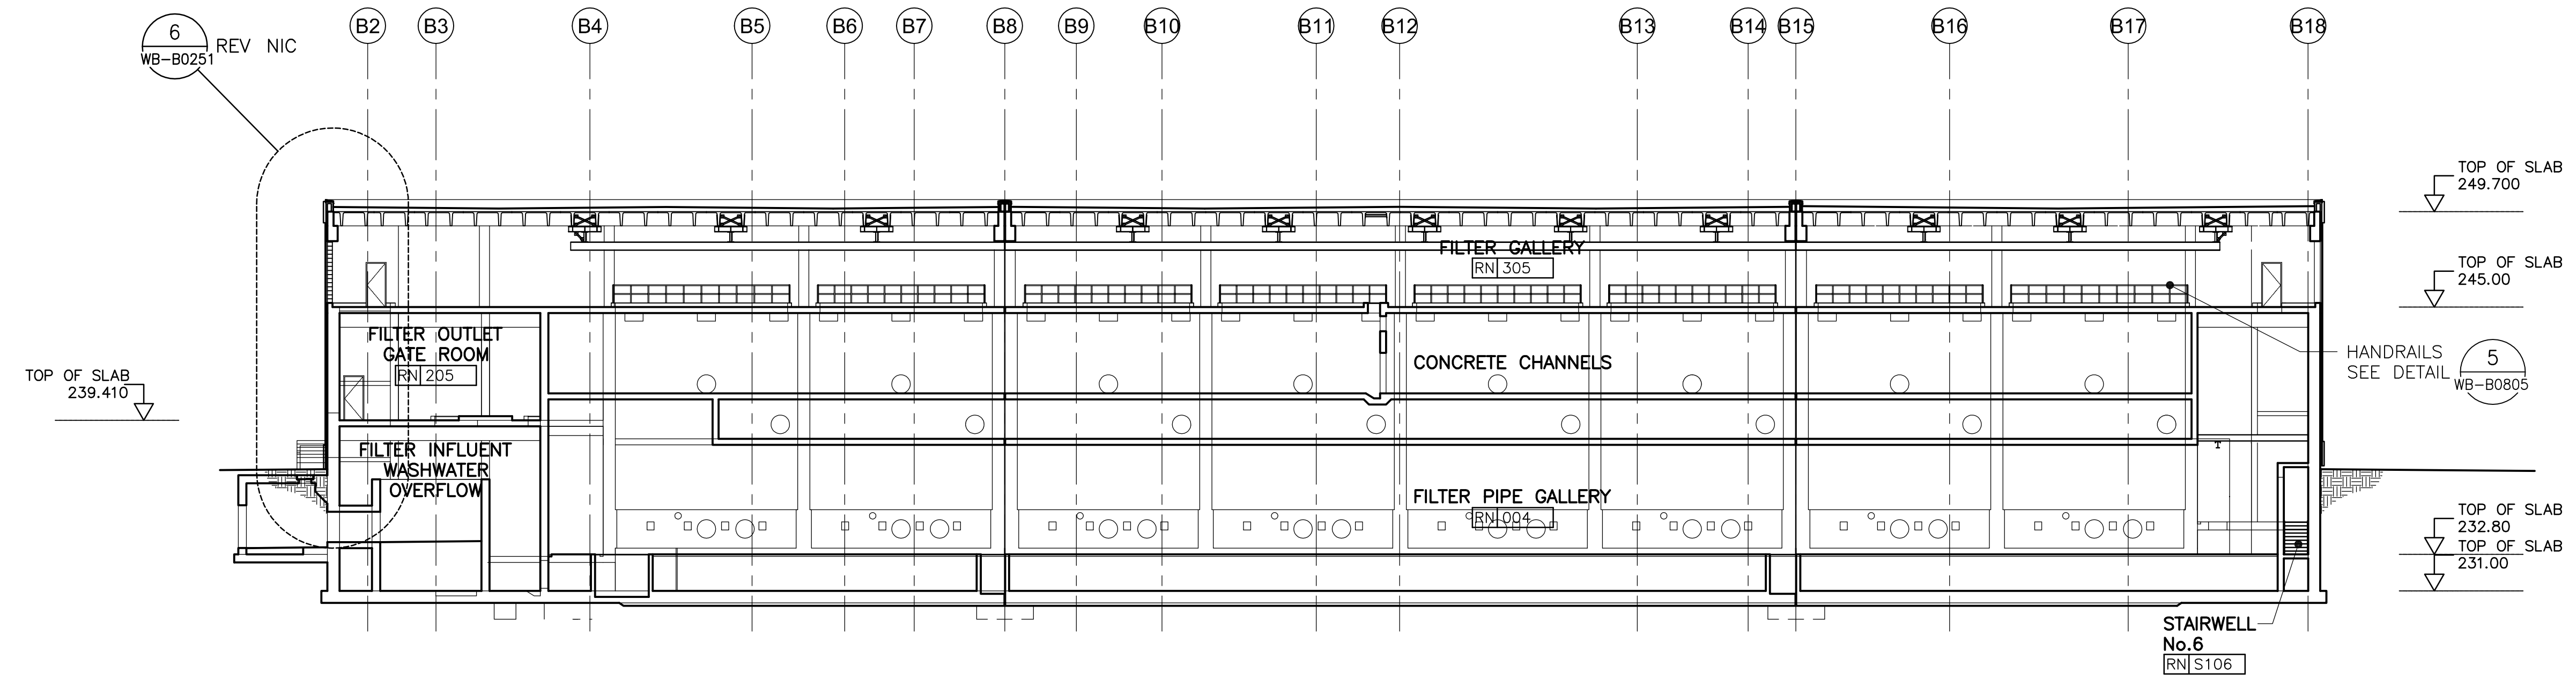

NO.	REVISIONS	DATE	BY
02	ISSUED FOR TENDER (95-2007)	07/06/05	LK
01	ISSUED FOR CONSTRUCTION	07/05/25	LK
00	ISSUED FOR TENDER (793-2006)	07/03/19	LK

DESIGNED BY	NC	CHECKED BY	LK
DRAWN BY	AL/LK/IC	APPROVED BY	AHL
SCALE:	AS NOTED	RELEASED FOR CONSTRUCTION BY:	R. SOROKOWSKI
DATE	2005/08/05	DATE	2007/03/19

ENGINEER'S SEAL
ORIGINAL SIGNED BY
NEIL COOPER
2007/03/19
CONSULTANT DRAWING NO.
WB-B0203

THE CITY OF WINNIPEG
WATER AND WASTE DEPARTMENT
ENGINEERING DIVISION

WATER TREATMENT PLANT
MAIN BUILDING
BUILDING ENVELOPE

ARCHITECTURAL
BUILDING SECTIONS

CITY FILE NUMBER
SHEET OF
CITY DRAWING NUMBER
1-0601B-A-B0203-001-02D