


STARTER UNIT

FIELD

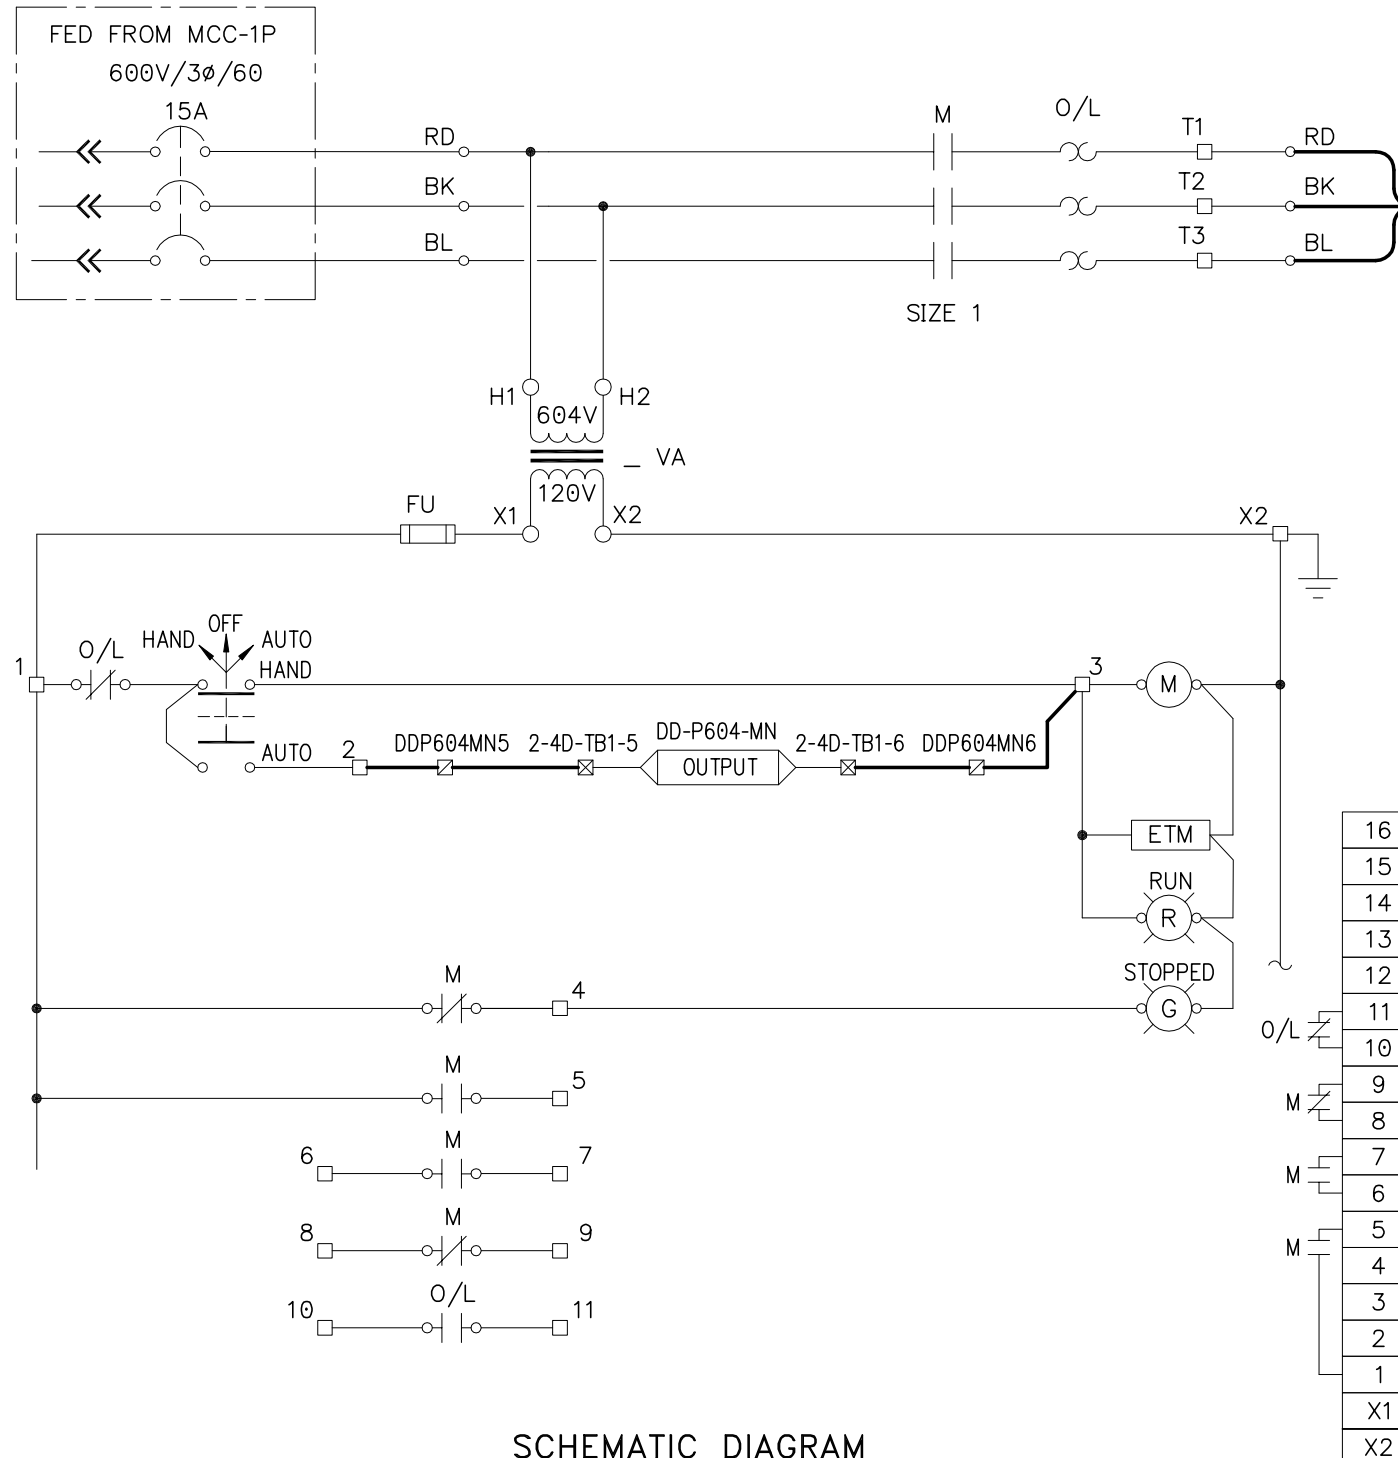

SCHEMATIC DIAGRAM

LEGEND

- () CONDUCTOR IDENTIFICATION
- STARTER TERMINALS
- ⊠ DCS TERMINALS
- ⊡ PTC TERMINALS
- FIELD WIRING
- PANEL WIRING
- WIRE CONNECTION
- PILOT LIGHT
- ETM ELAPSED TIME METER


NOTES:

1. -

CONSTRUCTION NOTES:

1. REMOVE EXISTING LOCK-OFF-STOP PUSHBUTTON LOCAL TO MOTOR.

16
15
14
13
12
11
10
M
8
M
7
M
6
5
4
3
2
1
X1
X2

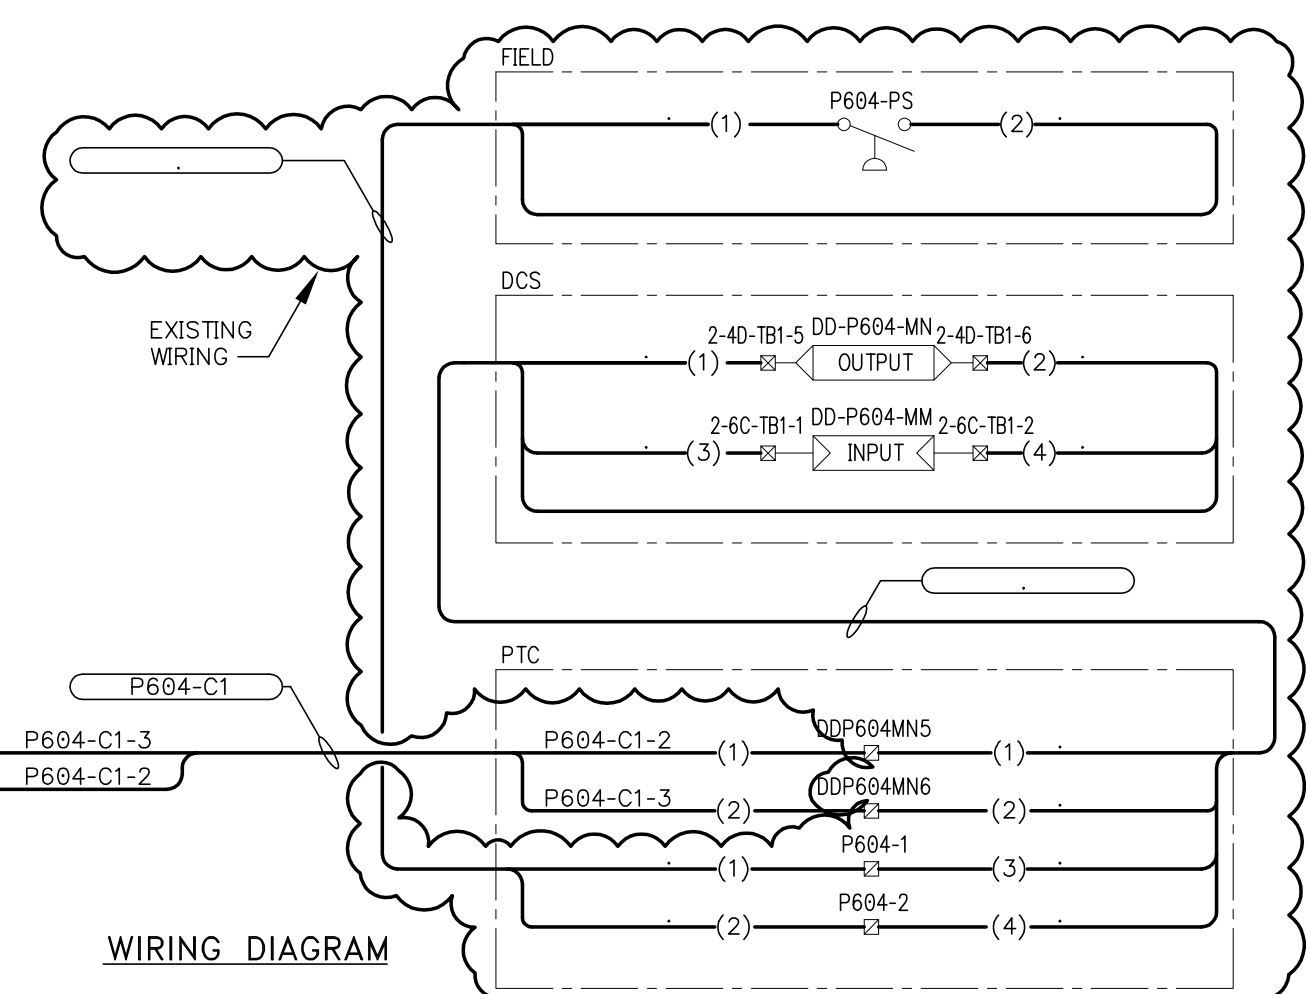

WIRING DIAGRAM



B.M. ELEV.	FIELD BOOK #:				
POSTED TO LBIS					
DESIGNED BY: DDW	CHECKED BY: REW			NORTH END WATER POLLUTION CONTROL CENTRE MOTOR STARTER P604-1PF25 WINTER EXHAUST FAN 1 CLARIFIERS 4 & 5	SHEET 001 OF 001 CITY DRAWING NUMBER 1-0101P-E0009-001
DRAWN BY: GCH	APPROVED BY:				
HOR. SCALE: N.T.S.	RELEASED FOR CONSTRUCTION:	TENDER No: 25-2008			
VERTICAL:	DATE: 19/01/07	FILENAME: 1-0101P-E0009-001			
NO. REVISIONS	DATE BY	PLOT DATE: 15/02/08			