


STARTER UNIT

FIELD

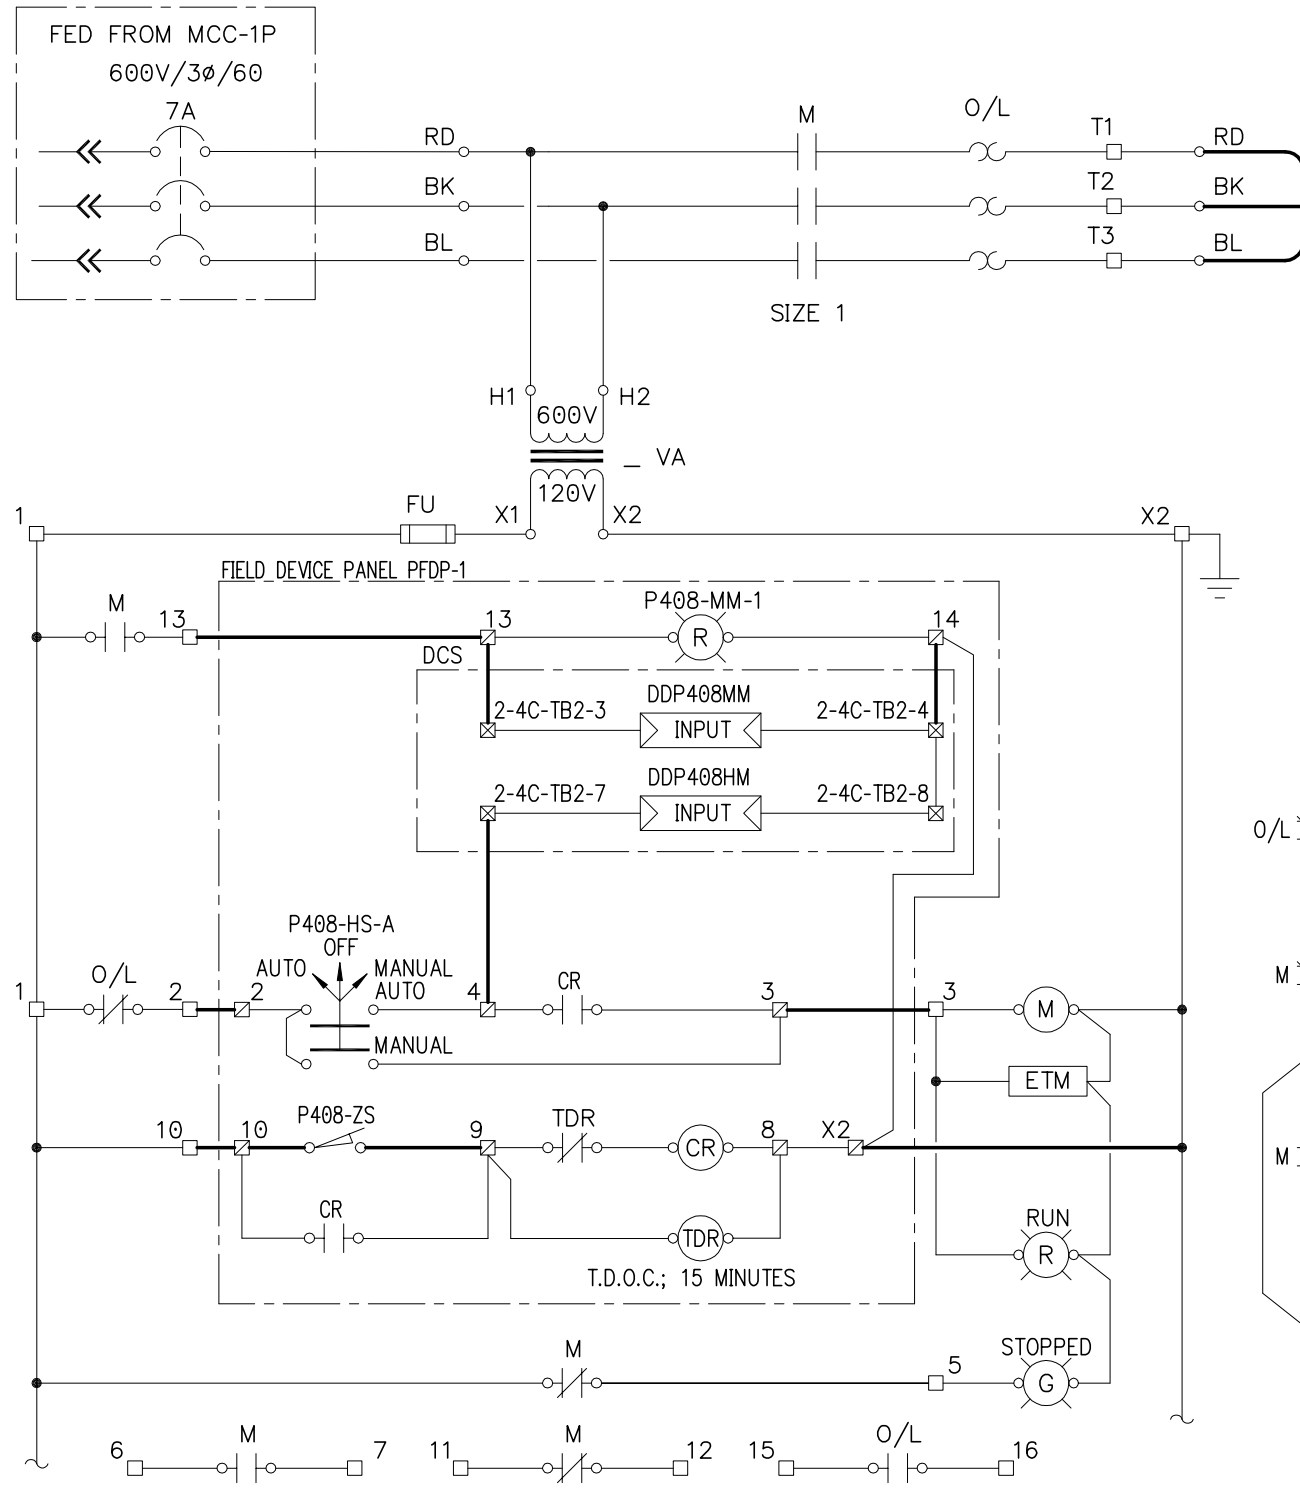


SCHMATIC DIAGRAM

LEGEND

- STARTER TERMINALS
- ⊠ PFDP-1 TERMINALS
- ⊠ DCS TERMINALS
- PILOT LIGHT
- () CONDUCTOR IDENTIFICATION
- FIELD WIRING
- PANEL WIRING
- WIRE CONNECTION
- ETM ELAPSED TIME METER

NOTES:

1. -

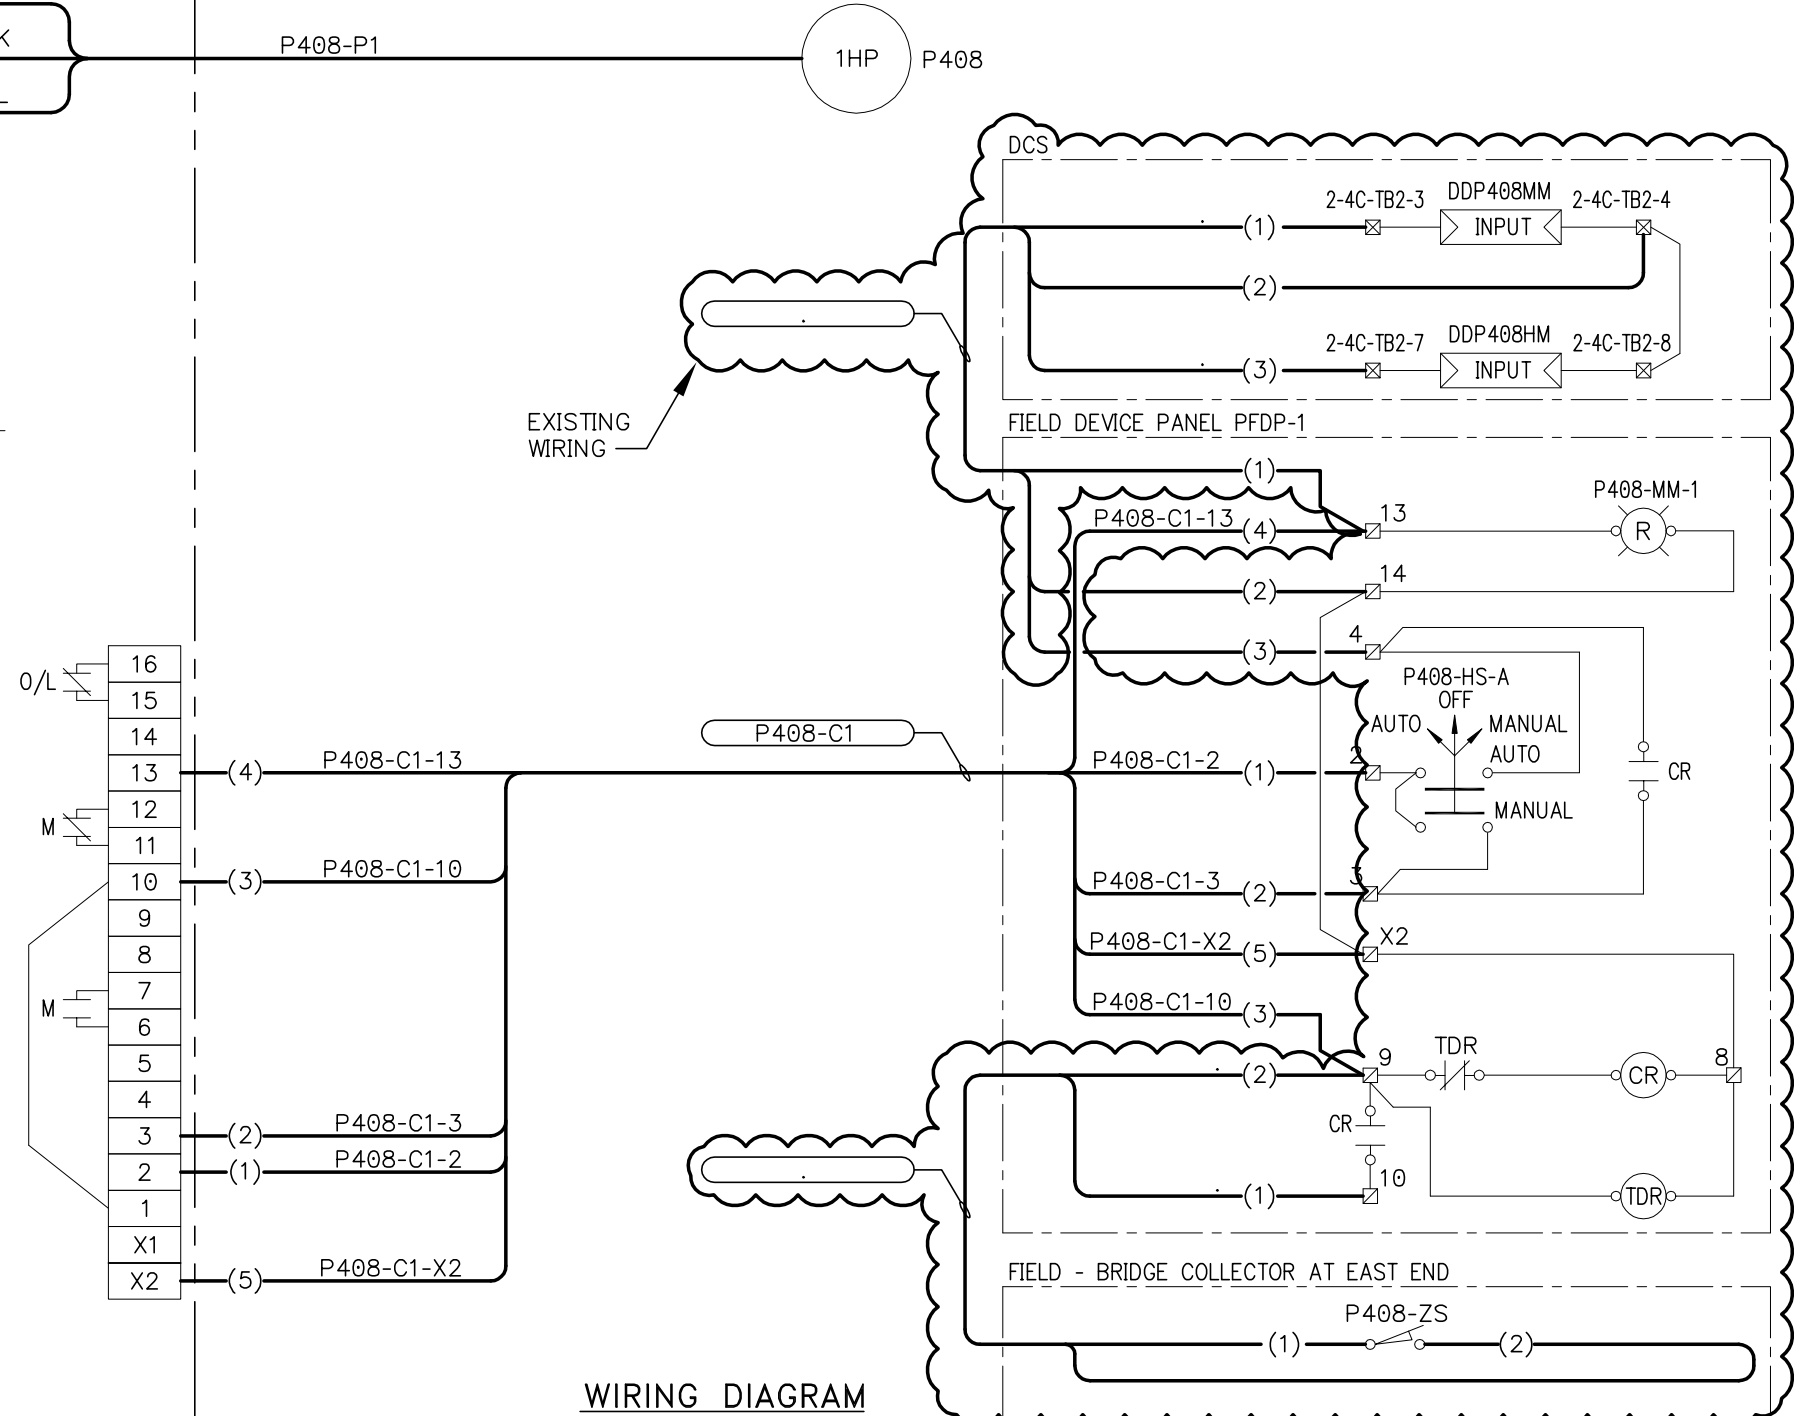

WIRING DIAGRAM



B.M. ELEV.	FIELD BOOK #:
POSTED TO LBIS	
DESIGNED BY: DDW	CHECKED BY: REW
DRAWN BY: GCH	APPROVED BY: .
HOR. SCALE: N.T.S.	RELEASED FOR CONSTRUCTION: .
VERTICAL: .	DATE: 23/05/07
NO. REVISIONS	DATE BY
01 ISSUED FOR TENDER	15/02/08 REW

KGS GROUP
CONSULTING ENGINEERS & PROJECT MANAGERS

CH2MHILL

ENGINEER'S SEAL
PROVINCE OF MANITOBA
R.E. WILLMS
REGISTERED PROFESSIONAL ENGINEER

THE CITY OF WINNIPEG
WATER AND WASTE DEPARTMENT

NORTH END WATER POLLUTION CONTROL CENTRE
MOTOR STARTER
P408-1PM13
SCUM CROSS COLLECTOR 1 CLARIFIER 4

TENDER No: 25-2008
FILENAME: 1-0101P-E0015-001
PLOT DATE: 15/02/08

SHEET 001 OF 001
CITY DRAWING NUMBER
1-0101P-E0015-001