STARTER UNIT

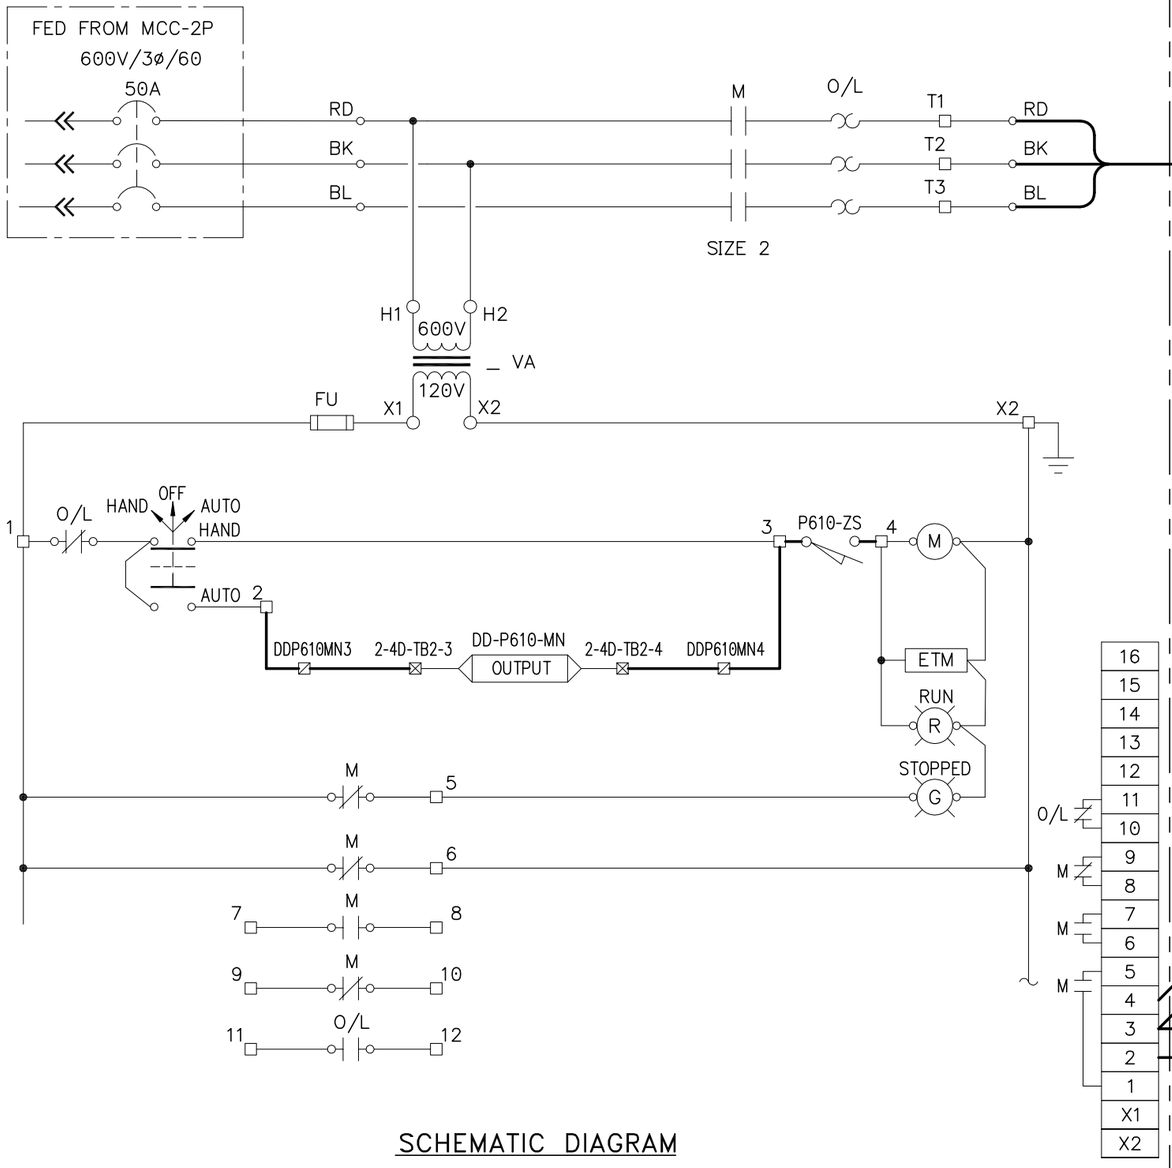

SCHEMATIC DIAGRAM

FIELD

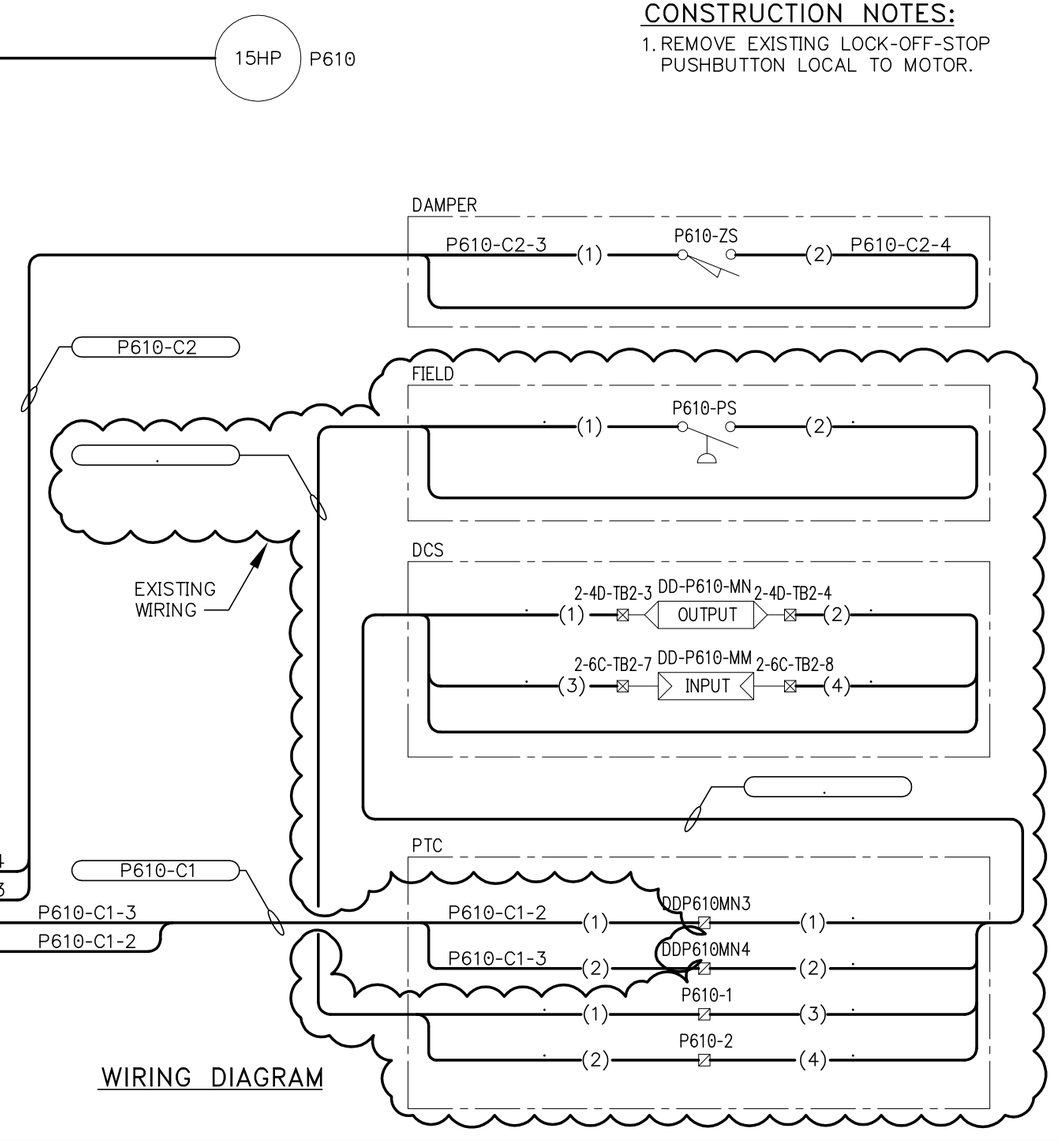

WIRING DIAGRAM

NOTES:

1. -

CONSTRUCTION NOTES:

1. REMOVE EXISTING LOCK-OFF-STOP PUSHBUTTON LOCAL TO MOTOR.

LEGEND

( )	CONDUCTOR IDENTIFICATION		FIELD WIRING
□	STARTER TERMINALS		PANEL WIRING
⊠	DCS TERMINALS		WIRE CONNECTION
◪	PTC TERMINALS		PILOT LIGHT
		ETM	ELAPSED TIME METER

APEGM Certificate of Authorization KGS Group No. 245 Date:

B.M. ELEV.	FIELD BOOK #:
POSTED TO LBIS	

NO.	REVISIONS	DATE	BY
01	ISSUED FOR TENDER	15/02/08	REW

KGS GROUP CONSULTING ENGINEERS & PROJECT MANAGERS

CH2MHILL

DESIGNED BY	DDW	CHECKED BY	REW
DRAWN BY	GCN	APPROVED BY	.
HOR. SCALE	N.T.S.	RELEASED FOR CONSTRUCTION	
VERTICAL	.		
DATE	19/01/07	DATE	

ENGINEER'S SEAL — PROVINCE OF MANITOBA — R.E. WILLMS — REGISTERED PROFESSIONAL ENGINEER

TENDER No: 25-2008
FILENAME : 1-0101P-E0027-001
PLOT DATE : 15/02/08

Winnipeg

THE CITY OF WINNIPEG
WATER AND WASTE DEPARTMENT

NORTH END WATER POLLUTION CONTROL CENTRE
MOTOR STARTER
P610-2PF28
SUMMER EXHAUST FAN 2 CLARIFIERS 4 & 5

SHEET 001 OF 001

CITY DRAWING NUMBER
1-0101P-E0027-001