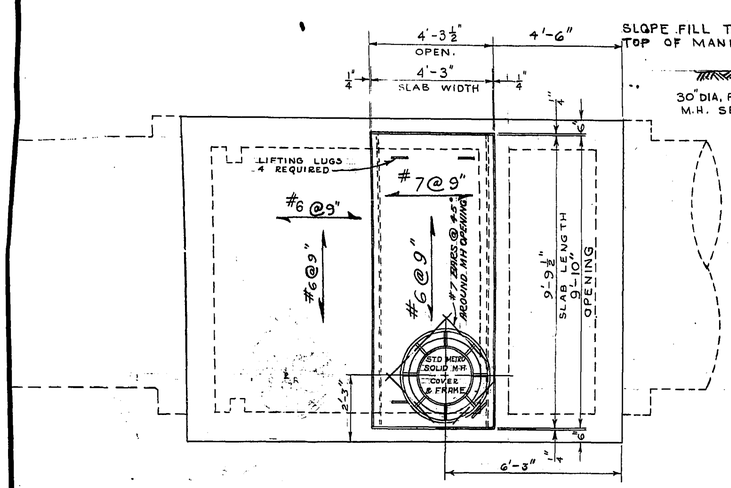

PLAN

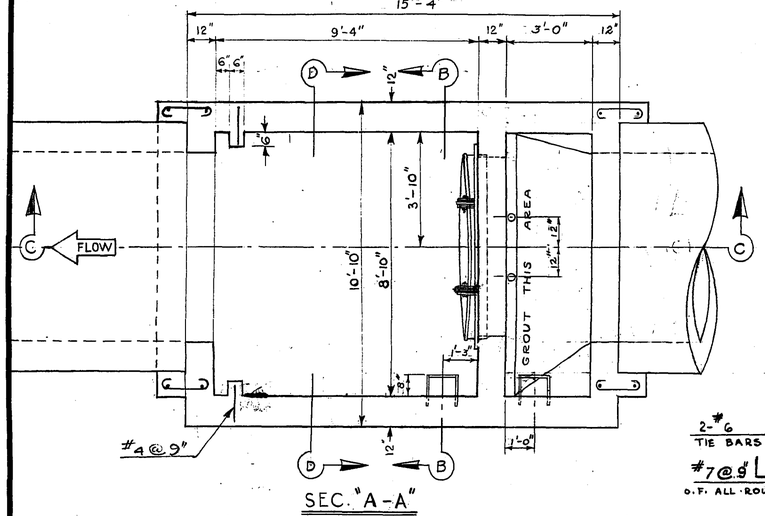

SEC. "A-A"

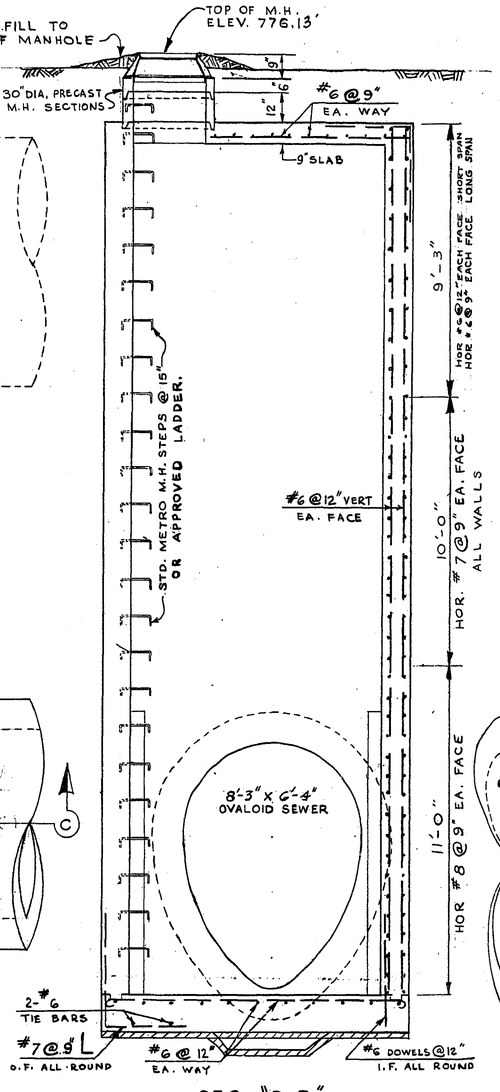

SEC. "B-B"

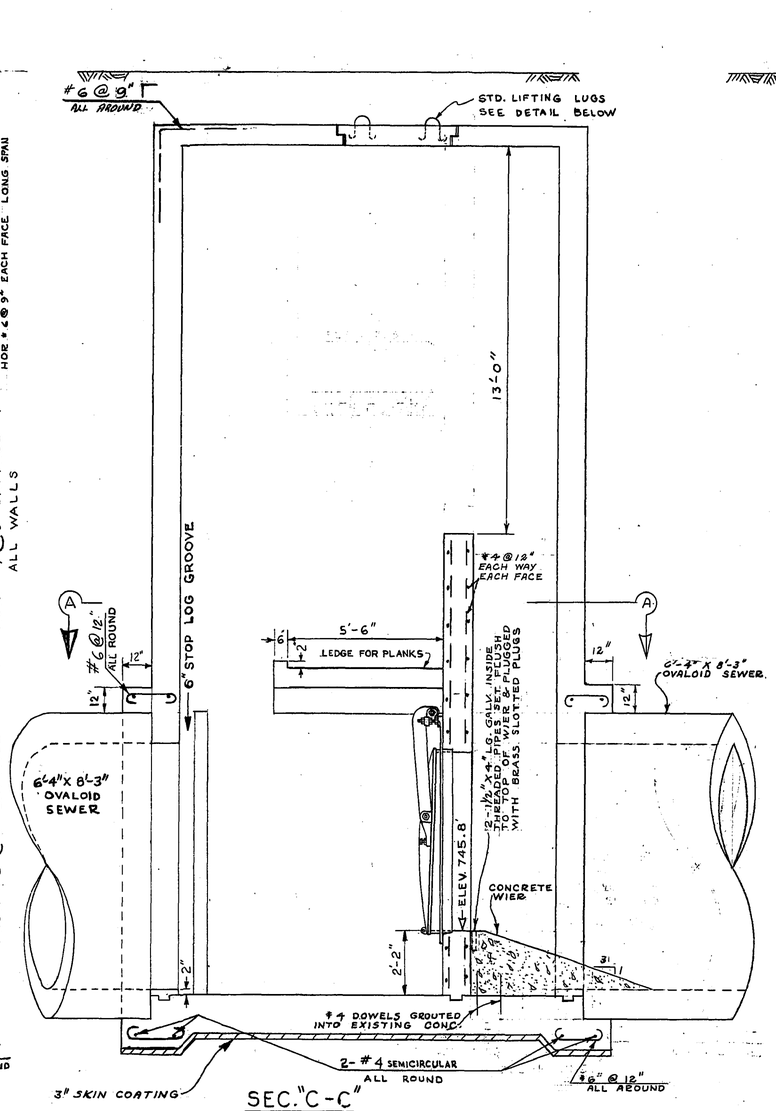

SEC. "C-C"

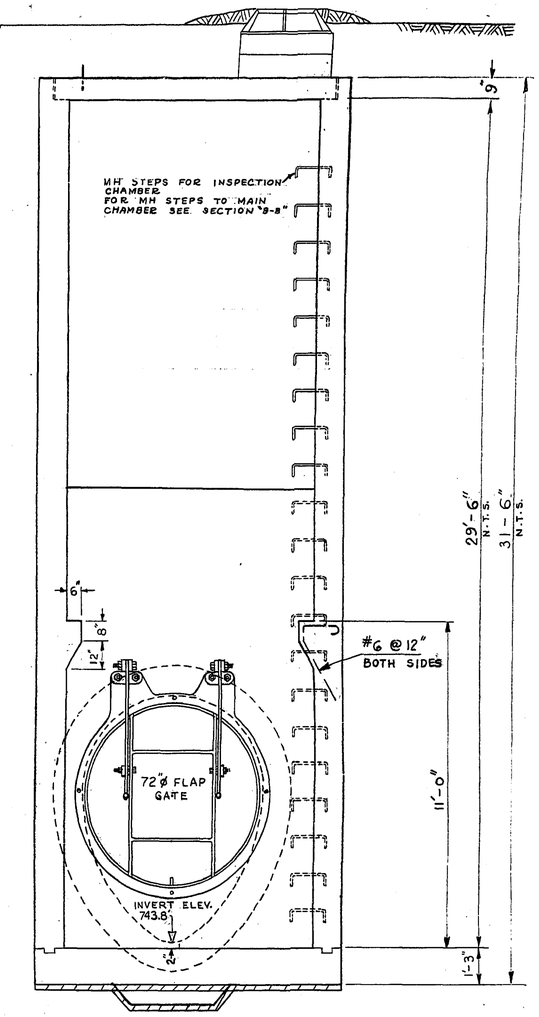

SEC. "D-D"

1. SEAL ALL JOINTS OF REMOVEABLE SLAB WITH HOT PITCH.
2. HOT GALVANIZE ALL MISCELLANEOUS IRON WORK.

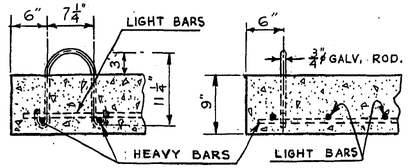

STANDARD LIFTING LUG DETAIL

SCALE 1"=1'-0"

AS BUILT MAR. 1971 V.O.

PROVINCE OF MANITOBA — M. W. SLEZAK — REGISTERED ENGINEER

PROVINCE OF MANITOBA — G. E. BURNS — REGISTERED ENGINEER

REVISIONS			
NO.	DESCRIPTION	DATE	BY
1			
2			
3			
4			
5			
6			
7			
8			

THE METROPOLITAN CORPORATION OF GREATER WINNIPEG
WATERWORKS & WASTE DISPOSAL DIVISION
SEWAGE DISPOSAL BRANCH

ST. JAMES INTERCEPTOR CONWAY GATE CHAMBER

APPROVED BY	DESIGNED BY	CHECKED BY	DRAWING NO.
CHIEF ENGINEER	DRAWN BY HB	DATE MAR 1963	445
	SCALES ⅜"=1'-0"		

Micro Filmed 1966