



FILE NAME: 757-2008-M07-R1  
 DATE: 2008.08.31  
 DESCRIPTION: HYDRONIC SCHEMATICS  
 PROJECT No.: 105111  
 ADDRESS: 457 MAIN STREET

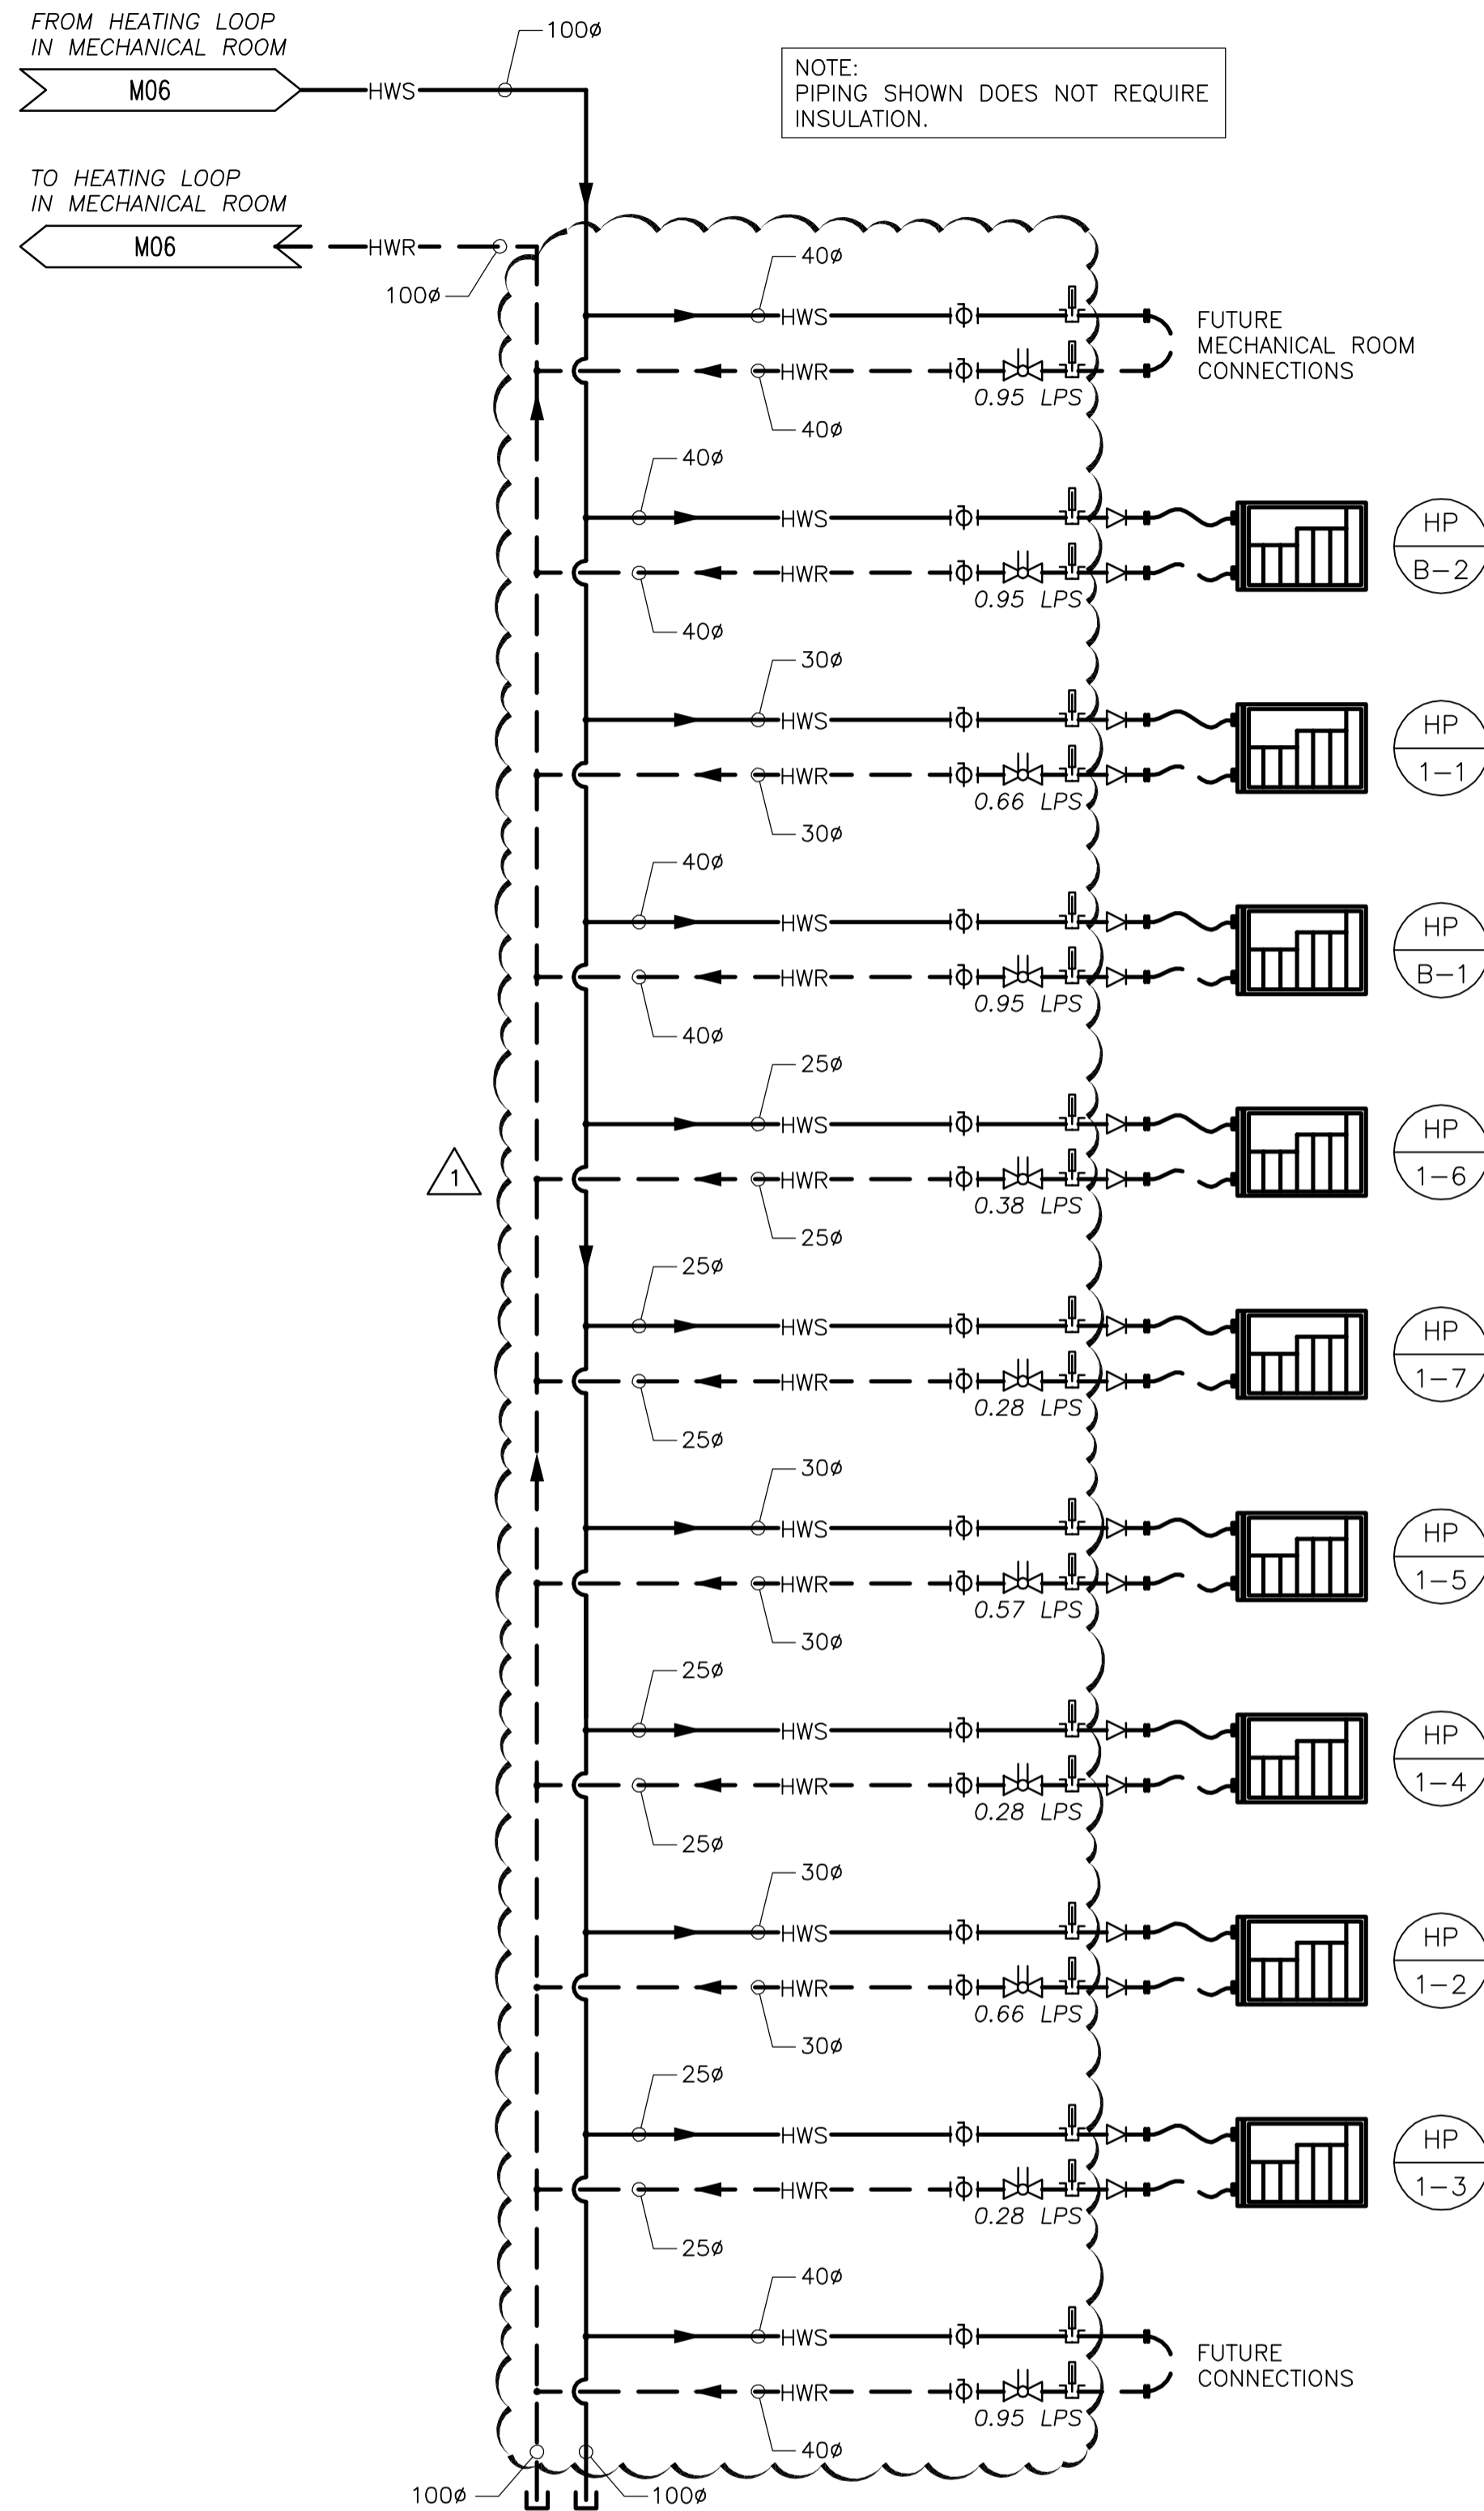

**BASEMENT & MAIN FLOOR HEATING LOOP**  
 SCALE: NTS

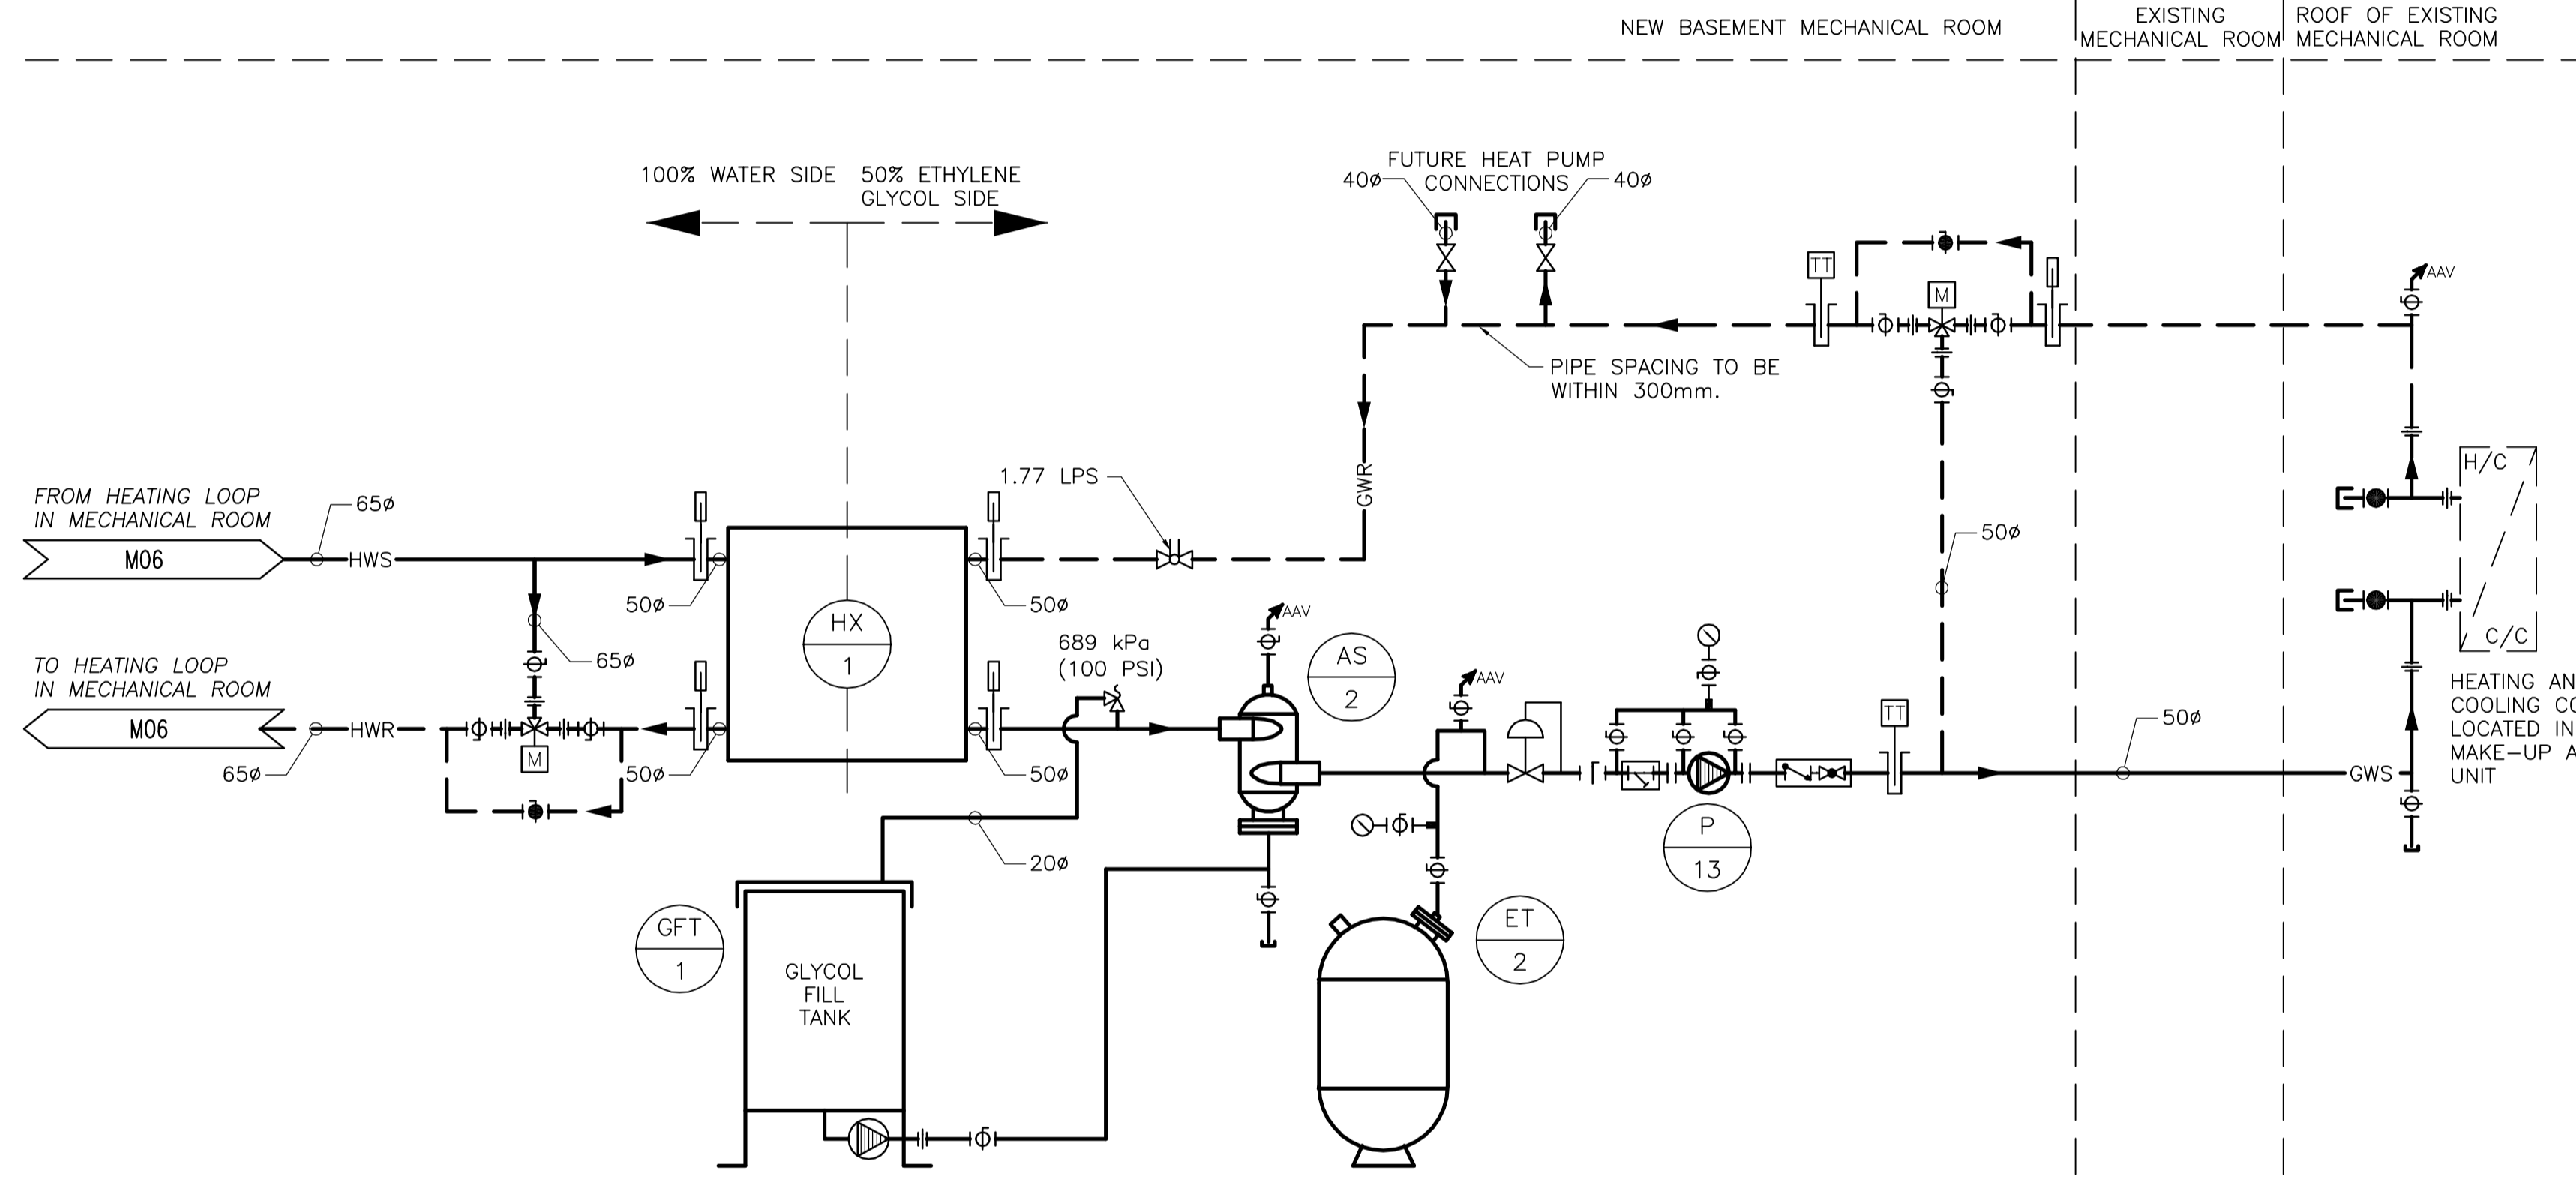

**MAKE-UP AIR PRE-HEAT/COOLING LOOP**  
 SCALE: NTS

NOTES :

**GENERAL NOTES**

- DCW IS CONTINUOUSLY BEING FED TO FLUID COOLER WATER TANK; CONTROLLED BY FLOAT VALVE IN WATER TANK.
- THIS AS-BUILDING WAS DONE DURING "SUMMER" SEASON.

NO.	REVISION/DESCRIPTION	BY	DATE
1	ISSUED FOR ADDENDUM NO. 2		2008.12.12
0	ISSUED FOR TENDER		2008.11.28

**EARTH TECH | AECOM**

DRAWN BY	DATE	CHECKED BY	PVL	APPROVED	PVL
	2008.08.31				

**Winnipeg** CITY OF WINNIPEG  
 PLANNING, PROPERTY AND  
 DEVELOPMENT DEPARTMENT  
 CIVIC ACCOMMODATIONS DIVISION  
 300 - 65 GARRY ST. R3C 4K4

PROJECT  
 CONFEDERATION BUILDING  
 SUPPLEMENTARY HEATING UPGRADES  
 PHASE 1 - CITY BID OPP. NO. 757-2008  
 457 MAIN STREET, WINNIPEG, MANITOBA

SHEET TITLE  
**HYDRONIC SCHEMATICS**  
**BASEMENT & MAIN FLOOR HEATING LOOP**  
**MAKE-UP AIR PRE-HEAT/COOLING LOOP**

SCALE	PROJECT NO.	SHEET NO.
AS SHOWN	105111	M07



**APEGM**  
 Certificate of Authorization  
 Earth Tech Canada Inc.  
 No. 730 Expiry: April 30, 2009

**AECOM**  
 © 2008 EARTH TECH (CANADA) INC. ALL RIGHTS RESERVED.  
 THIS DOCUMENT IS PROTECTED BY COPYRIGHT LAW AND MAY NOT BE USED, REPRODUCED OR MODIFIED IN ANY MANNER OR FOR ANY PURPOSE EXCEPT WITH THE WRITTEN PERMISSION OF EARTH TECH (CANADA) INC. DOING BUSINESS AS AECOM (AECOM) OR A PARTY TO WHICH ITS COPYRIGHT HAS BEEN ASSIGNED. AECOM ACCEPTS NO RESPONSIBILITY, AND DENIES ANY LIABILITY WHATSOEVER, TO ANY PARTY THAT USES, REPRODUCES, MODIFIES, OR RELIES ON THIS DOCUMENT WITHOUT AECOM'S EXPRESS WRITTEN CONSENT.