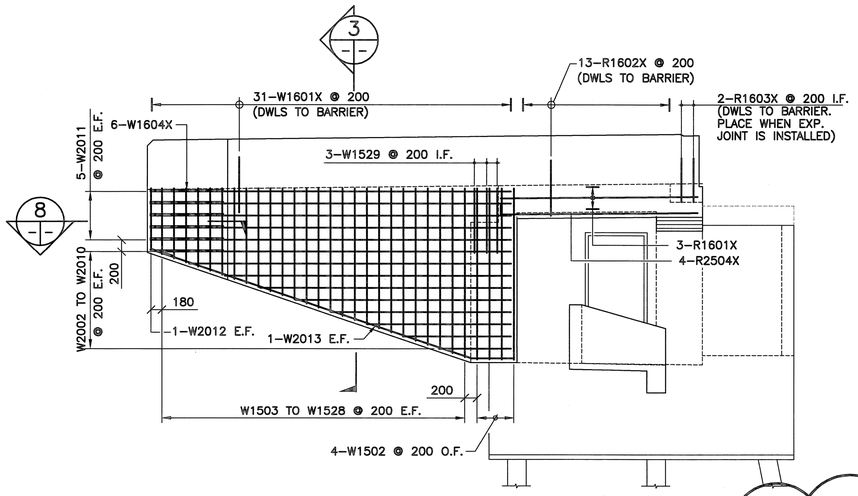

1 / 12|13 SOUTH WINGWALL ELEVATION
1 : 50

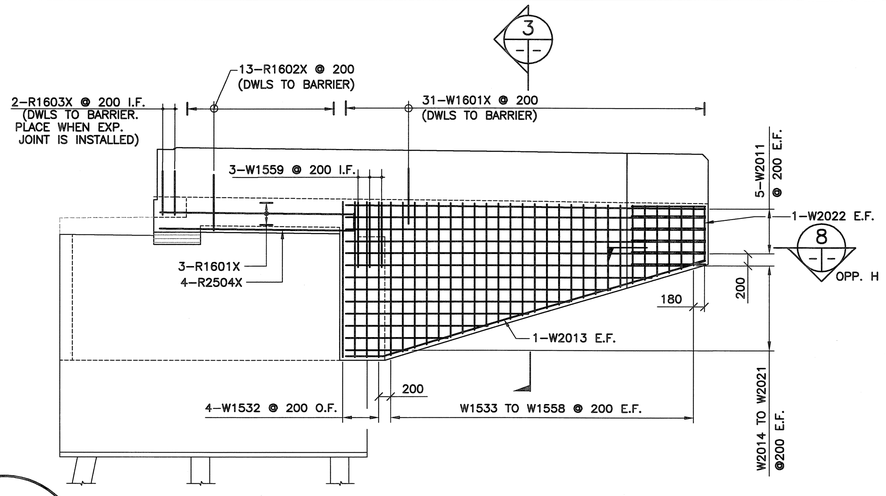

2 / 12|13 NORTH WINGWALL ELEVATION
1 : 50

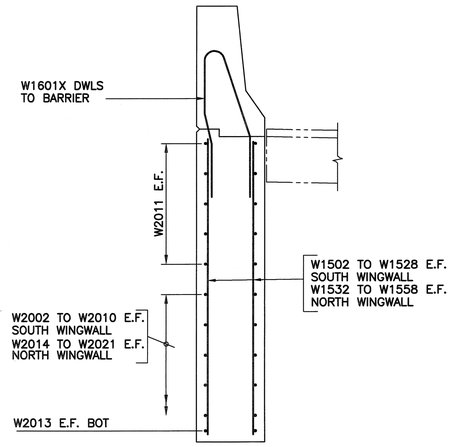

3 / –|– SECTION
1 : 20

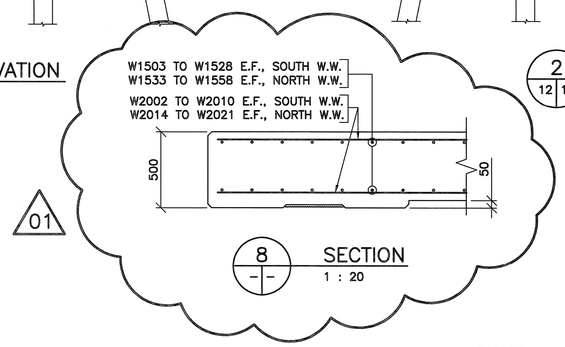

8 / –|– SECTION
1 : 20

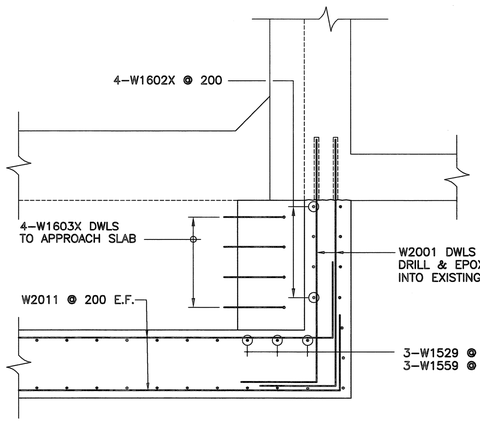

4 / –|– SECTION
1 : 20
TYP AT EACH SIDE

NOTE
BARS NOT CALLED UP HERE
REMAIN SAME AS SECTION 5

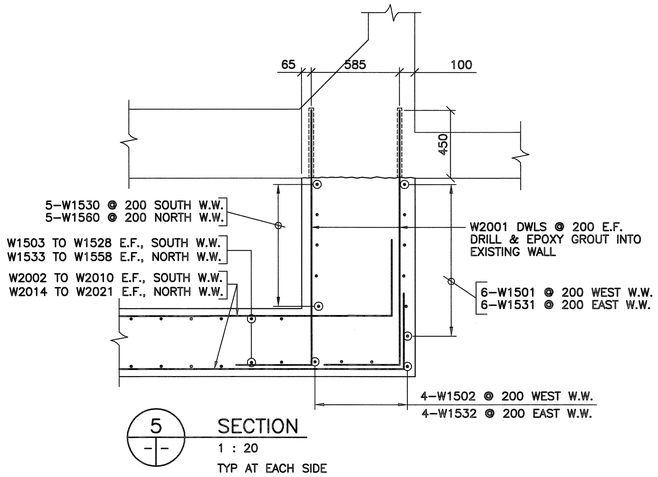

5 / –|– SECTION
1 : 20
TYP AT EACH SIDE

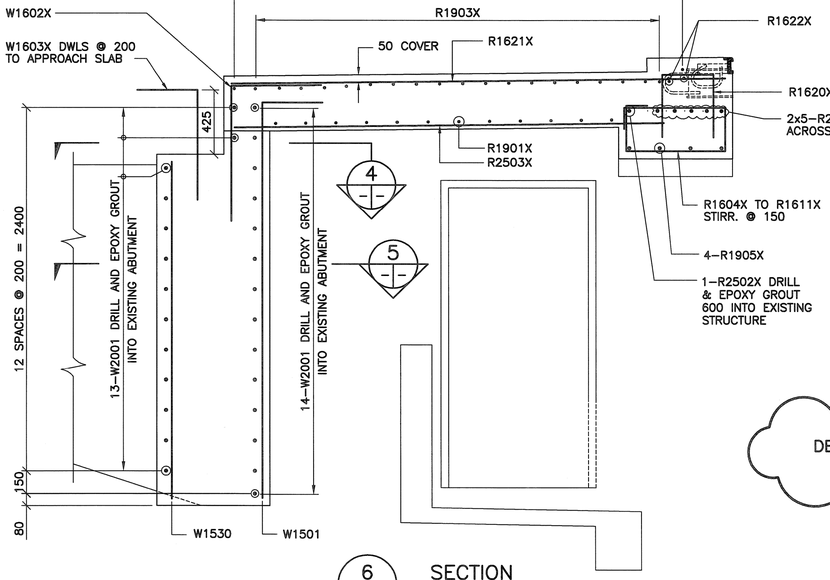

6 / 12|13 SECTION
1 : 20

DELETE NOTE
01

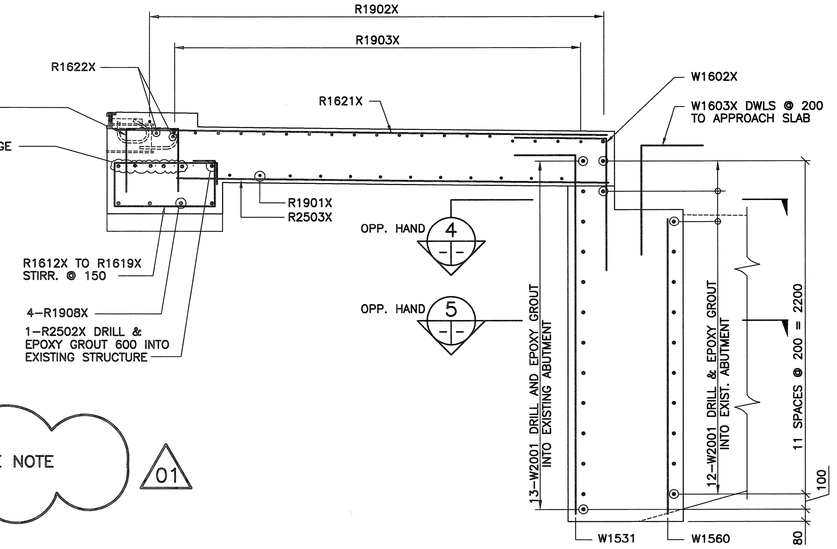

7 / 12|13 SECTION
1 : 20

APEGM
Certificate of Authorization
Wardrop Engineering Inc.
No. 195 Expiry: April 30, 2006

NO.	REVISIONS	DATE	BY
01	ISSUED FOR ADDENDUM #2	08.03.05	
00	ISSUED FOR TENDER	08.02.05	E.F.S.

B.M. ELEV. F.B.

WARDROP | Engineering Inc.

DESIGNED BY E.F.S. | CHECKED BY
DRAWN BY P.S. | APPROVED BY
HOR. SCALE: AS NOTED | ACCEPTED BY | DATE
VERTICAL:
DATE 08.02.05
RANDY FINGAS, P. ENG
BRIDGES PROJECTS ENGINEER

ORIGINAL DRAWING
REVISION "00" SEALED BY
E.F. SHEHATA
08.02.05

CONSULTANT DRAWING NO.
0600070700-DWG-S1113-00

Winnipeg

THE CITY OF WINNIPEG
PUBLIC WORKS DEPARTMENT
TRANSPORTATION ENGINEERING DIVISION

FORT GARRY TWIN BRIDGES
WESTBOUND STRUCTURE REHABILITATION
AND ASSOCIATED ROADWORKS

CITY DRAWING NUMBER
B173-08-013W

SHEET 13 OF 54

WEST ABUTMENT
REINFORCING DETAILS 2

13