



DEFECT MAPS


APPENDIX B

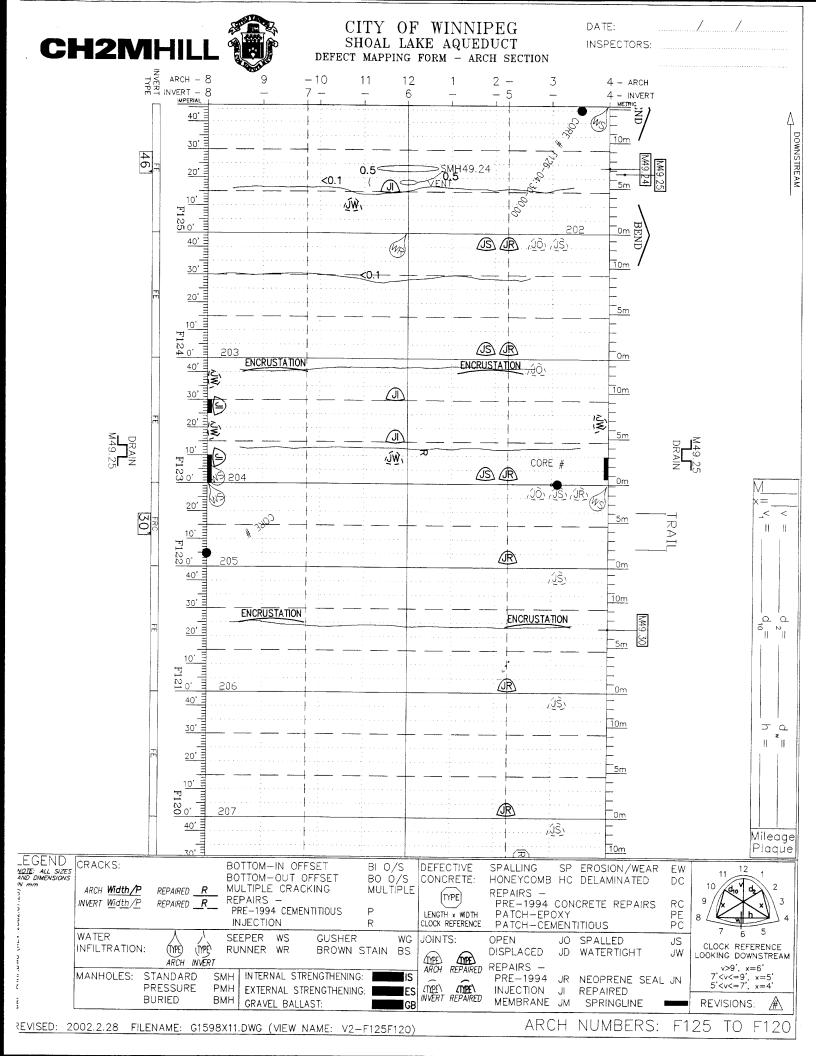


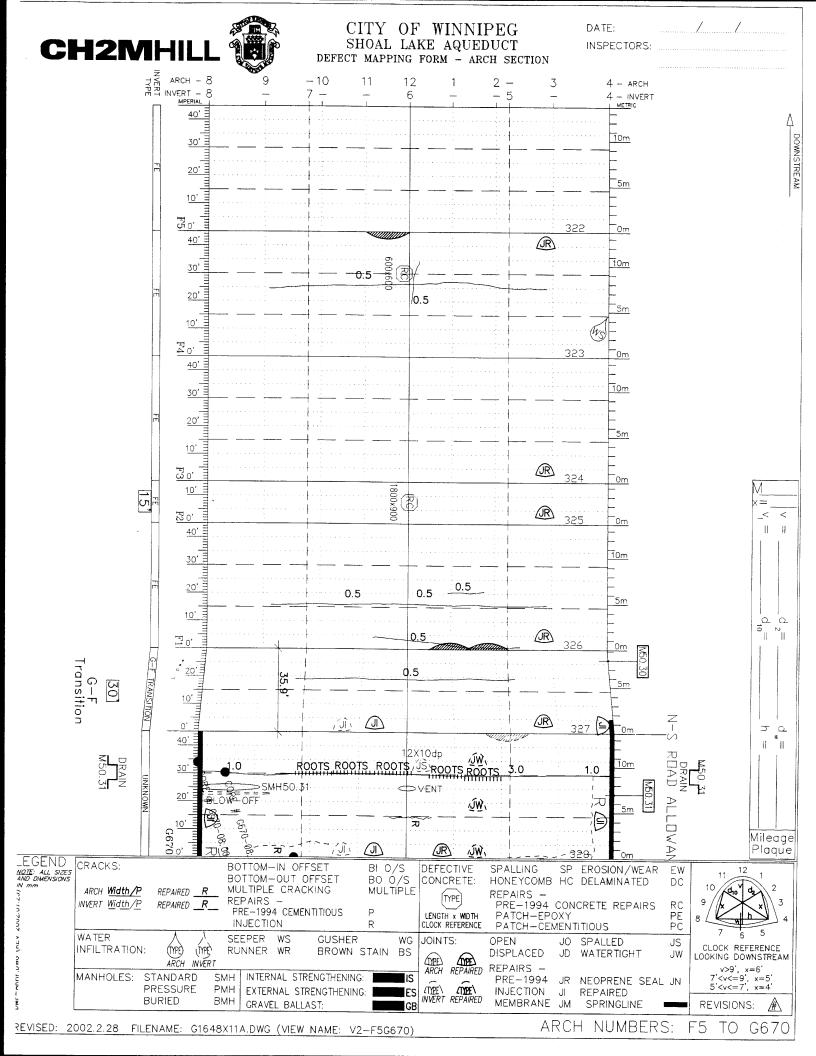

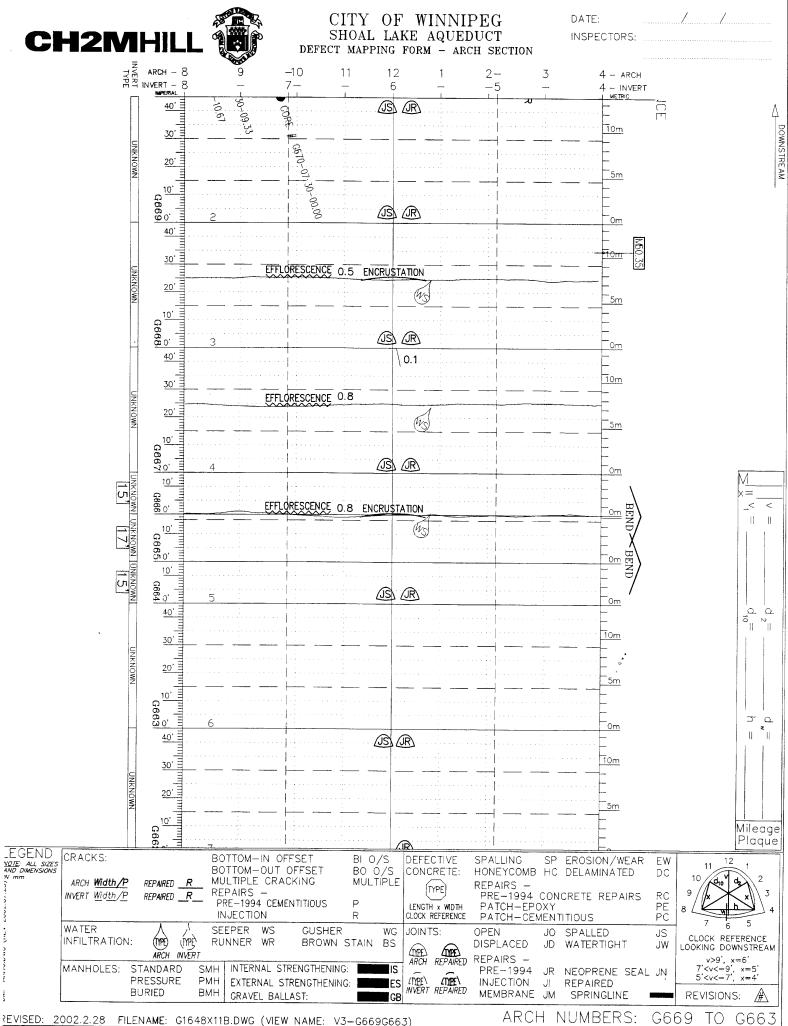


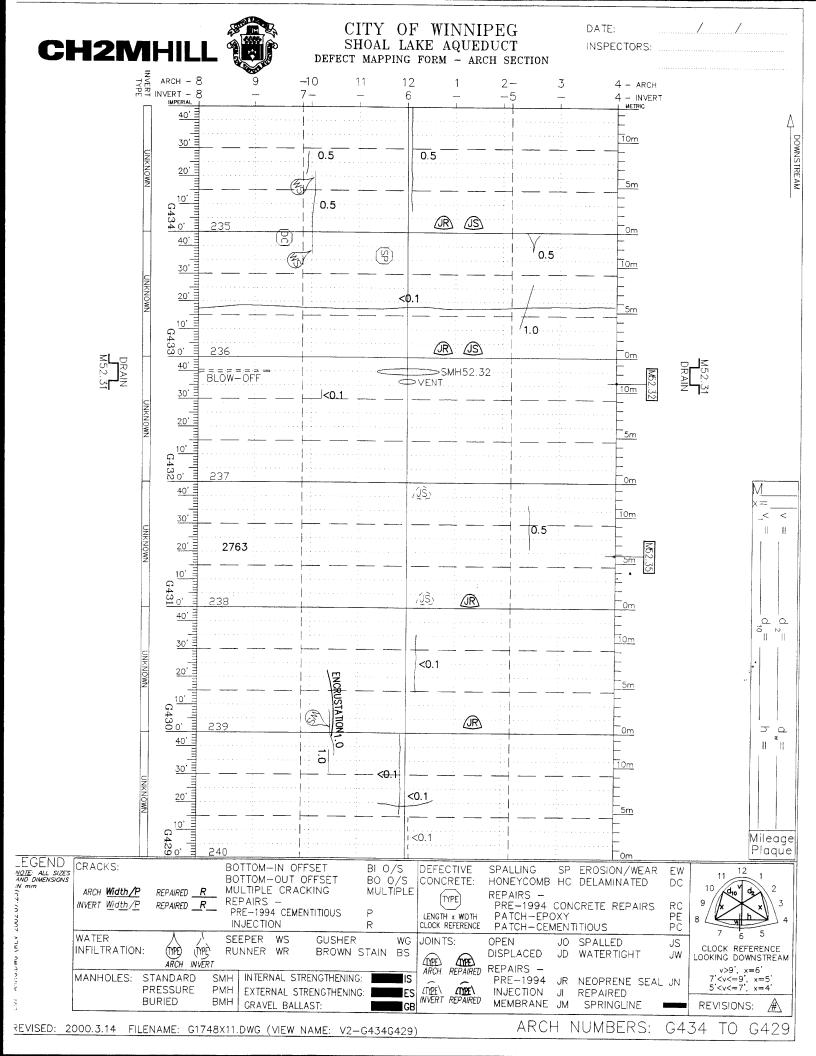


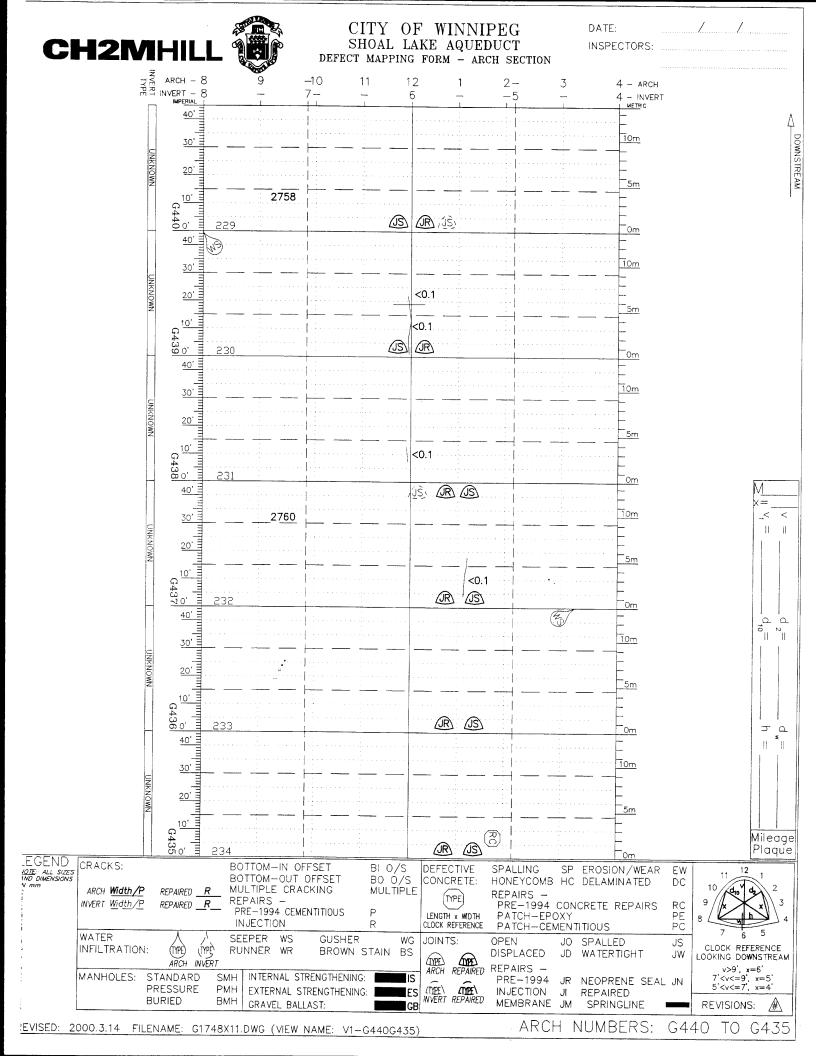


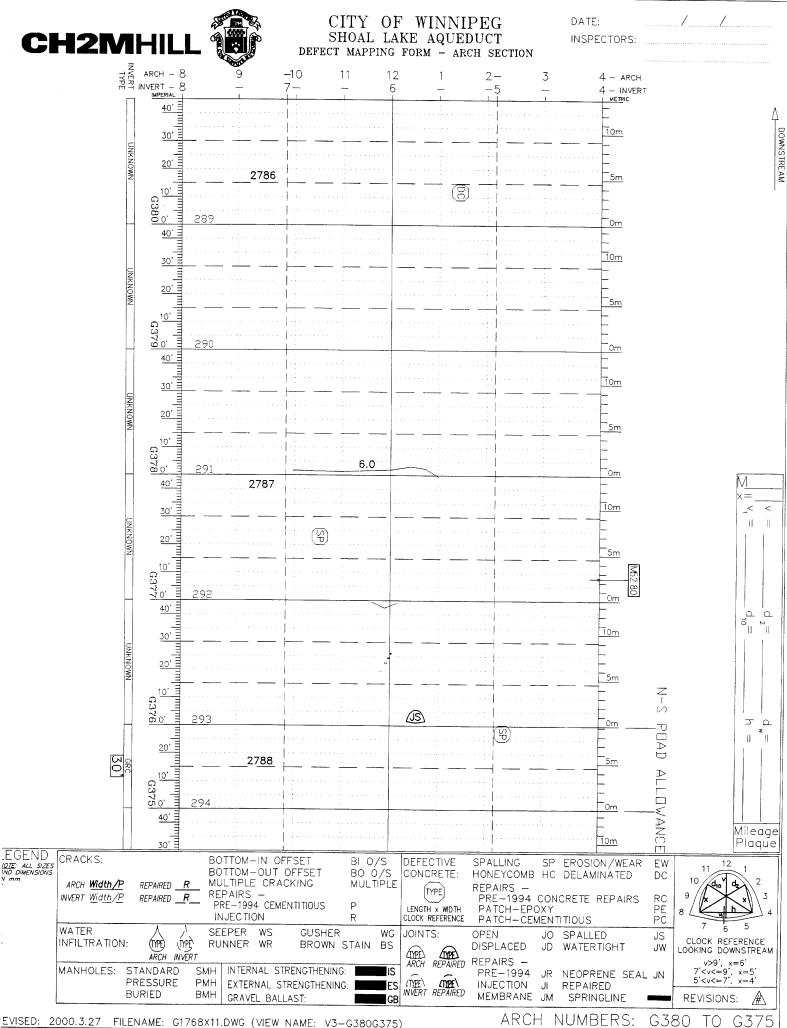


EVISED: 2000.3.27 FILENAME: G1768X11.DWG (VIEW NAME: V3-G380G375

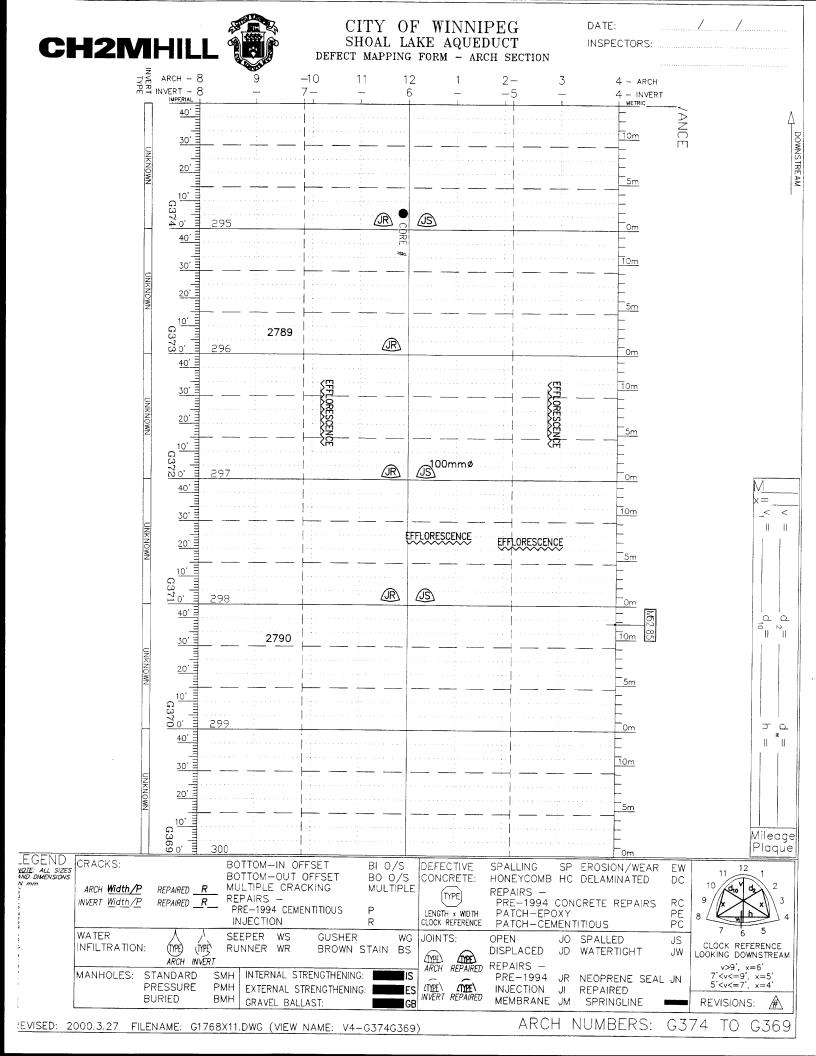


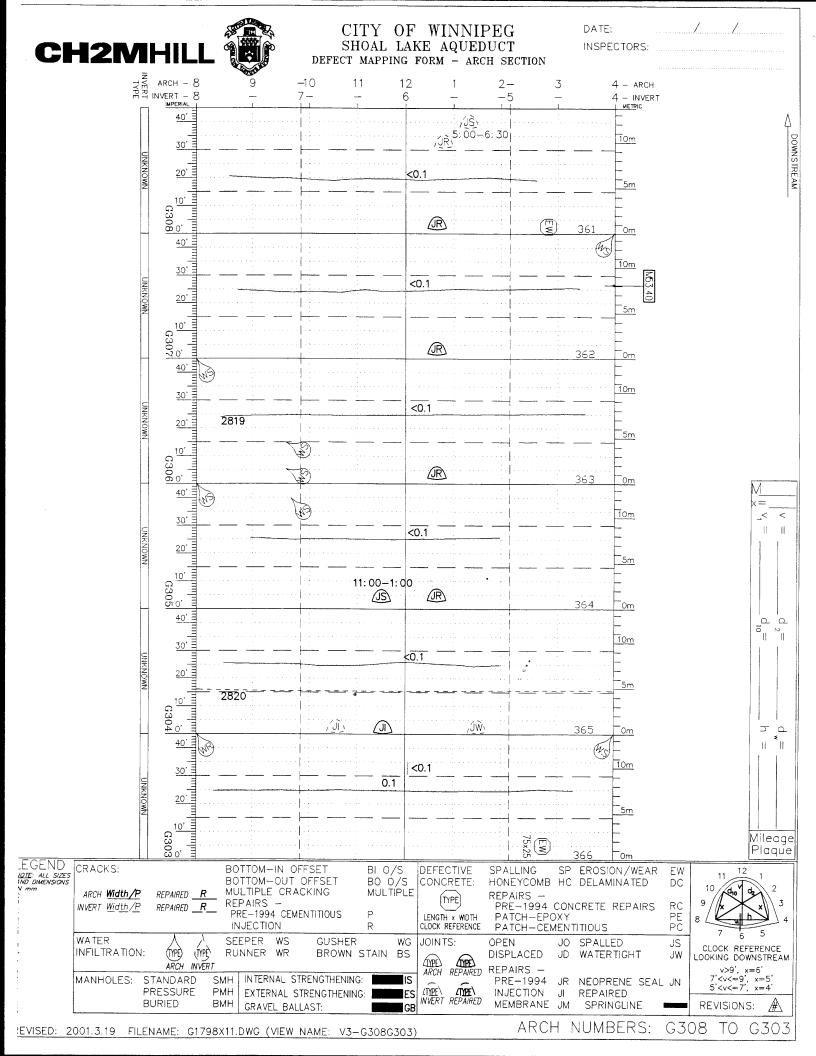

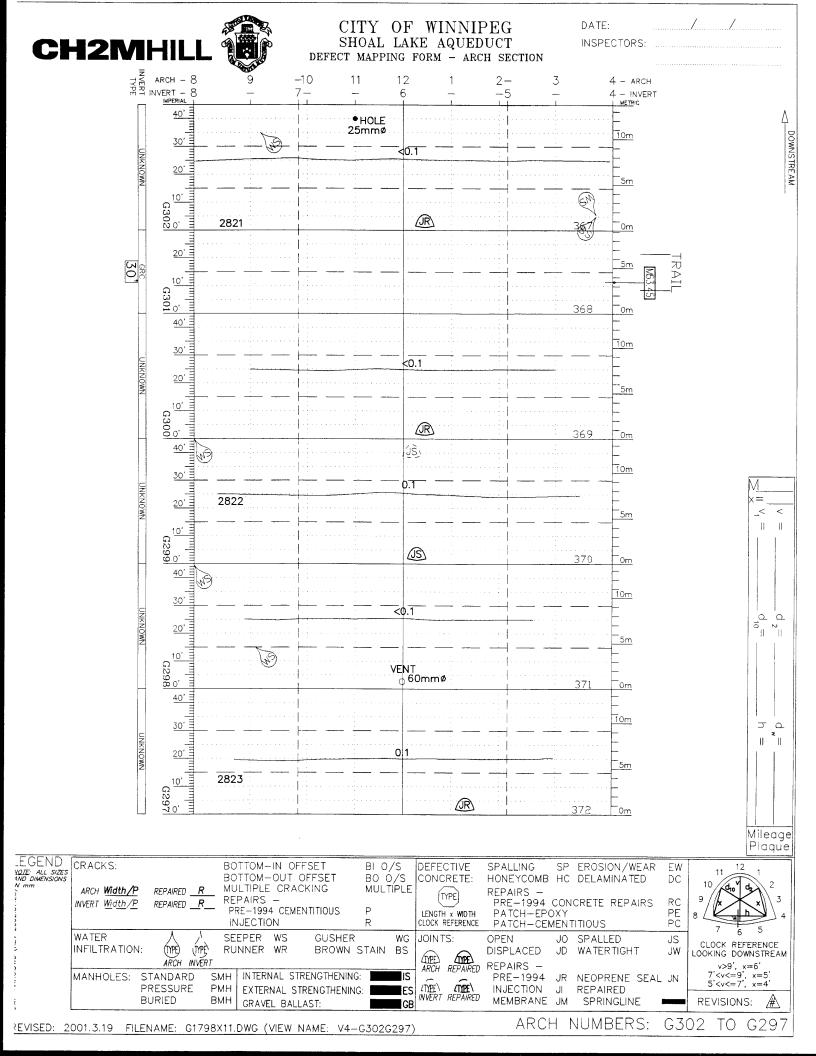


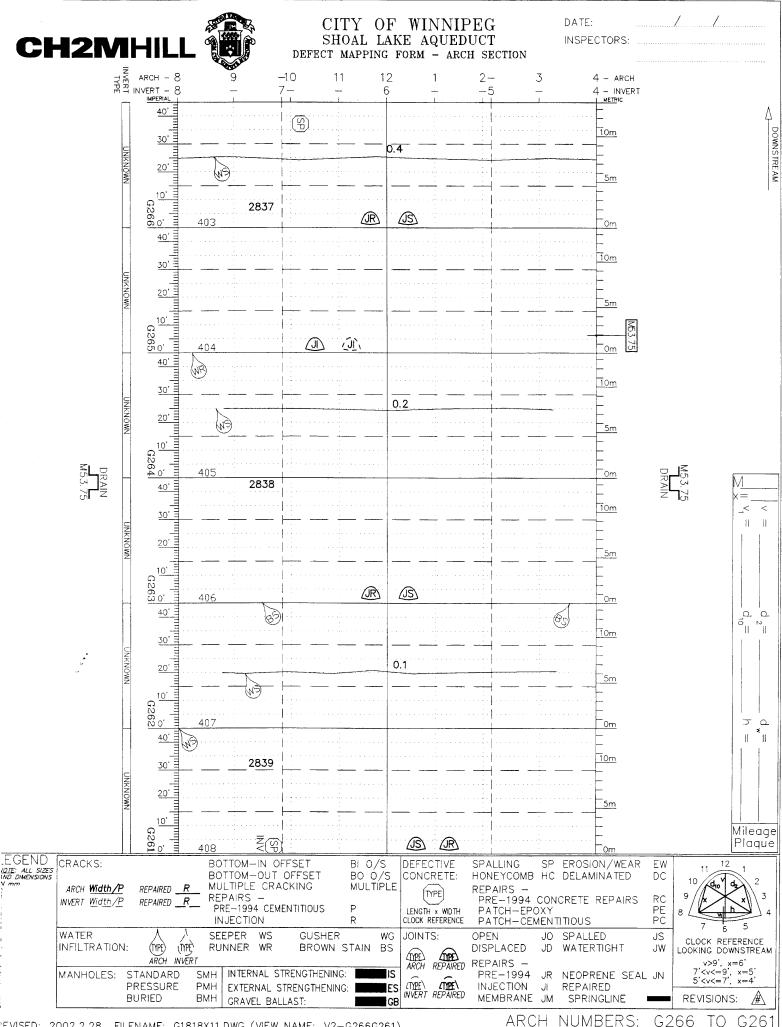


'EVISED: 2002.2.28 FILENAME: G1818X11.DWG (VIEW NAME: V2-G266G261)

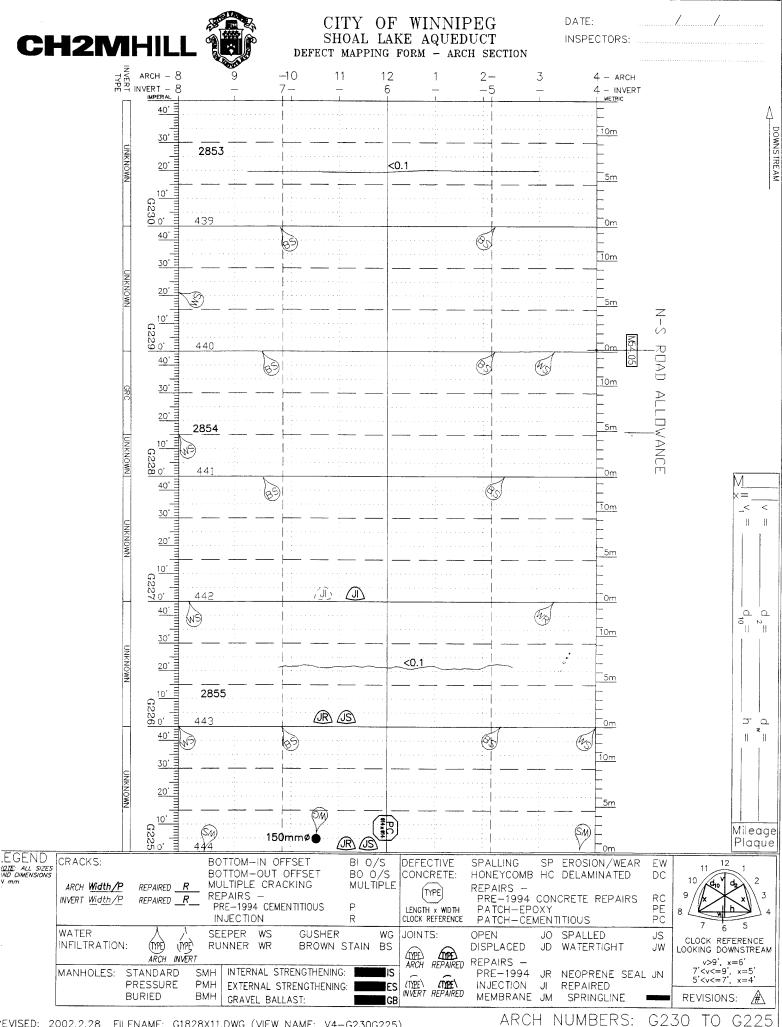



'EVISED: 2002.2.28 FILENAME: G1828X11.DWG (VIEW NAME: V4-G230G225 NUMBERS:

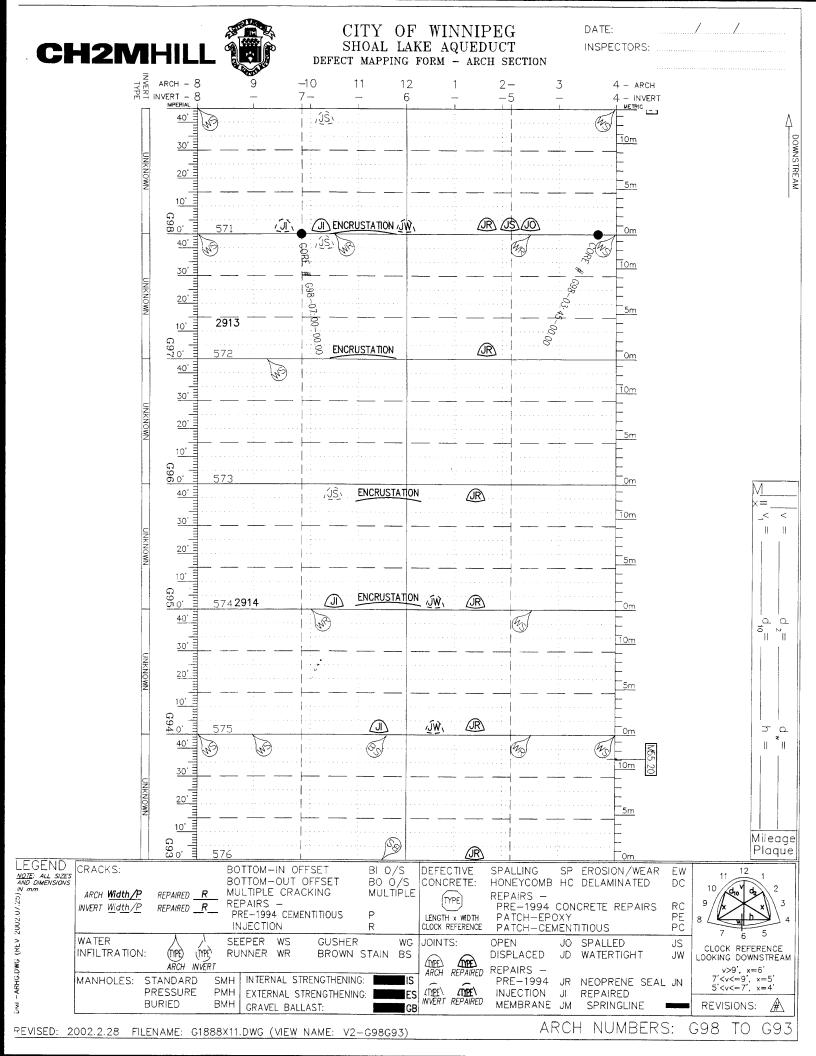

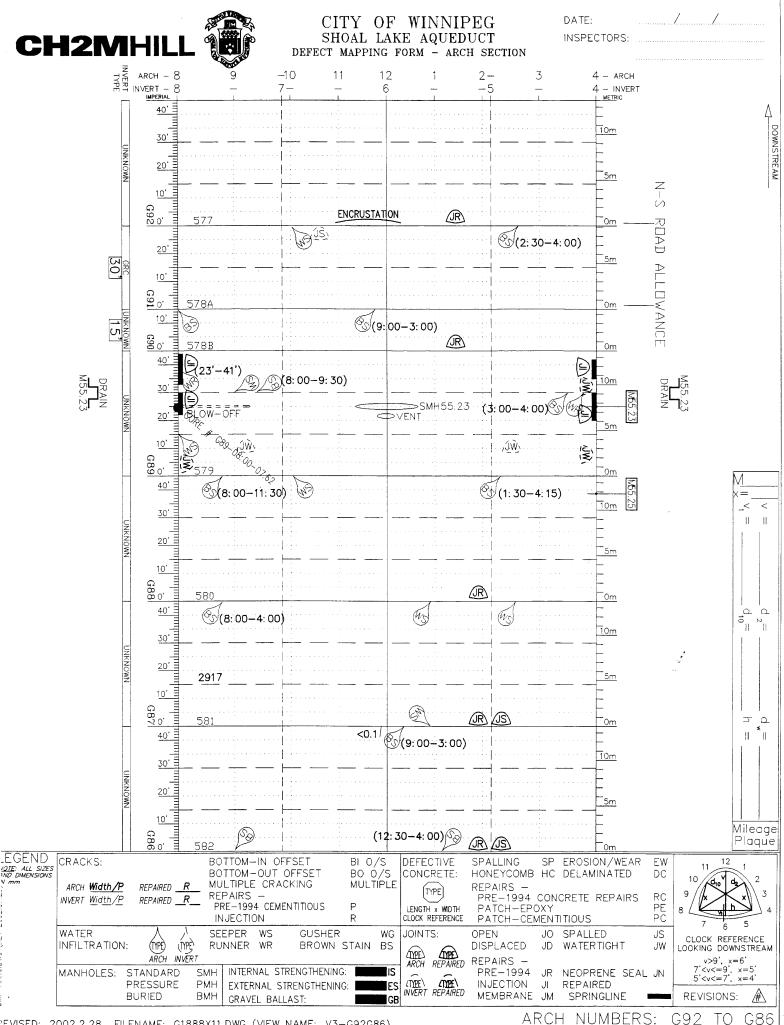

'EVISED: 2002.2.28 FILENAME: G1888X11.DWG (VIEW NAME: V3-G92G86

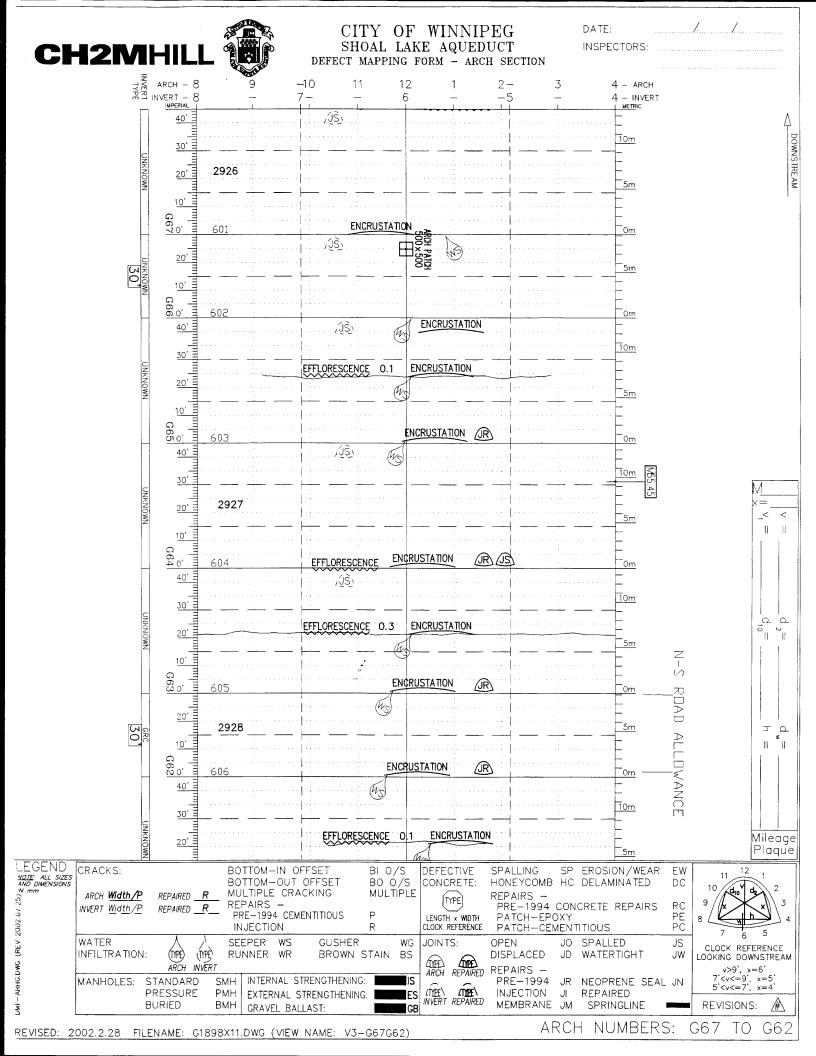

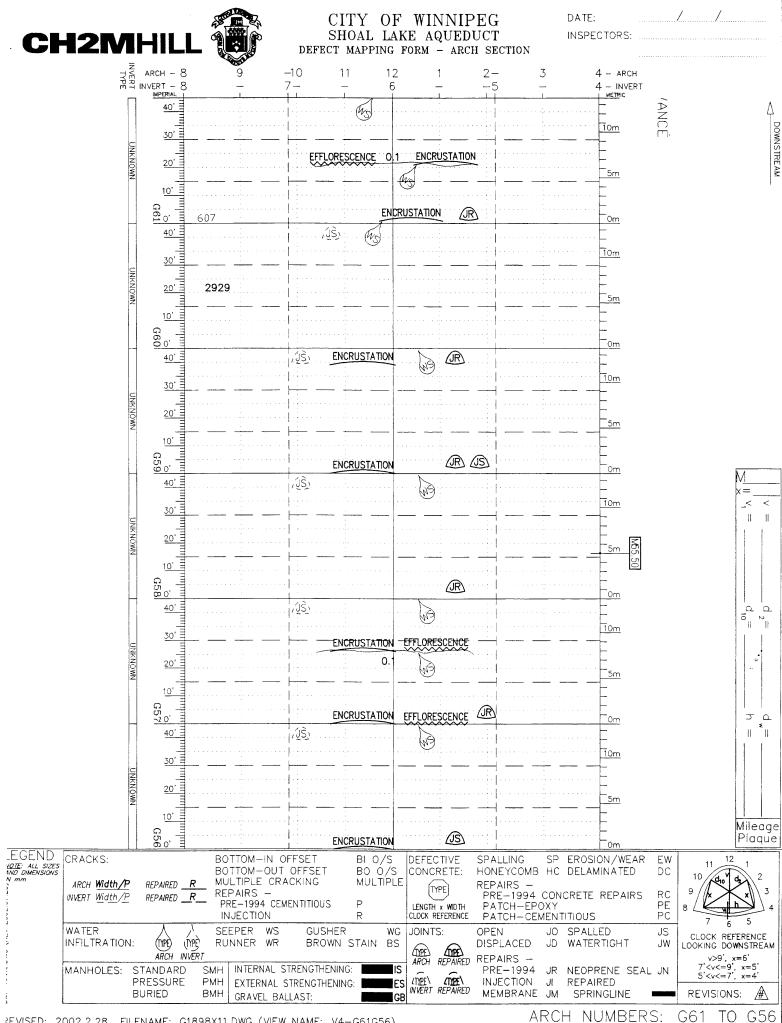

REVISED: 2002.2.28 FILENAME: G1898X11.DWG (VIEW NAME: V4-G61G56