

0723201.dwg

FILE NAME:

DATE:

DESCRIPTION:


PROJECT No: 07-232-01

ADDRESS:

NOTES :

DRAWING NOTES

- BREAKER TAGGED AS 'LIEBERT POWER CENTRE #9' 7TH FLOOR COMPUTER ROOM, SHOULD BE TAGGED 'CDP 800'. THIS BREAKER TO BE REUSED TO FEED NEW 1000A ATS. RE-LABEL AS FEED TO L7-ATS01.

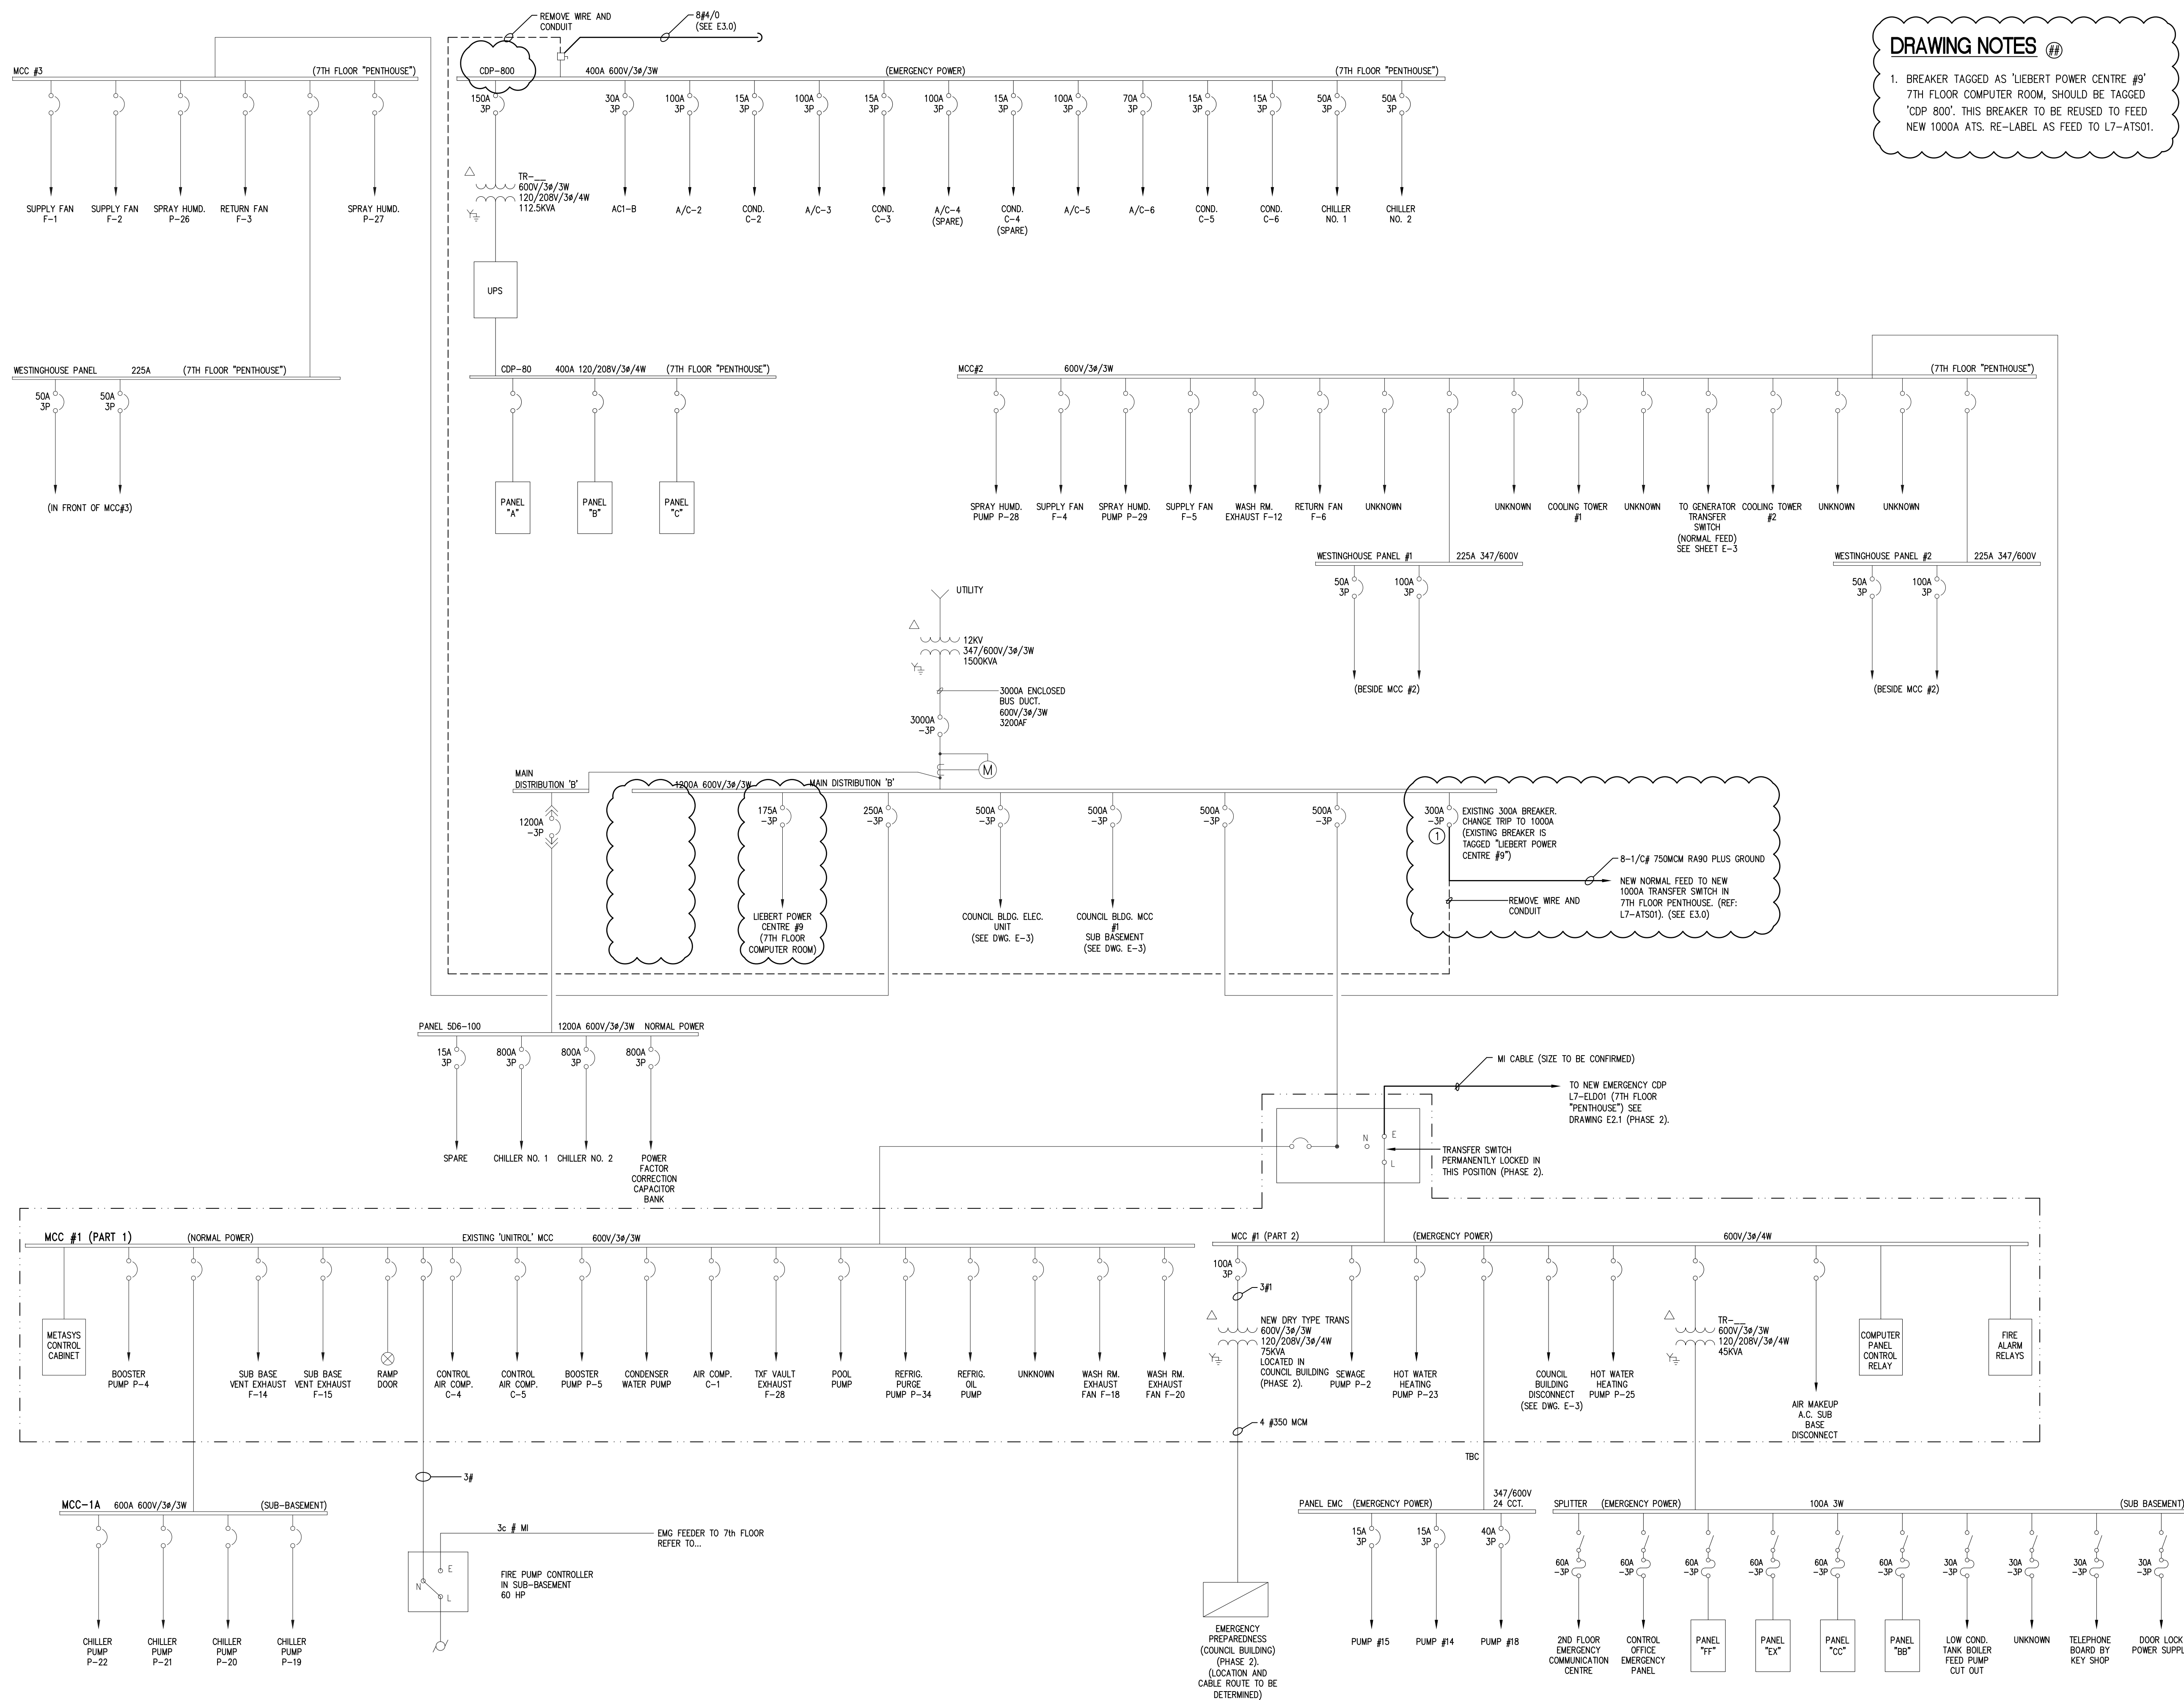

SMS ENGINEERING
 SMS Engineering Ltd. Consulting Engineers
 270 Brandon Street Winnipeg MB Canada R3H 0K3
 Telephone 204.775.0291 Fax 204.772.2153
 sms@smseng.com

07-232-01

NO.	REVISION/DESCRIPTION	BY	DATE
2.	ISSUED FOR ADDENDUM NO. 2	CB	09.07.27
1.	ISSUED FOR BID OPPORTUNITY	CB	09.06.19



DRAWN BY: KM CHECKED BY: CR APPROVED CH: [Signature]
 DATE: 2008/04/17 USER APPROVAL

CITY OF WINNIPEG
 PLANNING, PROPERTY & DEVELOPMENT DEPARTMENT
 CIVIC ACCOMMODATIONS DIVISION
 300 - 65 GARRY ST. R3C 4K4

PROJECT
 CITY OF WINNIPEG 510 MAIN ST.
 EMERGENCY DISTRIBUTION UPGRADE
 PHASE 1

SHEET TITLE
 NEW SINGLE LINE DISTRIBUTION
 OF NEW EMERGENCY
 SYSTEM UPGRADE

SCALE AS SHOWN PROJECT NO. PHASE 1 SHEET NO. E3.1

DRAWING SHEET SIZE: A1 (841mm x 594mm) PLOT 1:1